



City of Reno
Purchasing Division
P.O. Box 1900
Reno, NV 89505

March 16, 2016

RFP 030118– Microfilm to Digital Image Conversion & Indexing Project

All potential participants: Please note that for your qualifications to be considered, you must sign and attach this addendum to your response. Failure to do so may be cause for disqualification of your response.

Additional Information

Question # 1

Whether companies from outside USA can apply for this?(like, from India or Canada) Please see RFP page 20, Attachment A, paragraph 4.

Question # 2

Whether we need to come over there for meetings? At this time, we do not have any meetings scheduled that would require your presence.

Question # 3

Can we perform the tasks (related to RFP) outside USA?(like, from India or Canada) Please see RFP page 20, Attachment A, paragraph 4.

Question # 4

Can we submit the proposals via email????? No, we will not accept proposals submitted via email.

Question # 5

Is it mandatory to submit a bond along with the RFP? Please see RFP page 16, item 7 – Bonds Required.

Question # 6

Is the request for film from the City during the project to be satisfied within 2 business days for the physical film/fiche or images created from the film/fiche? Should a public records request be given to the City during this project and the winning bidder is in possession of the physical film/fiche, we would need to have the image created from the film/fiche in our possession within 2 business days.

Question # 7

Please confirm that the 500 rolls of 16 & 35mm film held by the City Clerk department are to be included in this project. Yes, the City Clerk's film is also included in this project.

Question # 8

Please confirm whether the 500 boxes from the City of Reno Police department are to be included in this project. Yes, the approximate 500 boxes from the City of Reno's Police department is also included in this project.

Question # 9

Are the 500 boxes from the City of Reno Police department 500 boxes of a single microfilm, or 500 boxes containing multiple microfilm? *The approximate 500 boxes from the City of Reno Police Department contains multiple jackets of microfiche.*

Question # 10

Is there an expected dpi required for the images? *200 DPI for text, in a TIF format, is the minimum. For images, like plans for Community Development, you will want to go to 400 DPI, but still a TIF format.*

Question # 11

What is the anticipated start date upon award of contract? *Once the contract has been award by the City Council, we would like the project to start as soon as possible.*

Question # 12

The RFP does not specify time to complete project, is the expectation that this will be provided by the bidder as part of their response to the RFP? *Please see RFP page 20, Attachment A, last sentence.*

Question # 13

Is delivery of output images restricted to CD, or can a HDD be provided instead? *Any readable physical media such as CD, DVD, USB drive or HDD would be acceptable.*

Question # 14

Can an image example of be provided to help determine index field requirements? *See attached example of indexing and example of a converted file.*

Question # 15

Are the 7 listed index field listed expected on each document? *No, there are different index fields required for different departments. See attached example of indexing.*

Question # 16

Would it be possible to arrange for an onsite visit to inspect the film prior to submitting questions or a response? *No, the film is not available to inspect prior to bidding.*

Question # 17

Can the film be shipped via FedEx or UPS? *No, please see RFP page 20, Attachment A, first paragraph.*

Question # 18

Could you provide a breakout of 16mm and 35mm for the Community Development Department, City Clerk and City Police Department? *The amount is unknown.*

Question # 19

Could you provide a rough estimate of: a. The number of documents for each department b. The number of images for the City Clerk and City Police Department. *We estimate that there are close to 2,000,000 images for the entire project.*

Question # 20

Where can we find the Pricing Schedule to enter our costs? *Page 22 of 23, please add additional pages if needed.*

Question # 21

What bitonal file format are the converted images to be? *Please see RFP page 23 Output Image – Technical Requirements – Last sentence*

Question # 22

Are the images to be single page images or multi-page images? *We would like multi-page images, see attached example of a scanned file.*

Question # 23

Is the microfiche for the PD 5 channel microfiche jackets? *We do not know if the microfiche is 5 channel jackets, we just know that it is jackets.*

Question # 24

Will the vendor be able to pick up all of the microfilm from the three departments at the same time? *Yes, as long as we are informed in advance so we can have the film ready.*

Question # 25

On page 22 of 23 of the RFP #030118, Conversion Requirements (Minimum) are line item spaces for various cost estimates for the project. However, there are no line item spaces for the actual conversion (scanning) of the various microforms; 16mm roll microfilm, 35mm roll microfilm, and the various types of microfiche. Where are these line items to be entered? *Please attach additional pages as needed.*

Question # 26

On page 22 of 23 of the RFP #030118, Conversion Requirements (Minimum) what is meant by the line item "Repair digital images that may be illegible due to the poor quality of the original microfilm."? *What we intended is; should an image require repair, we ask that it be repaired and scanned to the best possible quality.*

Question # 27

On page 22 of 23 of the RFP #030118, Conversion Requirements (Minimum) what is the file name format for naming the image files as referenced in the file naming convention in Documentum Application Xtender? *See attached indexing examples.*

Question #28

On page 23 of 23 for the RFP #030118, Indexing Technical Requirements (Minimum) do these requirements apply to all of the images from the microfilm from the three different departments; the Community Development Department, the City Clerk's Department, and the City of Reno Police Department? *No, see attached indexing examples for Police, Community Development.*

Question # 29

If not, what are the indexing requirements for the images from the other departments microfilm images? *See attached examples.*

Question # 30

Are there blips, small black squares along the films edge marking each image on the 35mm rolls? *We do not know if the films are blipped.*

Question # 31

Are there blips, black squares along the films edge marking the start or end of each document on the 35mm rolls? *We do not know if the films are blipped.*

Question # 32

Are there blips small black squares along the films edge marking each image on the 16mm rolls? *We do not know if the films are blipped.*

Question # 33

Are there blips, black squares along the films edge marking the start or end of each document on the 35mm rolls? *We do not know if the films are blipped.*

Question # 34

Do you have large blips and small blips on the film or other ways known as chapter page blipping? *We do not know if the films are blipped.*

Question # 35

When you say "The City of Reno Police department has approximately 500 boxes filled with microfilm/microfiche" Are you saying that each roll is in its own roll little roll box or are you saying you have 500 boxes with many rolls in each? *The Police Department has approximately 500 boxes with many rolls/sheets in each box.*

Question # 36

Microfiche and microfilm is two different things. Microfilm being rolls and microfiche being 4 by 6 inch cards. Do you only have microfilm or do you have microfiche cards? *We have both microfilm and microfiche.*

Question # 37

If you have microfiche cards what type are they, jackets, computer generated or source? *As far as we know the microfiche cards are jackets.*

Question # 38

What approximately is the average number of images on each card? *The number of images on each card is unknown. There are approximately 2,000,000 images for the entire project.*

Question # 39

When you say "Images shall be scanned "right side up" position." Do you know if there are improperly rotated images mixed in the microforms/rolls/fiche with properly rotated images? *We do not know if there are improperly rotated images mixed with properly rotated images.*

Question # 40

Do you have negative and positive images on the same microform/roll/microfiche? *We do not know if we have negative and positive images on the same microform/roll/microfiche.*

Question # 41

When you say "Auto cropping shall remove any solid back borders that surround images, if applicable." Are you asking for a perfect crop or is a very small border acceptable to keep the cost down? *A very small border is acceptable.*

Question # 42

When you say "Index fields will be pulled from the City's current permitting software, Accela Automation with at least the following fields as appropriate:" Are you asking the vendor to extract that information from Accela? *Yes, the vendor will need to extract the information from Accela when/if the information is available.*

Question # 43

When you say "Provide a cost estimate in a per image format that includes cost per image to index by document number." What document number are you referring to? Case Number, Parcel Number, Batch Number? And if not these what document number? *See below for corrected verbiage.*

Question # 44

Please tell us approximately how many keystrokes is this document number you want us to index by? *See below, Correction to RFP, we have removed this requirement.*

Question # 45

When you ask "and will provide support to the City records technician to upload images to Documentum ApplicationXtender are you asking us to create a load file string? *We ask that you be available should the City Records Technician have issues during the upload.*

Question # 46

If you are asking us to create a load file string can you please provide an example of one? *We are not asking for a load file string. Please submit scanned/converted images on any readable physical media such as CD, DVD, USB drive or HDD.*

Question # 47

Other than creating a load file string for import what other assistance would you need from the vendor in regards to import? *None.*

Question # 48

Does it disqualify a vendor if they are not a part of the Accela index field extraction? *No, not all fields are extracted from Accela. Winning bidder will need to be able to extract the index fields via the appropriate software if/when needed.*

Question # 49

We request you have a second round of questions for clarification after this round of questions is answered. Is that possible? *The last day to submit questions is 3/11/2016 at 3:00 p.m. Reno time, we will not be extending this time frame.*

Question # 50

What image file format would the City like the data delivered back in – single page TIF, multi-page TIF, PDF files? 200 DPI for text, in a TIF format, is probably the minimum. For images, like plans for Community Development, you will want to go to 400 DPI, but still a TIF format.

Question # 51

What type of documents are on the fiche? There are many types of documents on the fiche, see attached example of indexing, hopefully it will give you more insight as to what types of documents are on the fiche.

Question # 52

How are the Police Dept. documents on the fiche to be indexed? See attached example of indexing.

Question # 53

Is there an electronic database available to match and merge the index data? See attached example of indexing, our electronic database is documentum ApplicationXtender.

Question # 54

Can you provide pictures of the film and fiche? Unfortunately, at this time we are unable to accommodate your request.

Question # 55

Can the vendor pick up samples to do complimentary scans for quality and testing? Unfortunately, at this time we are unable to accommodate your request.

Question # 56

Is there currently a vendor doing this work, or has in the past? If so who was the vendor? The vendor who has done the work in the past for the City is High Desert Microimaging.

Question # 57

Did a vendor help write this RFP in regards to the quantities? If so who is the vendor? No, a vendor did not assist us in writing this RFP.

Question # 58

Does the city want these OCR'd? Yes, we would like to have them OCR'd but it is not a requirement.

Question # 59

On the costsheet, it states on one of the line items "provide a cost estimate in a per image format that includes cost per image to index by document number." Does that mean the vendor is only indexing document number and auto-populating the rest of the fields through your Accela System? See below, Correction to RFP, we have removed the document number requirement. Vendor may be able to auto-populate the fields from Accela.

Question # 60

What version of applicationxtender is the City using? The City is using ApplicationXtender Web Access .Net Version 7.0.260.0

Question # 61

How many pages are in an average document? (this tells vendor how often they need to stop and index) Varies per document and department. (see attached example from Community Development)

Question # 62

Are all the index fields on the first page? No, the index fields may be on multiple pages.

Question # 63

Is there room at the City of Reno to perform the job onsite with vendor equipment and staff? No, there is not room at any of the City office locations for the job to be performed onsite.

Question # 64

Will RFP Submissions be accepted electronically via Email? We will not accept an RFP submission via Email.

Question # 65

Will private carrier such as FEDEX be permitted for delivery of proposal and CD/DVD's or must it be through the USPS? Yes, you may choose a private carrier to deliver your proposals to the City. Please submit to 1 E 1st Street, City Clerks Office – 2nd Floor, Reno NV 89501 – Clearly identify the RFP # on the outside of the package.

Question # 66

Page 22 you ask for a break out of pickup and delivery of film which conflicts with the statement on page 9 that states pricing shall be inclusive of ALL Costs such as per diem, travel time, hotel costs and all other expenses relating to the products/services purchased. Can you clarify if you are looking for a cost breakdown or a bundled price per image that is all inclusive? You can do either one or both, whichever you prefer.

Question # 67

Are images to be scanned black/white or gray scale? Please refer to page 23 – Output Image – Technical Requirements – last sentence.

Question # 68

Has this project been budgeted for this fiscal year FYE 6/30/2016 or next FYE 6/30/2017 and how much has been budgeted for this project? The City understands that this could be a multi-year contract. Please submit your bids accordingly. (i.e. what the costs will be and the length of time you feel it will take to complete this project)

Question # 69

Please define the criteria you will use in determining if a 100% Performance bond will be required? The City will generally consider the criteria as laid out under Nevada Revised Statute 332.065(1) when determining whether a 100% performance bond is necessary. In addition, the City reserves the right to consider additional factors as it deems appropriate and necessary based on information received in the submitted proposals.

Question # 70

If Performance Bond is required and we decide that would not make the project attractive to us, is the 5% RFP bond refundable? Please see RFP page 16, Section 7, Bonds Required, which states that “Each RFP shall be accompanied by a certified or cashier’s check, or RFP bond, in the amount of five percent (5%) of the total amount RFP, payable to the City of Reno, Nevada, as a penalty in the event the Proposer does not, within ten (10) working days after receipt of written notice that the contract has been awarded, enter into a contract with the City of Reno in accordance with this RFP.” Thus, the RFP does not require that the 5% RFP bond be refunded should a Proposer who is awarded the contract not agree to move forward with the execution of the contract with the City.

Question # 71

For indexing purposes to extract the appropriate index fields, how does the City of Reno intend to give the vendor access to the Accela Automation permitting software? We will discuss this process with the winning vendor.

Question # 72

Are the microfilm rolls identified in the Accela Automation permitting software and are the images on the rolls sequenced the same as the records in the Accela Automation software? No, they are not identified in Accela and no they are not sequenced the same as the records in the Accela Software. We will have some images that are prior to computers that will require indexing, and will not be in Accela.

Question # 73

It appears the indexing requirements listed are only for the building department files. Will there be more detail on the Police Department indexing and the City Clerk Indexing? See below, Correction to RFP, we have attached additional examples of indexing fields for the Police Department. We are unable to provide any samples of indexing for the City Clerk’s office.

Question # 74

How many linear inches of microfiche does the PD have? The number of linear inches is unknown.

Question # 75

Would the City consider an alternative bid for this conversion project that would be less expensive? *No, please bid according to the RFP specifications.*

Question # 76

In regards to the Community Development Department, City Clerk and Police Department can City provide the Year range of documents? *Community Development's approximate year range goes back 50-60 years. Police Department's approximate year range is 1940-2005. City Clerk's approximate year range is unknown.*

Question # 77

How often will the vendor be required to pick up? *The vendor may pick the film up on an as need basis or the entire amount all at once, that is up to the vendor's discretion, please indentify in your bid what your preference is.*

Question # 78

What is the minimum and maximum number of items to be picked up at one time? *That would be up to the vendor's discretion.*

Question # 79

Is Vendor responsible for boxing/packing the items for transportation to Vendor location? *Yes, it will be the vendor's responsibility.*

Question # 80

Does the City require the index database in excel, CSV, or access? *We would prefer either excel or CSV.*

Question # 81

If there are case numbers or parcel numbers on the rolls are they in sequential order? *This information is unknown at this time.*

Question # 82

What is the requested turnaround time? *I am not sure what turnaround time you are referring to. Perhaps some of the other questions and answers will provide the information you are looking for.*

Question # 83

Is this the first time these services have been requested? If not is there a current contract that can be provided? *This is the first RFP we have submitted for these services.*

Question # 84

How many types of reports are there for the various departments for this project? *See attached example of indexing which may provide you the different types of reports for each department.*

Question # 85

In regards to the Police Department jackets/fiche, jackets typically contain 5 channels or rows, how many channels (or rows) are there in the jackets or fiche? *This information is unknown at this time.*

CORRECTION TO RFP

Indexing Technical Requirements (Minimum)

Description of Requirement Check “Yes” if you are able to meet these requirements and “No” if you are not.	Yes	No
Index fields will be pulled from the City’s current permitting software, Accela Automation with at least the following fields as appropriate: <ul style="list-style-type: none">• Case Number• Doc Type• Parcel Number• Case Name• Address• Date• Batch Number• Additional index field examples are attached for the Police Department & Community Development Department.		
Are there any other contractual, on-going, tax or labor costs not included in this list?		

I _____ of _____
Print Name Firm Name

acknowledge receipt of Addenda #1 (8 pages) for RFP 030118 on _____.
Date

This addendum must be signed and returned with your documents.

Marcie Wood
Purchasing Technician



Query Results for Application 'CD_1'

Modify Query

Document 1 - 2 of 2

<input type="checkbox"/>	CASE #	DOC TYPE	PARCEL	CASE NAME	ADDRESS	DATE	BATCH NBR	Document ID	Pages
<input type="checkbox"/>	LDP96-239521	BUILDING PLANS	005-180-68	24 HOUR NAUTILUS (GOLD'S GYM)	1595 SKY MOUNTAIN DR	03-01-1996	ROLL 854 35MM	324555	28
<input type="checkbox"/>	LDP96-239521	BUILDING PLANS	005-180-68	24 HOUR NAUTILUS (GOLD'S GYM)	1595 SKY MOUNTAIN DR	03-01-1996	ROLL 658	320850	6



Import Purge View Tools Help



Application | Paths | Fields | Audit Trail | Index Image File Setup

Field Name: Data Type: Length:

Format

Flags:

☒ Required ☒ Search ☐ Read-Only

☐ Doc Level Security ☐ Part of Unique Key ☐ Dual Data Entry

☐ Key Reference ☐ Data Reference ☐ Auto Index

☐ Validation Mask ☐ Leading Zeroes

Application Field Order:

Field Name	Data Type	Field Length	Field Format	
CASE #	Text	32		<div></div>
DOC TYPE	User-defined List	45		
PARCEL	Text	16		
CASE NAME	Text	128		



Import Purge View Tools Help



Application | Paths | Fields | Audit Trail | Index Image File Setup |

Field Name: Data Type: Length:

Format

Flags:

☒ Required ☒ Search ☐ Read-Only

☐ Doc Level Security ☐ Part of Unique Key ☐ Dual Data Entry

☐ Key Reference ☐ Data Reference ☐ Auto Index

☐ Validation Mask ☐ Leading Zeroes

Application Field Order:

Field Name	Data Type	Field Length	Field Format	
CASE NAME	Text	128		
ADDRESS	Text	128		
DATE	Date	10	mm-dd-yyyy	
BATCH NBR	Text	128		

APPLICATION FOR PERMIT(S)

"Please Print"

1595
 JOB ADDRESS: ~~1595~~ SKY MOUNTAIN DR. 0301-05
 SUBDIVISION: RBNC VISTA BLOCK NO.: LOT NO.:
 PARCEL NO.: 005-160-68 ZONING: N.C. VALUATION: \$250,000
 JOB TYPE: (Please Mark One)

- ☐ 1 NEW STRUCTURE
☐ 2 NEW SIGN
☐ 3 ADDITION
☐ 4 FIRE DAMAGE REPAIR
☐ 5 DEMOLITION
☐ 6 REMODEL, REPAIR, ALTERATION
☐ 7 RE-ROOF
☒ 8 OTHER
☐ 9 GRADING

Description of Work to be Done:

TENANT IMPROVEMENTS
 REVISIONS TO LOCKER ROOMS
 & MOVING PARTITIONS
 ELEC / PLUMB / MECH

PARK DIST.: _____

DESCRIPTION OF USE: HEALTH CLUB

TYPE OF CONSTRUCTION: ~~TYPE-2~~ TYPE-2 NON-RESIDENTIAL

OCCUPANCY GROUP: A-3

NO. OF DWELLING UNITS: _____

FIRE SPRINKLERS: ☒ YES ☐ NOFIRE ALARMS: ☐ YES ☐ NO

APPROVAL FROM PROPERTY OWNER REQUIRED:

☒ YES☐ NO

OWNER: GOLD'S GYM

PHONE NO.: _____

ADDRESS: _____

CITY: _____

STATE: _____

ZIP: _____

PERSON TO CONTACT REGARDING THIS PROJECT: THE PROJECT REVIEW TEAM WILL DIRECT ALL
 CORRESPONDENCE REGARDING THE PLAN REVIEW OF THIS PROJECT TO THE PERSON
 DESIGNATED BELOW.

NAME: DALE COX

PHONE NO.: 916-587-6757

LETTER ATTACHED REGARDING:

MPR _____

SUP _____

VARIANCE _____

NO. OF STORIES: _____

BUILDING HEIGHT IN FEET: _____

TOTAL PROJECT SQUARE FOOTAGE: ~~2~~ _____

SIGN FACE: _____

THICKNESS: _____

ELECTRICAL: ☐ EXISTING☐ NEW

PRINCIPAL DESIGNER: _____

PHONE NO.: _____

BUILDER: LCM CONTRACTORS

CONTRACTOR

PHONE NO.: _____

STATE LICENSE NO.: _____

CITY BUSINESS LICENSE NO.: _____

ELECTRICAL: ELECTRIC-TEC Washoe Elec.

STATE LICENSE NO.: _____

CITY BUSINESS LICENSE NO.: _____

PLUMBING: RAY HEATING & J.W. McClenahan CO.

STATE LICENSE NO.: _____

CITY BUSINESS LICENSE NO.: _____

MECHANICAL: RAY HEATING

STATE LICENSE NO.: _____

CITY BUSINESS LICENSE NO.: _____

CONTACT WASHOE DISTRICT HEALTH DEPARTMENT REGARDING APPLICATIONS FOR THE
 FOLLOWING PROJECTS:

1. COMMERCIAL FOOD RELATED PROJ.
2. DUST CONTROL
3. COMMERCIAL POOLS AND SPAS

4. DEMOLITION PROJECTS
5. UNDERGROUND FUEL TANKS
6. INDUSTRIAL PROCESSING PROJ/PAINT BOOTHS 699211CER



Sierra Pacific
POWER COMPANY

Meeting your future with energy

6100 Neil Road, P.O. Box 10100, Reno, Nevada 89520-0400 • 702.689.4011

March 21, 1996

Brent Boyer, Engineering Dept.
City of Reno
P.O. Box 1900
Reno, NV 89505

RE: Address: 1595 Sky Mountain Dr.
Parcel#: 05-180-68

Dear Mr. Boyer:

This letter is to inform you that no additional water rights are required for this project. The project being built on the above parcel will be tenant improvements for

24-Hour Nautilus with landscaping.

Should you have any further questions in regard to the above project, please call me at 689-3140.

Sincerely,

Cindy Castleman
CINDY CASTLEMAN
Water Resources Technician

CC/smj

239521

COX & KROMYDAS
A•R•C•H•I•T•E•C•T•S

APPROVED
L. Ramociotti
CITY OF RENO
PLANS EXAMINER
LEONARD A. RAMOCIOTTI

April 10, 1996

RECEIVED
CITY OF RENO
BUILDING DEPT.

Mr. Leonard Ramociotti
City of Reno
Community Development Department
P.O. Box 1900
Reno, NV 89505

'96 APR 11 A8:58

RE: 24-Hour Nautilus (Gold's Gym)

Dear Leonard:

Pursuant to our meeting, I am requesting a change in building designation from Type II-N with A-3 Occupancy to Type III-N with A-3 Occupancy.

The original plans and permit (#220682 9/7/94) show wood shear walls on interior partitions and wood roof rafters on the shed roof at the entry. Since no unprotected wood members are permitted in Type II-N buildings, we would like to change the building classification to Type III-N which allows the use of these wood elements.

The A-3 Occupancy would remain as originally shown.

Enclosed you will find a code analysis of the building as originally plan checked and the proposed code change.


Thank you for your time on this matter. If you have any questions, please give me a call.

Sincerely,

Dale W. Cox
Dale W. Cox

DC/rma


cc: Adam Shaw
John E. Matthams Group

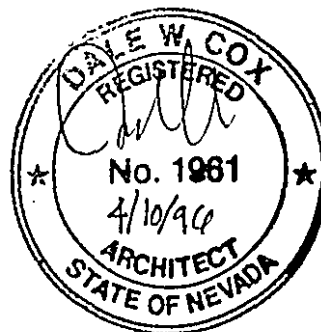

239521

24-HOUR NAUTILUS**CODE ANALYSIS**

Original Permit #220682 Issued 9/7/94

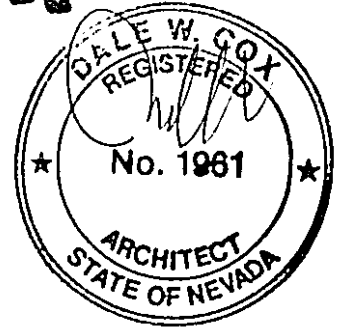

Building	Type II-N
Occupancy	A-3 (Assembly Room Occupancy 209) Sprinkled Separated on All Sides
Building Size	First Floor 20,757 Sq. Ft. <u>Mezzanine 4,766 Sq. Ft.</u>
	Total 25,528 Sq. Ft.

RECEIVED
CITY OF RENO
BUILDING DEPT.

'96 APR 11 AM 58

Building As Shown on Plans

Building	Type III-N
Occupancy	A-3
Building Square Feet	First Floor 20,757 Sq. Ft. <u>Second Floor 4,766 Sq. Ft.</u>
	Total 25,523 Sq. Ft.

APPROVED
L. Ramociotti
 CITY OF RENO
 PLANS EXAMINER
 LEONARD A. RAMOCIOTTI

Occupancy Load	1 Person/50 Sq. Ft.
Assembly Area (First Floor)	10,212 Sq. Ft./50 Sq. Ft. = 204 People
Mezzanine	2,401 Sq. Ft./50 Sq. Ft. = 48 People
Aerobics	2,365 Sq. Ft./50 Sq. Ft. = 47 People

Allowable Floor Area

Type II-N	9,100 Sq. Ft. Allowed
Triple When Sprinkled	27,300 Sq. Ft. > 25,523 Sq. Ft.
Separated on All Sides	Increase of 50% X 9,100 Sq. Ft. = 4,550 Sq. Ft. or 31,850 Sq. Ft. Total Increase


General Notes and Conditions

1. Examination of the site and portions thereof which will affect this work shall be made immediately by the Contractor, who shall compare it with the drawings and satisfy himself to conditions under which work is to be performed. He shall at such time ascertain and check locations of the existing structures and equipment which may affect his work.
2. Contractor shall provide Designer and Tenant with a complete cost breakdown and schedule of construction for this project prior to commencement of work.
3. Contractor shall be responsible to obtain and pay for all necessary permits, inspections, certificates, and fees. He shall also be responsible for filing of application for permit and plan check approval as necessary. (This section subject to Tenant's review and approval.)
4. Contractor shall protect Tenant area, new and/or existing materials and finishes from damage which may occur from construction, demolition, dust, water, etc., and shall provide and maintain temporary barricades, closure walls, etc., as required to protect the public and Tenant during the period of construction. Damage to new and existing materials, finishes, structures, and equipment shall be repaired or replaced. Contractor shall coordinate temporary barricades with Tenant prior to commencement of work as necessary.
5. Materials that are specified by their brand names establish standards of quality and performance. Any request for substitution shall be submitted to the Designer and Tenant for review for equal quality and performance and shall not be purchased or installed without their written approval. All non-specified products shall conform to requirements set forth by code compliance or industry standards and Contractor shall submit a list of products and manufacturers being used for review by Designer prior to purchase or installation.
6. All construction work, architectural, mechanical, plumbing, electrical, etc., as may be required, shall conform to the latest edition of the Uniform Building Code and the latest edition of all governing codes and regulations as adopted by the City of Reno. All work shall be done in a thorough, workmanlike manner and equal to the best standards of the practice.
7. All dimensions on construction drawings are to face of finish (F.O.F.), face of stud (F.O.S.), or face of column (F.O.C.), unless otherwise noted to be the center line of mullion, partition, or column, etc.
8. All dimensions take precedence over scale. Any discrepancies shall be brought immediately to the attention of the Designer. CONTRACTORS SHALL NOT SCALE DRAWINGS. Questions regarding dimensions shall be brought to Designer or Tenant prior to any start of work.
9. All construction documents are complementary, and what is called for by any will be binding as it called for by all. Any work shown or referred to on any construction documents shall be provided as though on all related documents. Discrepancies shall be brought immediately to the attention of Designer for clarification.
10. All work listed, shown or implied on any construction document shall be supplied and installed by the Contractor except where noted. The contractor shall closely coordinate his work with that of other contractors or vendors to assure that all schedules are met and that all work is done in conformance with manufacturer's requirements. Work required under this contract shall include all labor, materials, equipment, etc. necessary to complete this project. All materials shall be new and unused, unless specifically noted and be a quality acceptable by industry standards.
11. The use of the word "provide" in connection with any item specified is intended to mean that such shall be furnished, installed, and connected where so required, except as noted.
12. The Contractor shall submit shop drawings for fabricated items, cut sheets of all fixtures and equipment, and samples of all finishes called for by the Designer and Tenant for approval prior to construction and/or installation.
13. The Contractor shall maintain a current and complete set of construction documents on the job site during all phases of construction for use of all trades and shall provide all subcontractors with current construction documents as required. The Contractor, in assuming responsibility for the work indicated, shall comply with the spirit as well as with the letter in which they were drawn.
14. The Contractor shall remove all rubbish and waste materials of all subcontractors and trades on a regular basis, and shall exercise strict control over job cleaning to prevent any dirt, debris or dust from affecting, in any way, finished areas in or outside the job site.
15. The construction documents are provided to illustrate the design and general type of construction desired and imply the finest quality of construction, material and workmanship throughout.
16. All electrical, mechanical, and plumbing work and materials shall be in full accordance with the latest rules and regulations of the National Board of Fire Underwriters, the State Fire Marshall, the Safety Orders of the Division of Industrial Safety, and any applicable state or local laws and ordinances. Nothing on these drawings is to be construed to permit work not conforming to these codes.
17. The Contractor is cautioned that his work includes alterations to existing facilities. Work which is obviously required to be performed in order to provide a completely operable installation within the limits and scope of work, but which may not be specifically included in the plans, shall be performed by Contractor and included in his bid.
18. Contractor is encouraged to re-use all removed materials which are in good condition, where feasible and economical, and where in conformance with code requirements. Replace those which are defective and/or not in conformance with code requirements where re-use is indicated or implied.
19. All work shall be guaranteed against defects in design, installation and material for a minimum period of one year from date of completion.
20. Contractor shall personally supervise and direct the work or shall keep a competent employee, authorized to receive instructions and act on the contractor's behalf, continuously on site during working hours.
21. The Contractor shall submit for approval by the Designer and Tenant a detailed construction schedule showing phasing of work and any mechanical, plumbing or electrical disruptions to building services as may occur. All disruption shall be coordinated with the Tenant a minimum of 24 hours before work commencement.

RECEIVED
CITY OF RENO
BUILDING DEPT.
96 MAR-1 4:00 PM

24 HOUR NAUTILUS SKY MOUNTAIN DRIVE RENO, NEVADA 30105 REVISED SHEET INDEX

A3.r	First Floor Plan
A3.1.r	Locker Room Plan
A4.r	Mezzanine Plan
A6.r	Lower Level Structural Plan
A7.r	Upper Level Structural Plan
A9.r	Elevations
A10.r	Elevations
A16.r	Structural Details
A17.r	Structural Details
A18.r	Structural Details
A19.r	Structural Details
A20.r	Interior Elevations/Details
A21.r	Interior Elevations
A22.r	Interior Elevations
A23.r	Interior Elevations/Schedules
A24.r	Interior Elevations
A25.r	Cabinet Elevations/Details
A26.r	Details
A27.r	Specifications
E4.r	Reflected Ceiling Plan
E5.r	Reflected Ceiling Plan

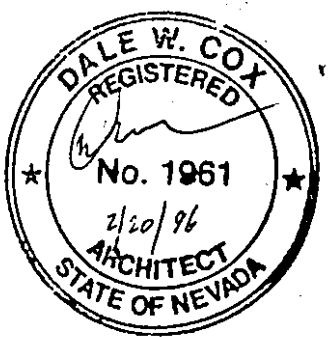

24 HOUR NAUTILUS
RENO 1
SKY MOUNTAIN DRIVE
RENO, NEVADA

COX & KROMYDAS
A.R.C.H.I.T.E.C.T.S.
POST OFFICE BOX 459
TRUCKEE, CA 96160
(916) 587-0757
(916) 581-4422
FAX (916) 587-2136

THESE DRAWINGS HAVE BEEN PREPARED BY COX & KROMYDAS ARCHITECTS FOR THE 24 HOUR NAUTILUS PROJECT. THEY ARE NOT SUITABLE FOR USE ON OTHER PROJECTS, IN OTHER LOCATIONS, OR BY ANY OTHER PERSONS WITHOUT THE WRITTEN APPROVAL AND PARTICIPATION OF COX & KROMYDAS ARCHITECTS. REPRODUCTION IS PROHIBITED.

REVISIONS	DRAWN BY	JLS
21-51x	11/7	DATE 02.20.96
		SCALE:
		JOB NO. 9604

General Notes and Conditions


1. Examination of the site and portions thereof which will affect this work shall be made immediately by the Contractor, who shall compare it with the drawings and satisfy himself to conditions under which work is to be performed. He shall at such time ascertain and check locations of the existing structures and equipment which may affect his work.
2. Contractor shall provide Designer and Tenant with a complete cost breakdown and schedule of construction for this project prior to commencement of work.
3. Contractor shall be responsible to obtain and pay for all necessary permits, inspections, certificates, and fees. He shall also be responsible for filing of application for permit and plan check approval as necessary. (This section subject to Tenant's review and approval.)
4. Contractor shall protect Tenant area, new and/or existing materials and finishes from damage which may occur from construction, demolition, dust, water, etc., and shall provide and maintain temporary barricades, closure walls, etc., as required to protect the public and Tenant during the period of construction. Damage to new and existing materials, fixtures, structures, and equipment shall be repaired or replaced. Contractor shall coordinate temporary barricades with Tenant prior to commencement of work as necessary.
5. Materials that are specified by their brand names establish standards of quality and performance. Any request for substitution shall be submitted to the Designer and Tenant for review for equal quality and performance and shall not be purchased or installed without their written approval. All non-specified products shall conform to requirements set forth by code compliance or industry standards and Contractor shall submit a list of products and manufacturers being used for review by Designer prior to purchase or installation.
6. All construction work, architectural, mechanical, plumbing, electrical, etc., as may be required, shall conform to the latest edition of the Uniform Building Code and the latest edition of all governing codes and regulations as adopted by the City of Reno. All work shall be done in a thorough, workmanlike manner and equal to the best standards of the practice.
7. All dimensions on construction drawings are to face of finish (F.O.F.), face of stud (F.O.S.), or face of column (F.O.C.), unless otherwise noted to be the center line of mullion, partition, or column, etc.
8. All dimensions take precedence over scale. Any discrepancies shall be brought immediately to the attention of the Designer. CONTRACTORS SHALL NOT SCALE DRAWINGS. Questions regarding dimensions shall be brought to Designer or Tenant prior to any start of work.
9. All construction documents are complementary, and what is called for by any will be binding as it called for by all. Any work shown or referred to on any construction documents shall be provided as though on all related documents. Discrepancies shall be brought immediately to the attention of Designer for clarification.
10. All work listed, shown or implied on any construction document shall be supplied and installed by the Contractor except where noted. The contractor shall closely coordinate his work with that of other contractors or vendors to assure that all schedules are met and that all work is done in conformance with manufacturer's requirements. Work required under this contract shall include all labor, materials, equipment, etc. necessary to complete this project. All materials shall be new and unused, unless specifically noted and be a quality acceptable by industry standards.
11. The use of the word "provide" in connection with any item specified is intended to mean that such shall be furnished, installed, and connected where so required, except as noted.
12. The Contractor shall submit shop drawings for fabricated items, cut sheets of all fixtures and equipment, and samples of all finishes called for by the Designer and Tenant for approval prior to construction and/or installation.
13. The Contractor shall maintain a current and complete set of construction documents on the job site during all phases of construction for use of all trades and shall provide all subcontractors with current construction documents as required. The Contractor, in assuming responsibility for the work indicated, shall comply with the spirit as well as with the letter in which they were drawn.
14. The Contractor shall remove all rubbish and waste materials of all subcontractors and trades on a regular basis, and shall exercise strict control over job cleaning to prevent any dirt, debris or dust from affecting, in any way, finished areas in or outside the job site.
15. The construction documents are provided to illustrate the design and general type of construction desired and imply the finest quality of construction, material and workmanship throughout.
16. All electrical, mechanical, and plumbing work and materials shall be in full accordance with the latest rules and regulations of the National Board of Fire Underwriters, the State Fire Marshall, the Safety Orders of the Division of Industrial Safety, and any applicable state or local laws and ordinances. Nothing on these drawings is to be construed to permit work not conforming to these codes.
17. The Contractor is cautioned that his work includes alterations to existing facilities. Work which is obviously required to be performed in order to provide a completely operable installation within the limits and scope of work, but which may not be specifically included in the plans, shall be performed by Contractor and included in his bid.
18. Contractor is encouraged to re-use all removed materials which are in good condition, where feasible and economical, and where in conformance with code requirements. Replace those which are defective and/or not in conformance with code requirements where re-use is indicated or implied.
19. All work shall be guaranteed against defects in design, installation and material for a minimum period of one year from date of completion.
20. Contractor shall personally supervise and direct the work or shall keep a competent employee, authorized to receive instructions and act on the contractor's behalf, continuously on site during working hours.
21. The Contractor shall submit for approval by the Designer and Tenant a detailed construction schedule showing phasing of work and any mechanical, plumbing or electrical disruptions to building services as may occur. All disruption shall be coordinated with the Tenant a minimum of 24 hours before work commencement.

RECEIVED
CITY OF RENO
95 MAR -1 1007

24 HOUR NAUTILUS SKY MOUNTAIN DRIVE RENO, NEVADA

REVISED SHEET INDEX

A3.r	First Floor Plan
A3.1.r	Locker Room Plan
A4.r	Mezzanine Plan
A6.r	Lower Level Structural Plan
A7.r	Upper Level Structural Plan
A9.r	Elevations
A10.r	Elevations
A16.r	Structural Details
A17.r	Structural Details
A18.r	Structural Details
A19.r	Structural Details
A20.r	Interior Elevations/Details
A21.r	Interior Elevations
A22.r	Interior Elevations
A23.r	Interior Elevations/Schedules
A24.r	Interior Elevations
A25.r	Cabinet Elevations/Details
A26.r	Details
A27.r	Specifications
E4.r	Reflected Ceiling Plan
E5.r	Reflected Ceiling Plan

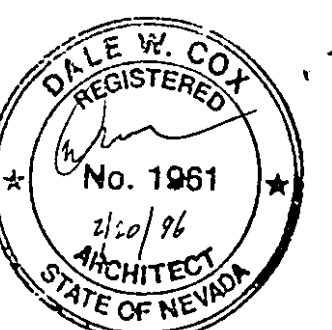

24 HOUR NAUTILUS
RENO 1
SKY MOUNTAIN DRIVE
RENO, NEVADA

COX & KROMYDAS
A.R.C.H.I.T.E.C.T.S

POST OFFICE BOX 459
TRUCKEE, CA 96160

(916) 587-0757
(916) 581-4422
FAX(916)587-2136

THESE DRAWINGS HAVE BEEN PREPARED BY COX & KROMYDAS ARCHITECTS FOR THE 24 HOUR NAUTILUS PROJECT. THEY ARE NOT SUITABLE FOR USE ON OTHER PROJECTS, IN OTHER LOCATIONS, OR BY ANY OTHER INDIVIDUALS WITHOUT THE WRITTEN APPROVAL AND PARTICIPATION OF COX & KROMYDAS ARCHITECTS. REPRODUCTION IS PROHIBITED. (C)

REVISIONS	DRAWN BY	JLS
2/2/96	h/c	DATE 02.20.96
		SCALE:
		JOB NO. 9604

The Reno Fire Department requires the following:

If you have a question regarding this project, please call
Captain Jim Arlin at 334-2323.

- To avoid delays in obtaining a final Certificate of Occupancy, please call the fire department to request an inspection.
- Installing furniture or merchandise in this tenant space prior to the final Certificate of Occupancy is strictly prohibited. Prior to occupying a space, an application for a business license is required.
- Install street address numbers which are plainly visible from the access roadway with a minimum of 6 inch high numbers on a contrasting background. Uniform Fire Code 901.4.4
- Install a "Knox Box" key entry system. Please obtain the order forms from the fire inspector. Uniform Fire Code 902.4
- Extend/modify the automatic fire sprinkler system to provide complete coverage in all areas complying with NFPA 13. Uniform Fire Code 1003.1
- The fire sprinkler/alarm systems shall be electronically supervised to a local central station fire alarm company. Reno Municipal Code 16.040.70
- Install battery pack emergency lighting in all areas of egress. Uniform Fire Code Section 1211.1 & NRS 477.120
- Any storage of hazardous materials or flammable or combustible liquids shall comply with the Uniform Fire Code. No special storage was indicated on this plan.
- Interior wall and ceiling finishes shall have the proper flame spread per the Uniform Building Code Chapter 8. Combustible decorative finishes require a certificate of flame spread which will be collected by the fire inspector on the final construction inspection.
- Interior floor finishes and coverings shall have the proper flame spread per the Uniform Fire Code Appendix IV-A.
- Install fire extinguishers, 2A 10BC type, so that travel distance to a unit does not exceed 75 feet. Uniform Fire Code 1002.1
- Any conditions not accurately depicted in these plans may require additional provisions to comply with the fire and building codes.

RECEIPT

City of Reno, Nevada

Dept of Building and Safety
450 Sinclair Street
Phone 334-2060

Control Number 030105
Owner or Lessee 24 HOUR NAUTILUS (GOLD'S GYM)
Address 1595 SKY MOUNTAIN DR
City, State Zip RENO, NV

Contractor TBA
Job Location 1595 SKY MOUNTAIN DR
Lot _____ Block _____ Sub PM 2753
Type II-N Group A-3 Sprinklers Y
Parcel Number 005-180-68 Park District _____

Purpose of Building VARIOUS COMMERCIAL USES
Number of Units _____
Description TENANT IMPROVEMENT
CEIL/ WALLS/ PLUMB/ ELECT/
MECH

Structure: New _____ Alter/Remodel X
Valuation 250000

Approved by _____
Building Dept

City Clerk _____, 19__

Deputy _____, 19__

Not valid unless certified above for the full amount of the receipt

238903

FEE	
22. Plan Check Fee	\$ 836.48
Approved Plan Check Review	
C.D. PLANNING: _____	Date 3/4/96
C.D. ENGINEERING: _____	Date _____
FIRE: _____	Date 3-15-96
HEALTH: _____	Date _____
PLUMBING: _____	Date 3-11-96
MECHANICAL: _____	Date 3-11-96
ELECTRICAL: _____	Date 3-11-96
STRUCTURAL: _____	Date _____
BUILDING: _____	Date 3-11-96
SIGN: _____	Date _____
IND. WASTE: _____	Date _____
URBAN FORESTER: _____	Date _____
C.D. TRAFFIC: _____	Date _____
CHARGE OUT: _____	Date _____
Expiration of Plan Review shall expire as per U.B.C. Section 304(b).	
Total	\$ 836.48


**Cancelled Check and this Receipt
Must be provided for refund.**

Wall Legend

- 3 5/8" Metal Studs @ 16" O.C.
- 6" Metal Studs @ 16" O.C. (To Structure)
- 1 Hour Rated Partition w/ 6" Metal Studs @ 16" O.C. (To Structure)
- 2 X 4 Pressure Treated and Fire Retardant Treated Studs @ 16" O.C.
- Low Wall - See Plan for Heights 3 5/8" Metal Studs @ 16" O.C.
- Existing Wall

Floor Material Designations

- C. Tile : Ceramic Tile
- Conc : Sealed Concrete
- Cpt : Carpet
- Hrd.Wd : Hardwood
- Rubber : Nora NP VIVA 1308 - "VITA" with accent squares. Pattern to be supplied at a later date.
- Sprt Fir : Rubber Sport Flooring supplied by Club Resource Group (408) 354- 4133
- VCT : Vinyl Composition Tile
- Vinyl : Sheet Vinyl Flooring

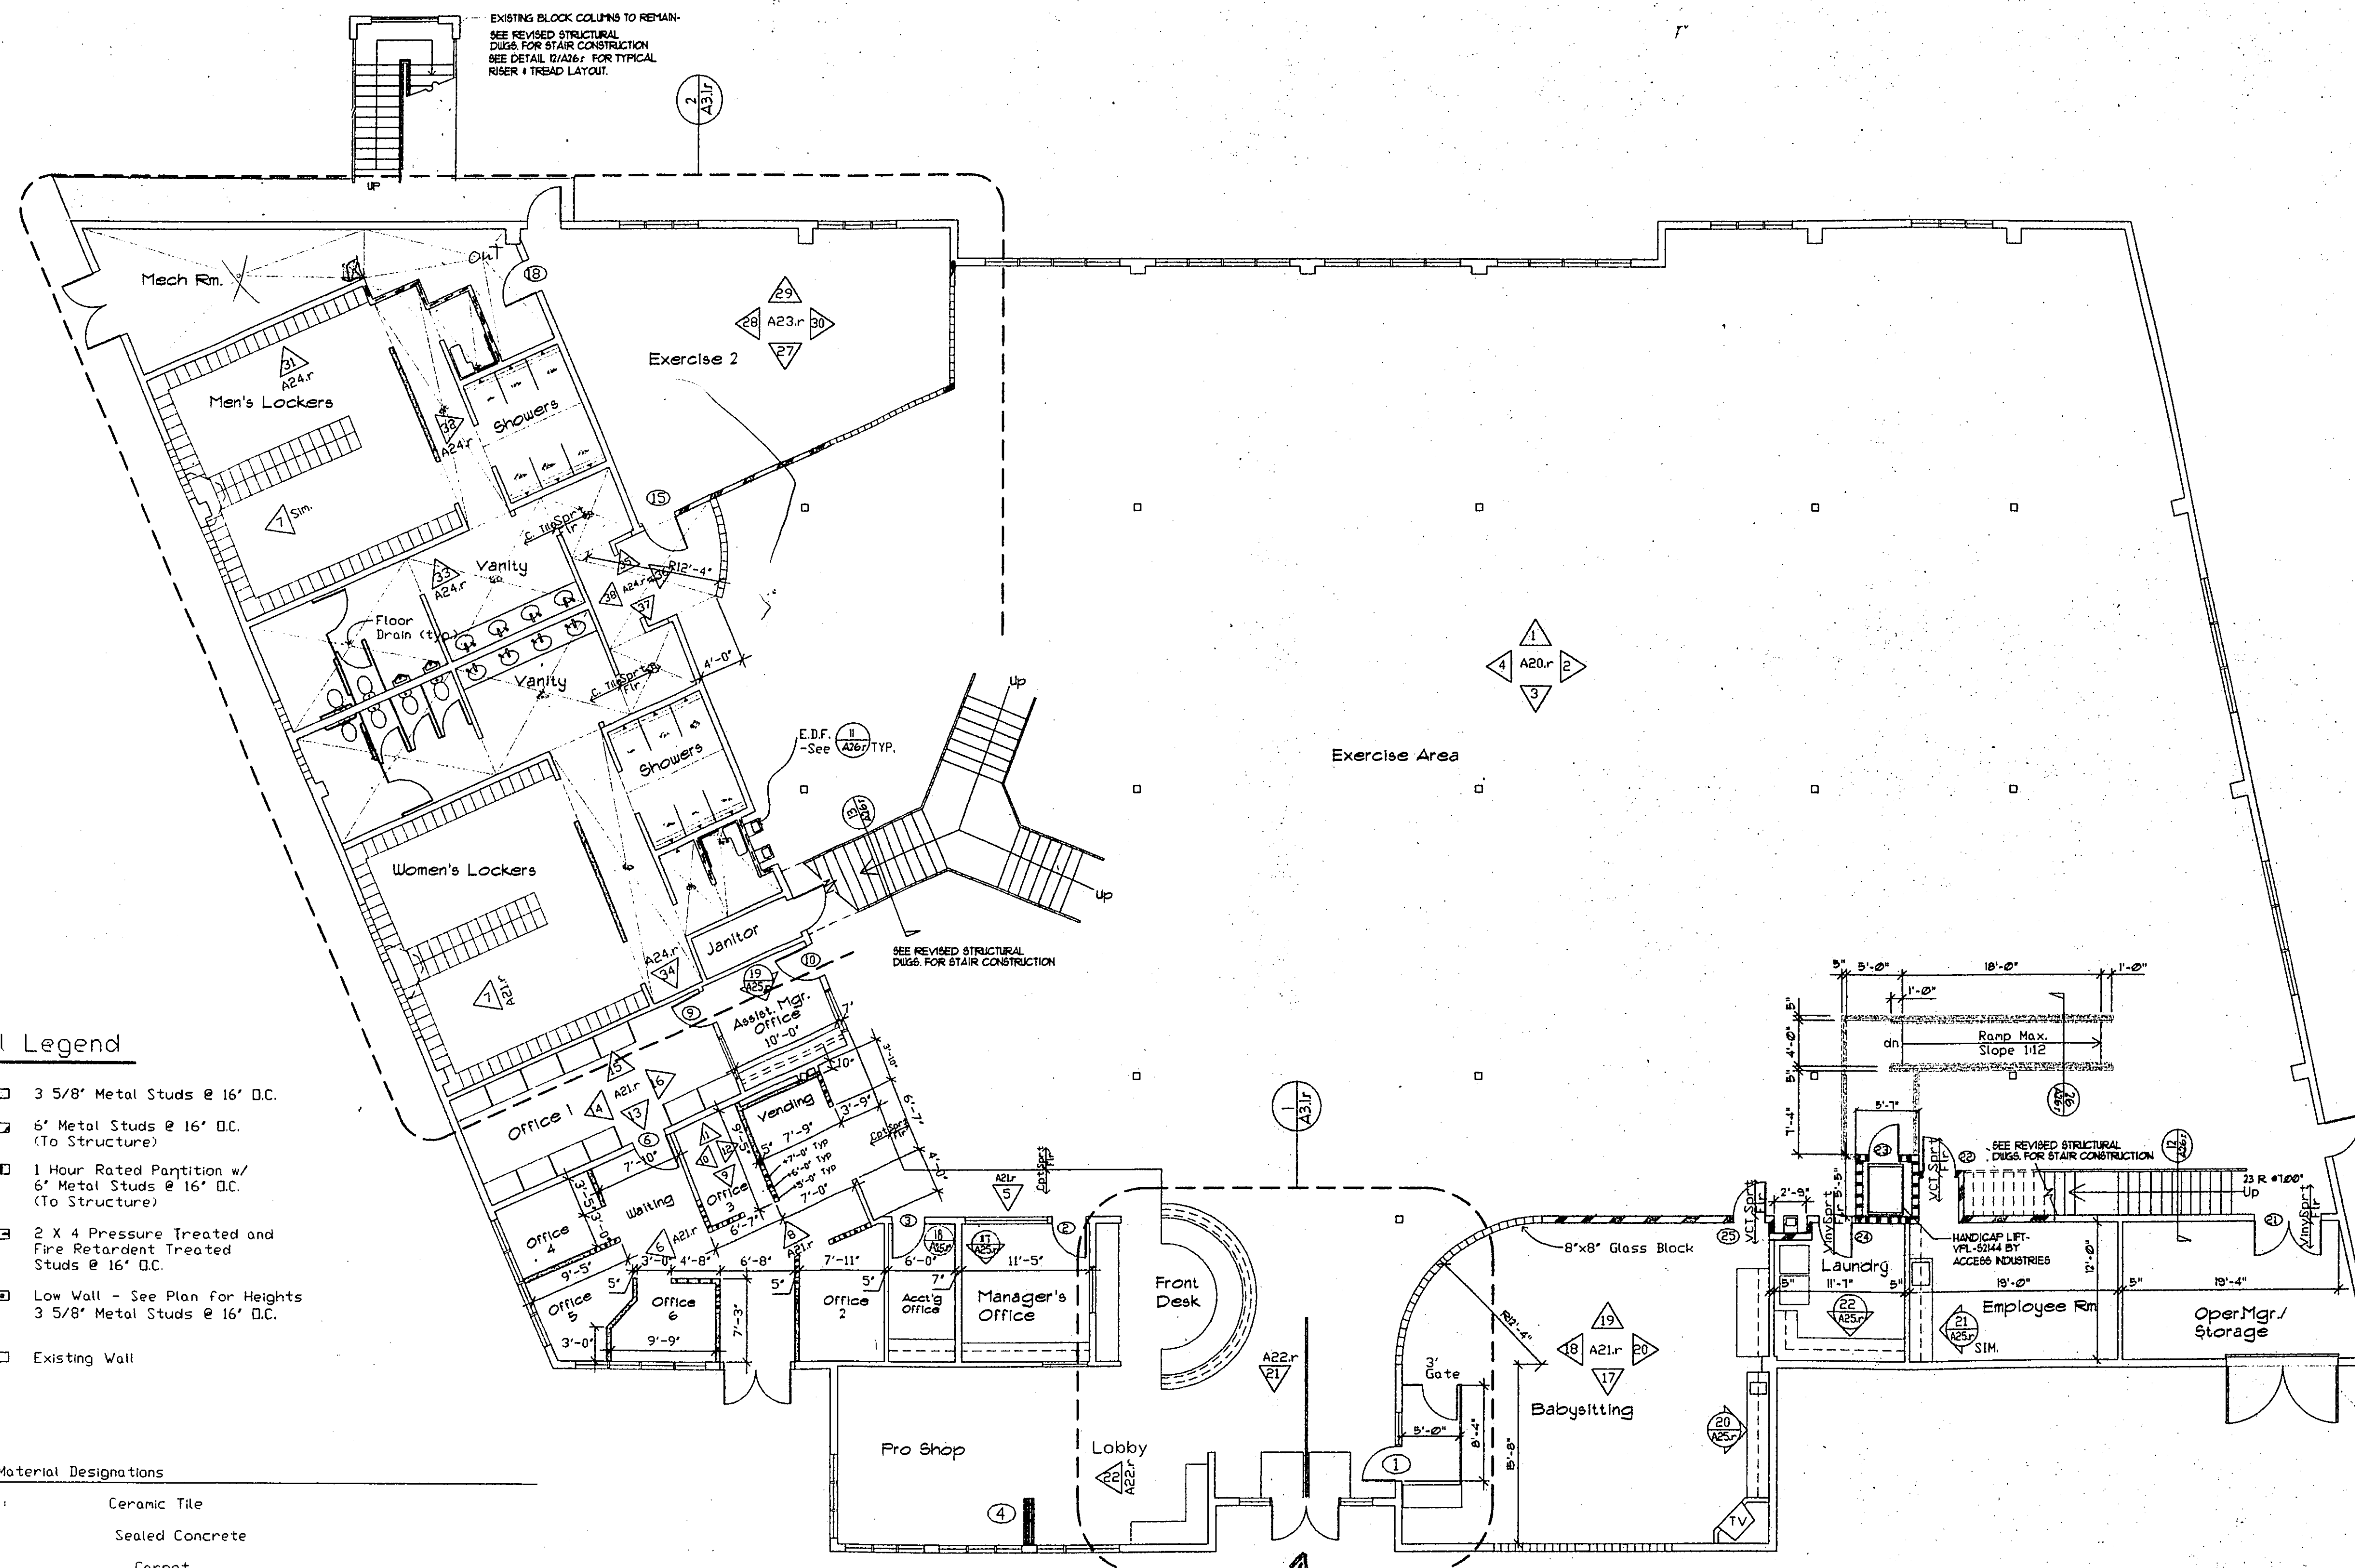

PROVIDE SIGNS AT ALL
REQ EXITS PER U.B.C. 1013.1

First Floor Plan

1/8" = 1'-0"




FIRE DAMPERS SHALL BE INSTALLED IN COMPLIANCE WITH UBC 4509 (J).

CORRIDOR SHALL COMPLY WITH UBC SECTION 1005.

MECHANICAL INSTALLATION SHALL COMPLY WITH UNIFORM MECHANICAL CODE and CITY OF RENO ORDINANCES

PLUMBING INSTALLATION SHALL COMPLY WITH THE NATIONAL PLUMBING CODE and CITY OF RENO ORDINANCES.

ELECTRICAL INSTALLATION SHALL COMPLY WITH THE NATIONAL ELECTRICAL CODE and CITY ORDINANCE.

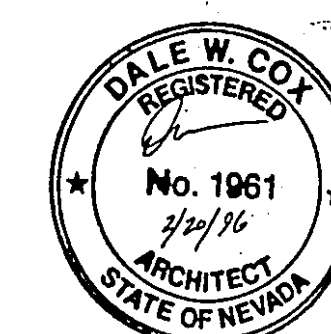

24 HOUR NAUTILUS
RENO 1
SKY MOUNTAIN DRIVE
RENO, NEVADA

COX & KROMYDAS
A.R.C.H.I.T.E.C.T.S


POST OFFICE BOX 459
TRUCKEE, CA 96160

(916) 587-6757
(916) 581-4422
FAX(916)587-2138


THESE DRAWINGS HAVE BEEN PREPARED BY COX & KROMYDAS ARCHITECTS FOR THE 24 HOUR NAUTILUS PROJECT. THEY ARE NOT SUITABLE FOR USE ON OTHER PROJECTS, IN OTHER LOCATIONS, OR BY ANY OTHER INDIVIDUALS WITHOUT THE WRITTEN APPROVAL AND PARTICIPATION OF COX & KROMYDAS ARCHITECTS. REPRODUCTION IS PROHIBITED. ©

REVISIONS	DRAWN BY	JLS
DATE	02.20.96	
SCALE	1/8"=1'-0"	
JOB NO.	9804	


A3.r

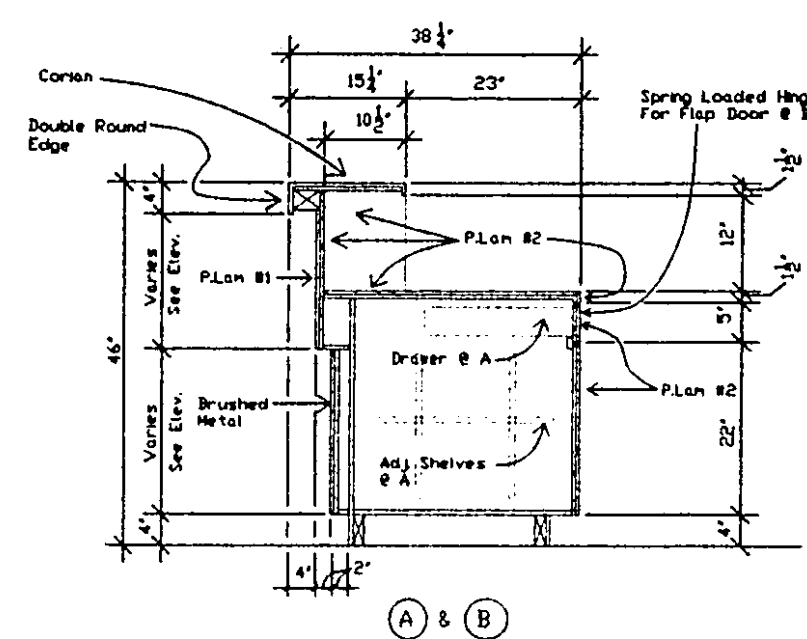


3 Front Desk Section
1/2" = 1'-0"

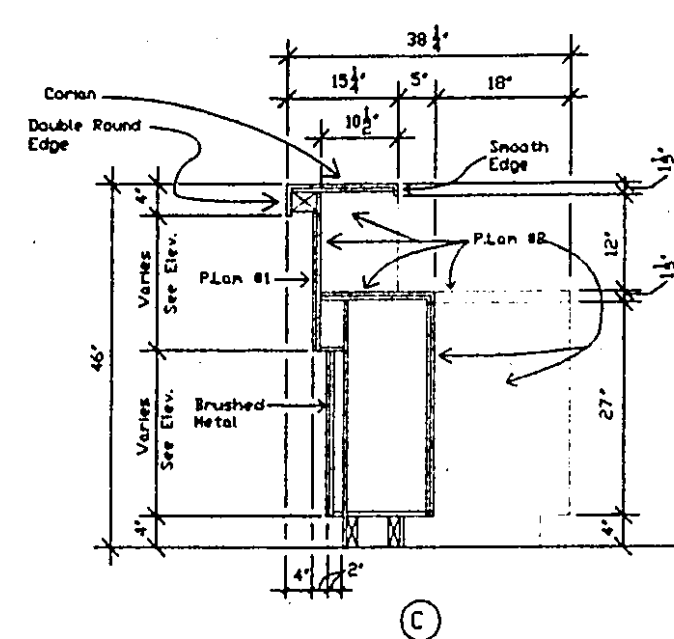


4 Front Desk Section
1/2" = 1'-0"

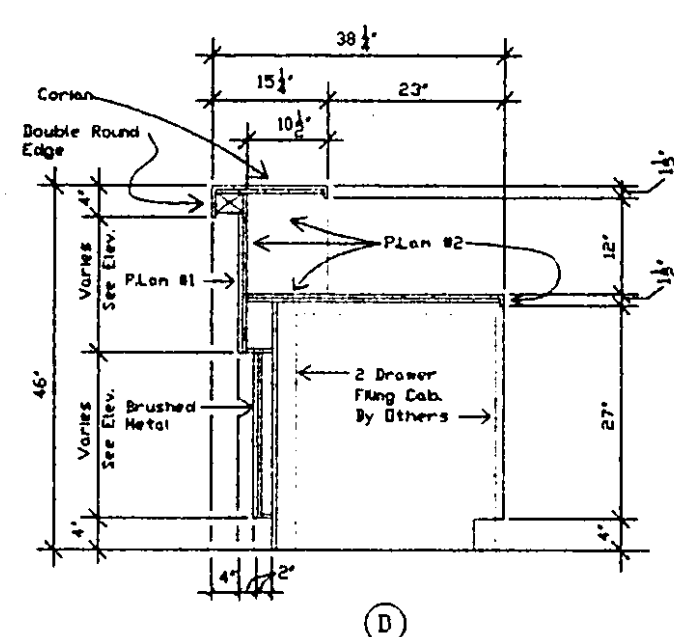


5 Front Desk Section
1/2" = 1'-0"

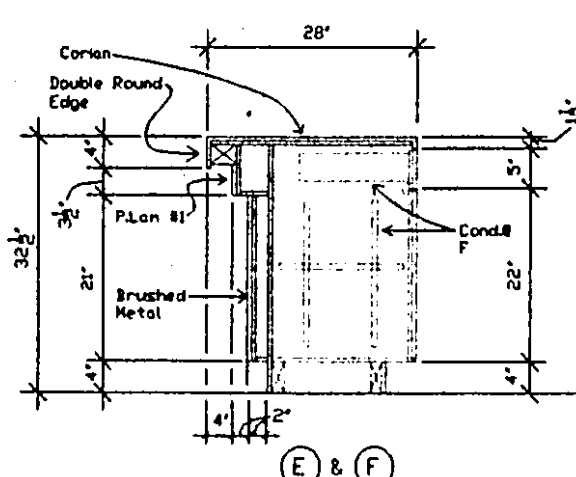


6 Front Desk Section
1/2" = 1'-0"

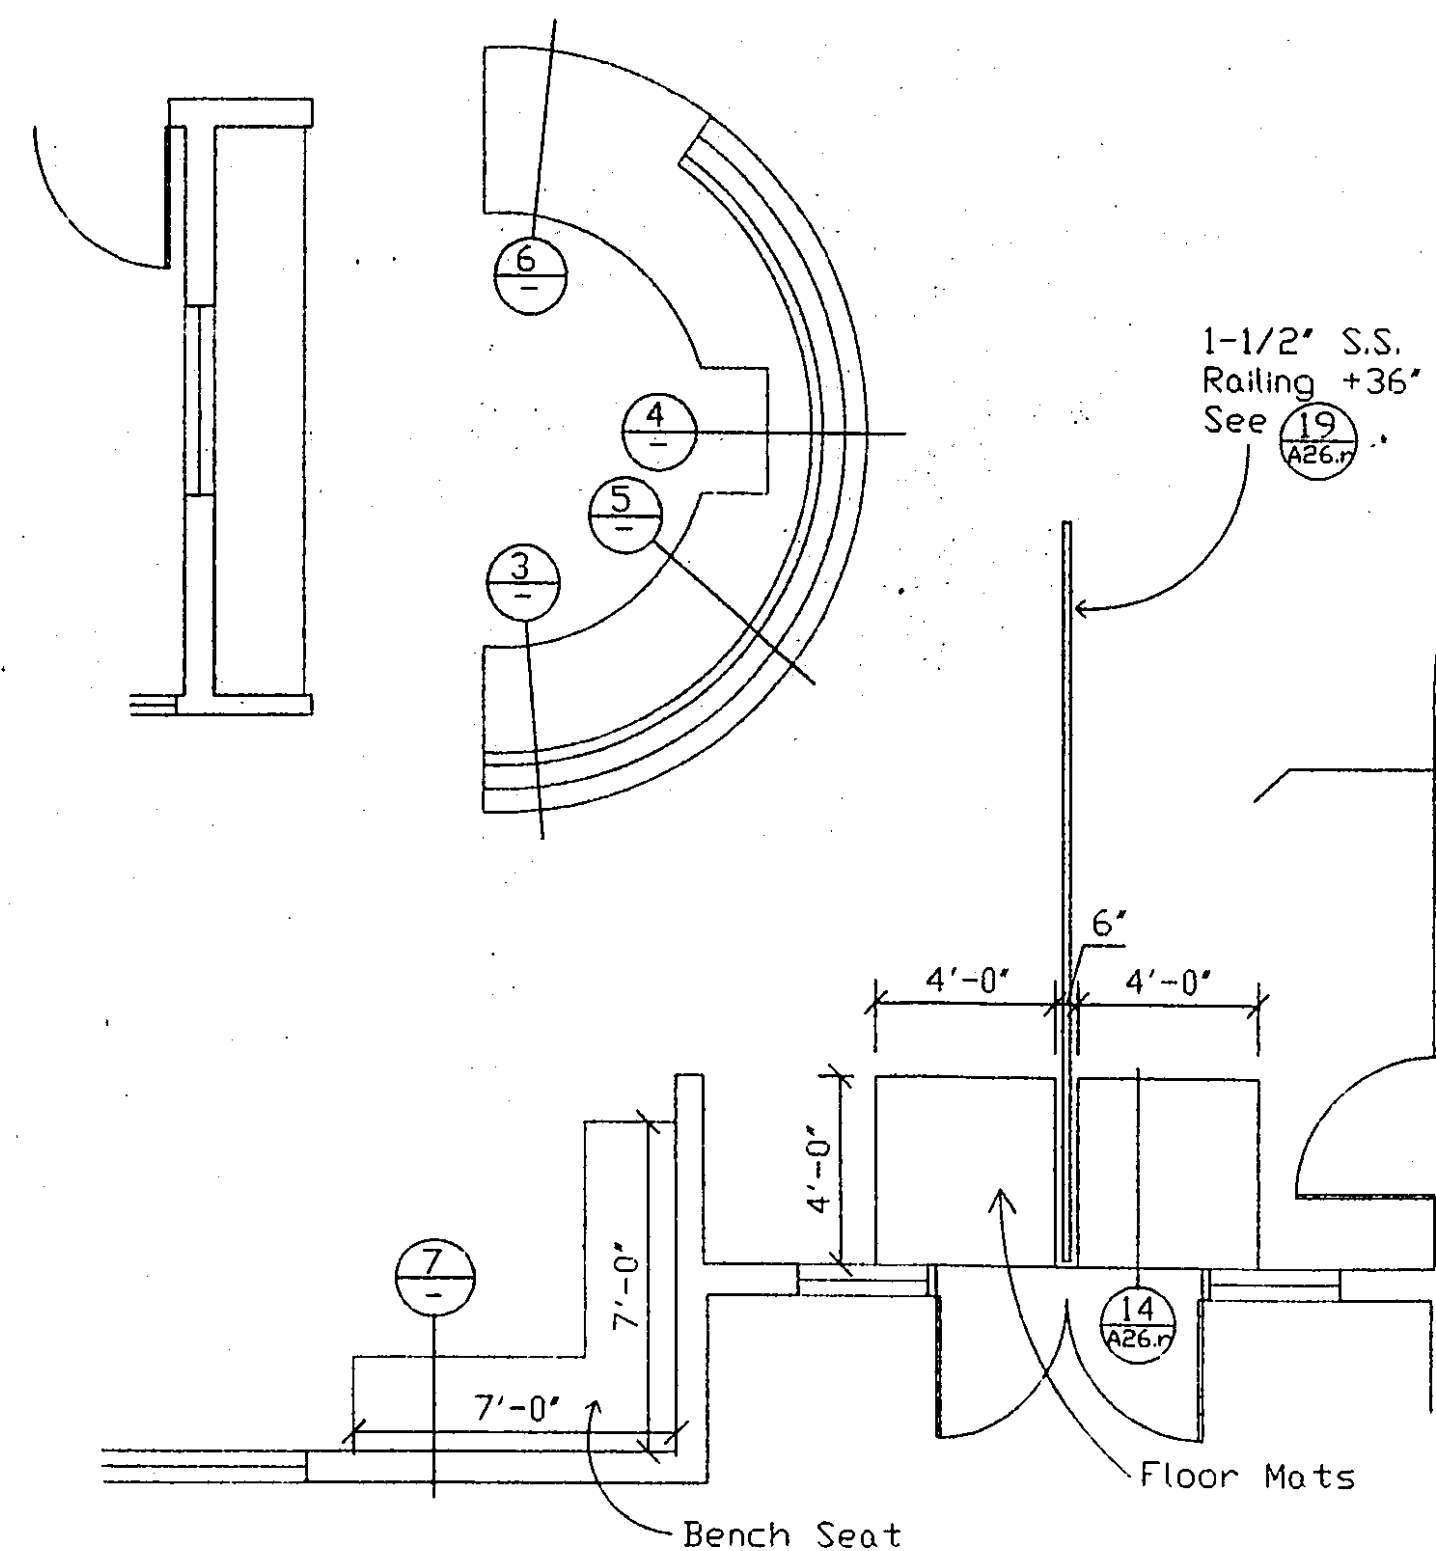

1 Front Desk Plan
1/4" = 1'-0"

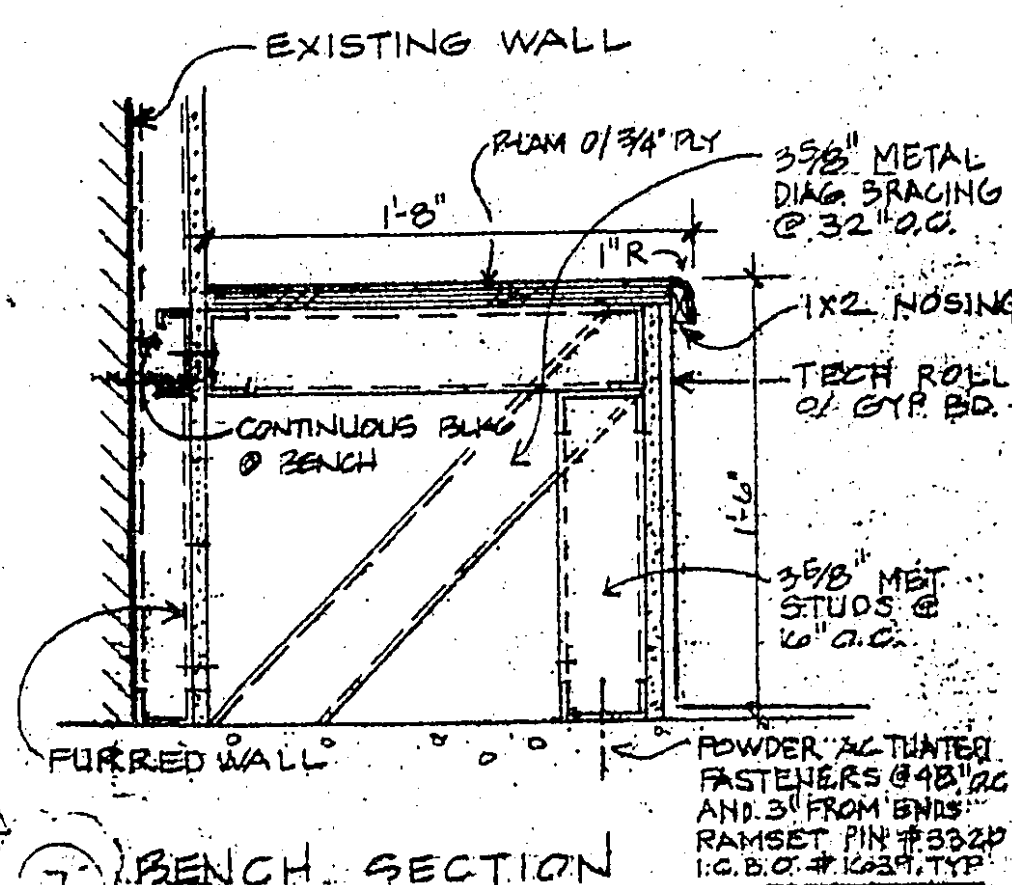

7 BENCH SECTION
1/2" = 1'-0"

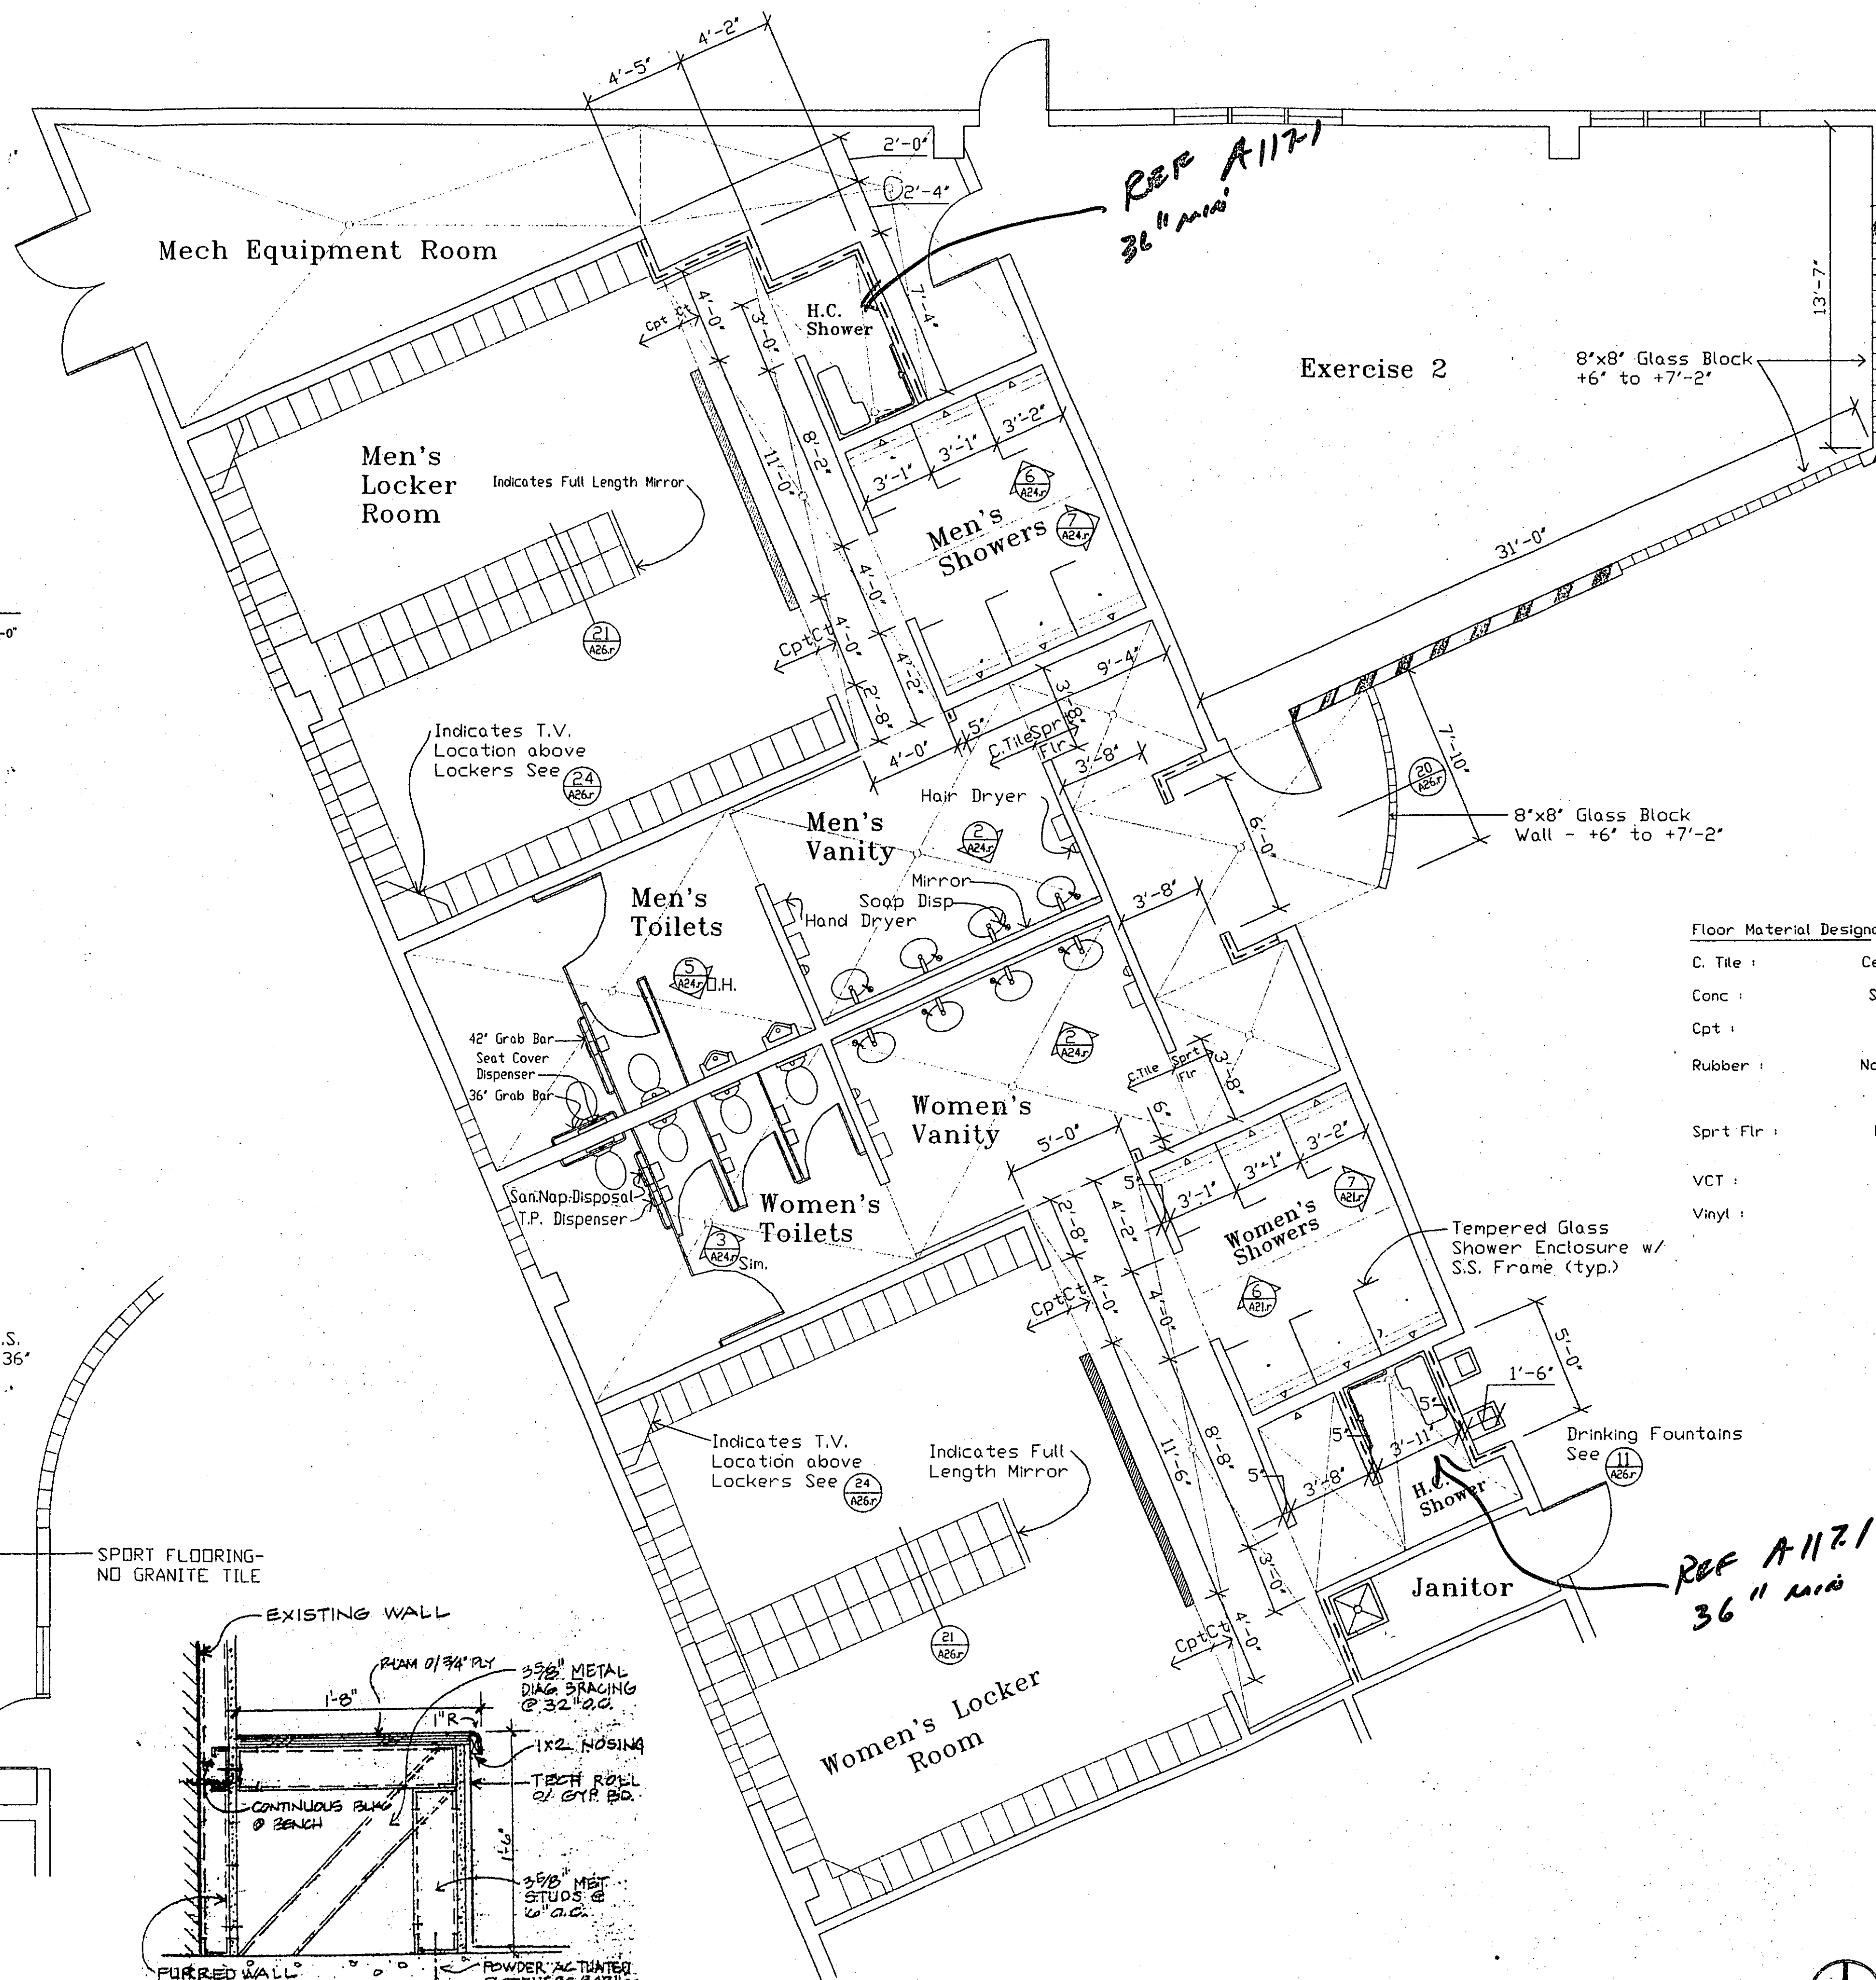

2 Locker Room Plan
1/4" = 1'-0"


Glass & Glazing
Shall Conform With
Requirements Chap. 24 U.B.C.

Wall Legend

- 3 5/8" Metal Studs @ 16' O.C.
- 6" Metal Studs @ 16' O.C.
(To Structure)
- 2 x 4 Pressure Treated and
Fire Retardant Treated
Studs @ 16' O.C.
- Existing Wall

Floor Material Designations

- C. Tile : Ceramic Tile
- Conc : Sealed Concrete
- Cpt : Carpet
- Rubber : Nora NP VIVA 1308 - "VITA" with accent
squares. Pattern to be supplied at a later
date.
- Sprt Flr : Rubber Sport Flooring supplied by
Club Resource Group: (408) 354- 4133
- VCT : Vinyl Composition Tile
- Vinyl : Sheet Vinyl Flooring

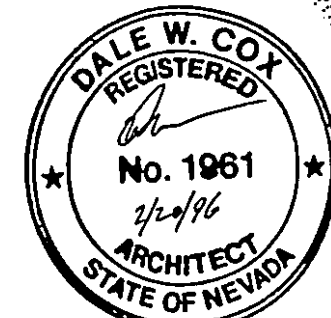

24 HOUR NAUTILUS
RENO 1
SKY MOUNTAIN DRIVE
RENO, NEVADA

COX & KROMYDAS
A.R.C.H.I.T.E.C.T.S


POST OFFICE BOX 459
TRUCKEE, CA 96160


(916) 587-6757
(916) 581-4422
FAX (916) 587-2138

THESE DRAWINGS HAVE BEEN PREPARED BY COX & KROMYDAS ARCHITECTS
FOR THE 24 HOUR NAUTILUS PROJECT.
THEY ARE NOT SUITABLE FOR USE ON OTHER PROJECTS, IN OTHER LOCATIONS,
OR BY ANY OTHER INDIVIDUALS WITHOUT THE WRITTEN APPROVAL AND
PARTICIPATION OF COX & KROMYDAS ARCHITECTS.
REPRODUCTION IS PROHIBITED. ©


REVISIONS	DRAWN BY	JLS
DATE	02.20.98	
SCALE:	1/4" = 1'-0"	
JOB NO.	9604	

A3.1r

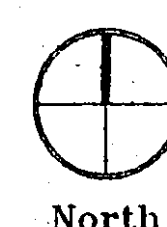


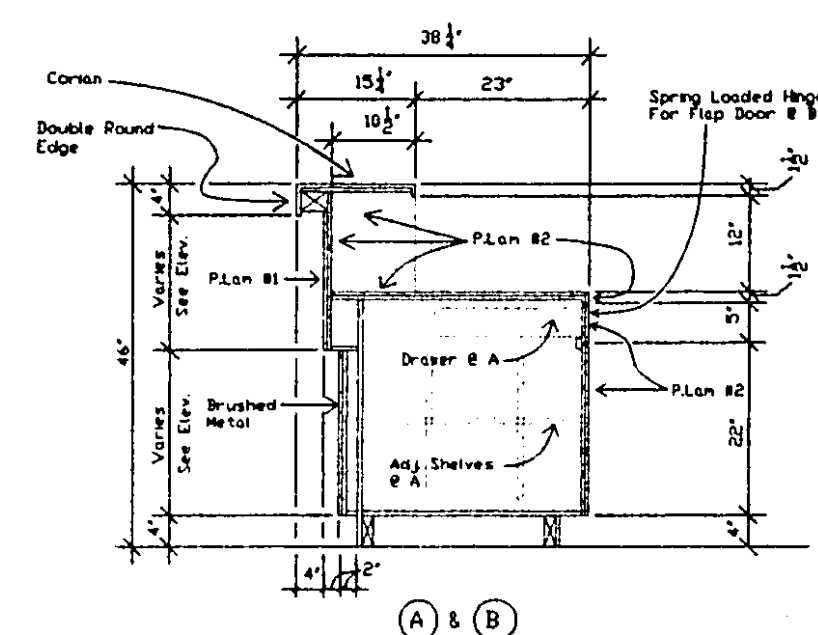


3 Front Desk Section
1/2" = 1'-0"

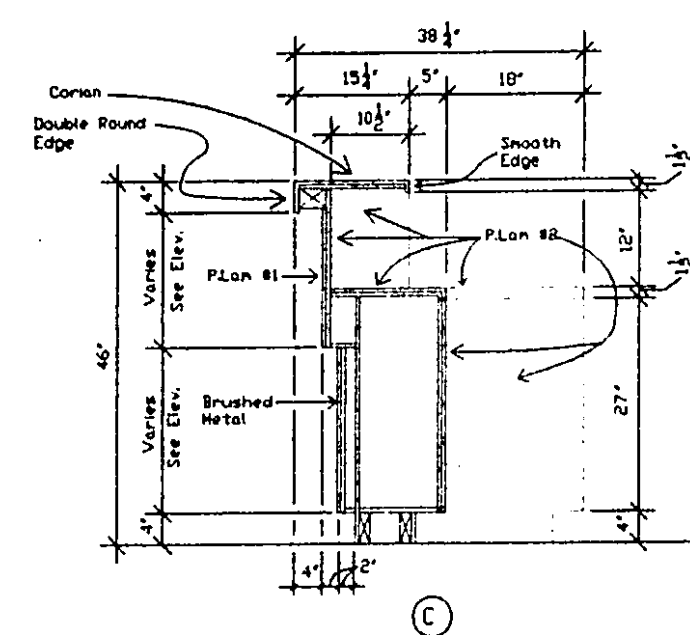


4 Front Desk Section
1/2" = 1'-0"

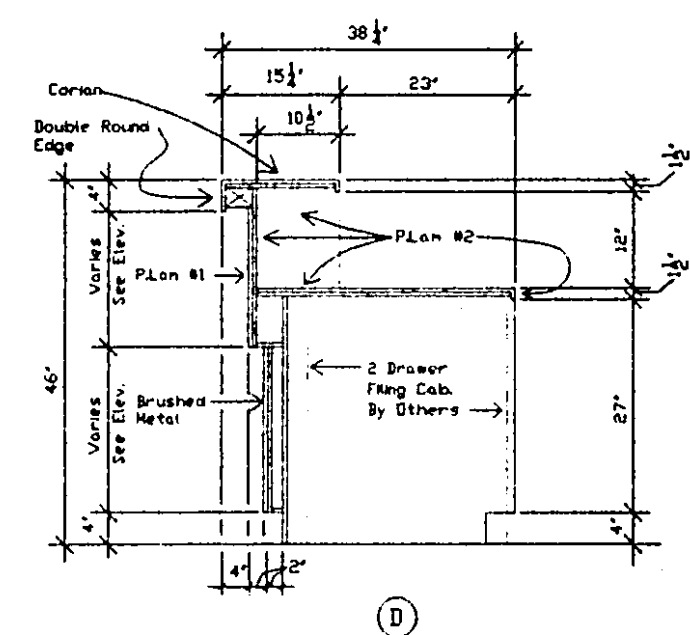


5 Front Desk Section
1/2" = 1'-0"

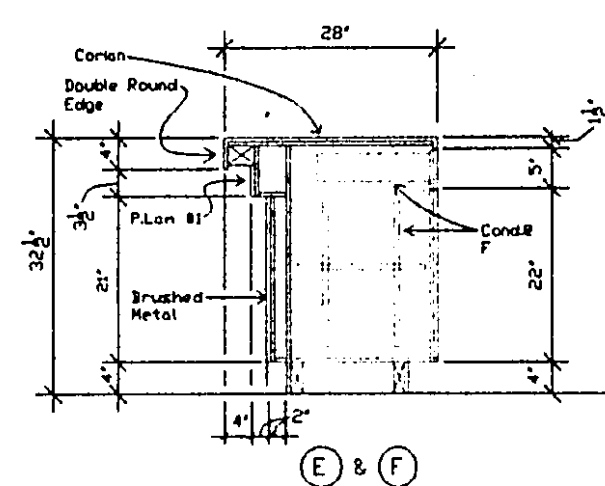


6 Front Desk Section
1/2" = 1'-0"

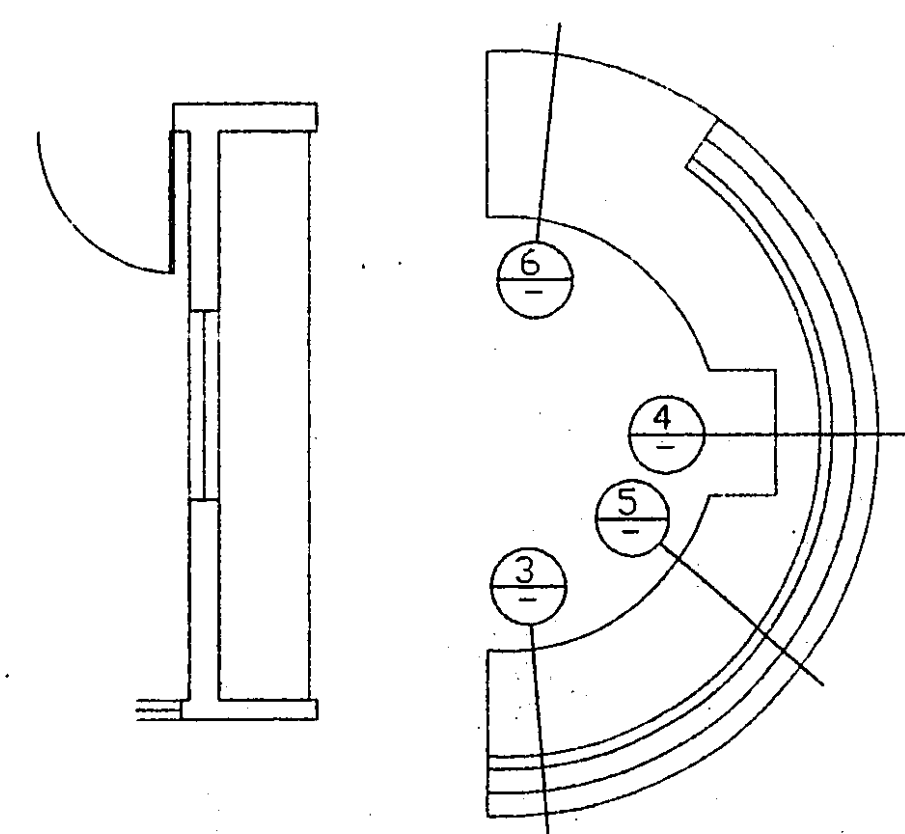

1 Front Desk Plan
1/4" = 1'-0"

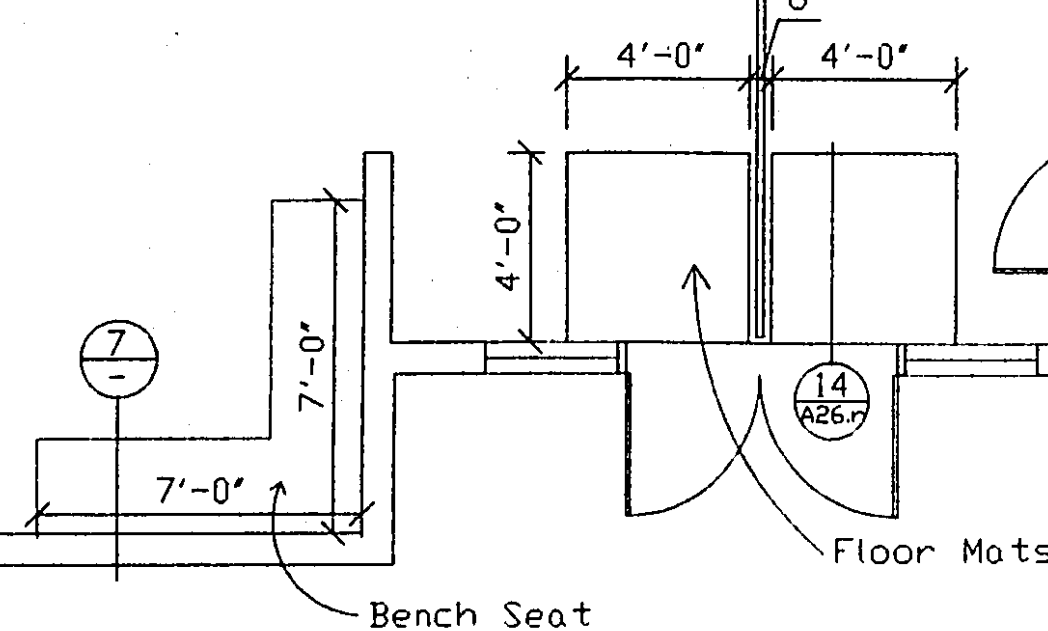

7 BENCH SECTION
1/2" = 1'-0"

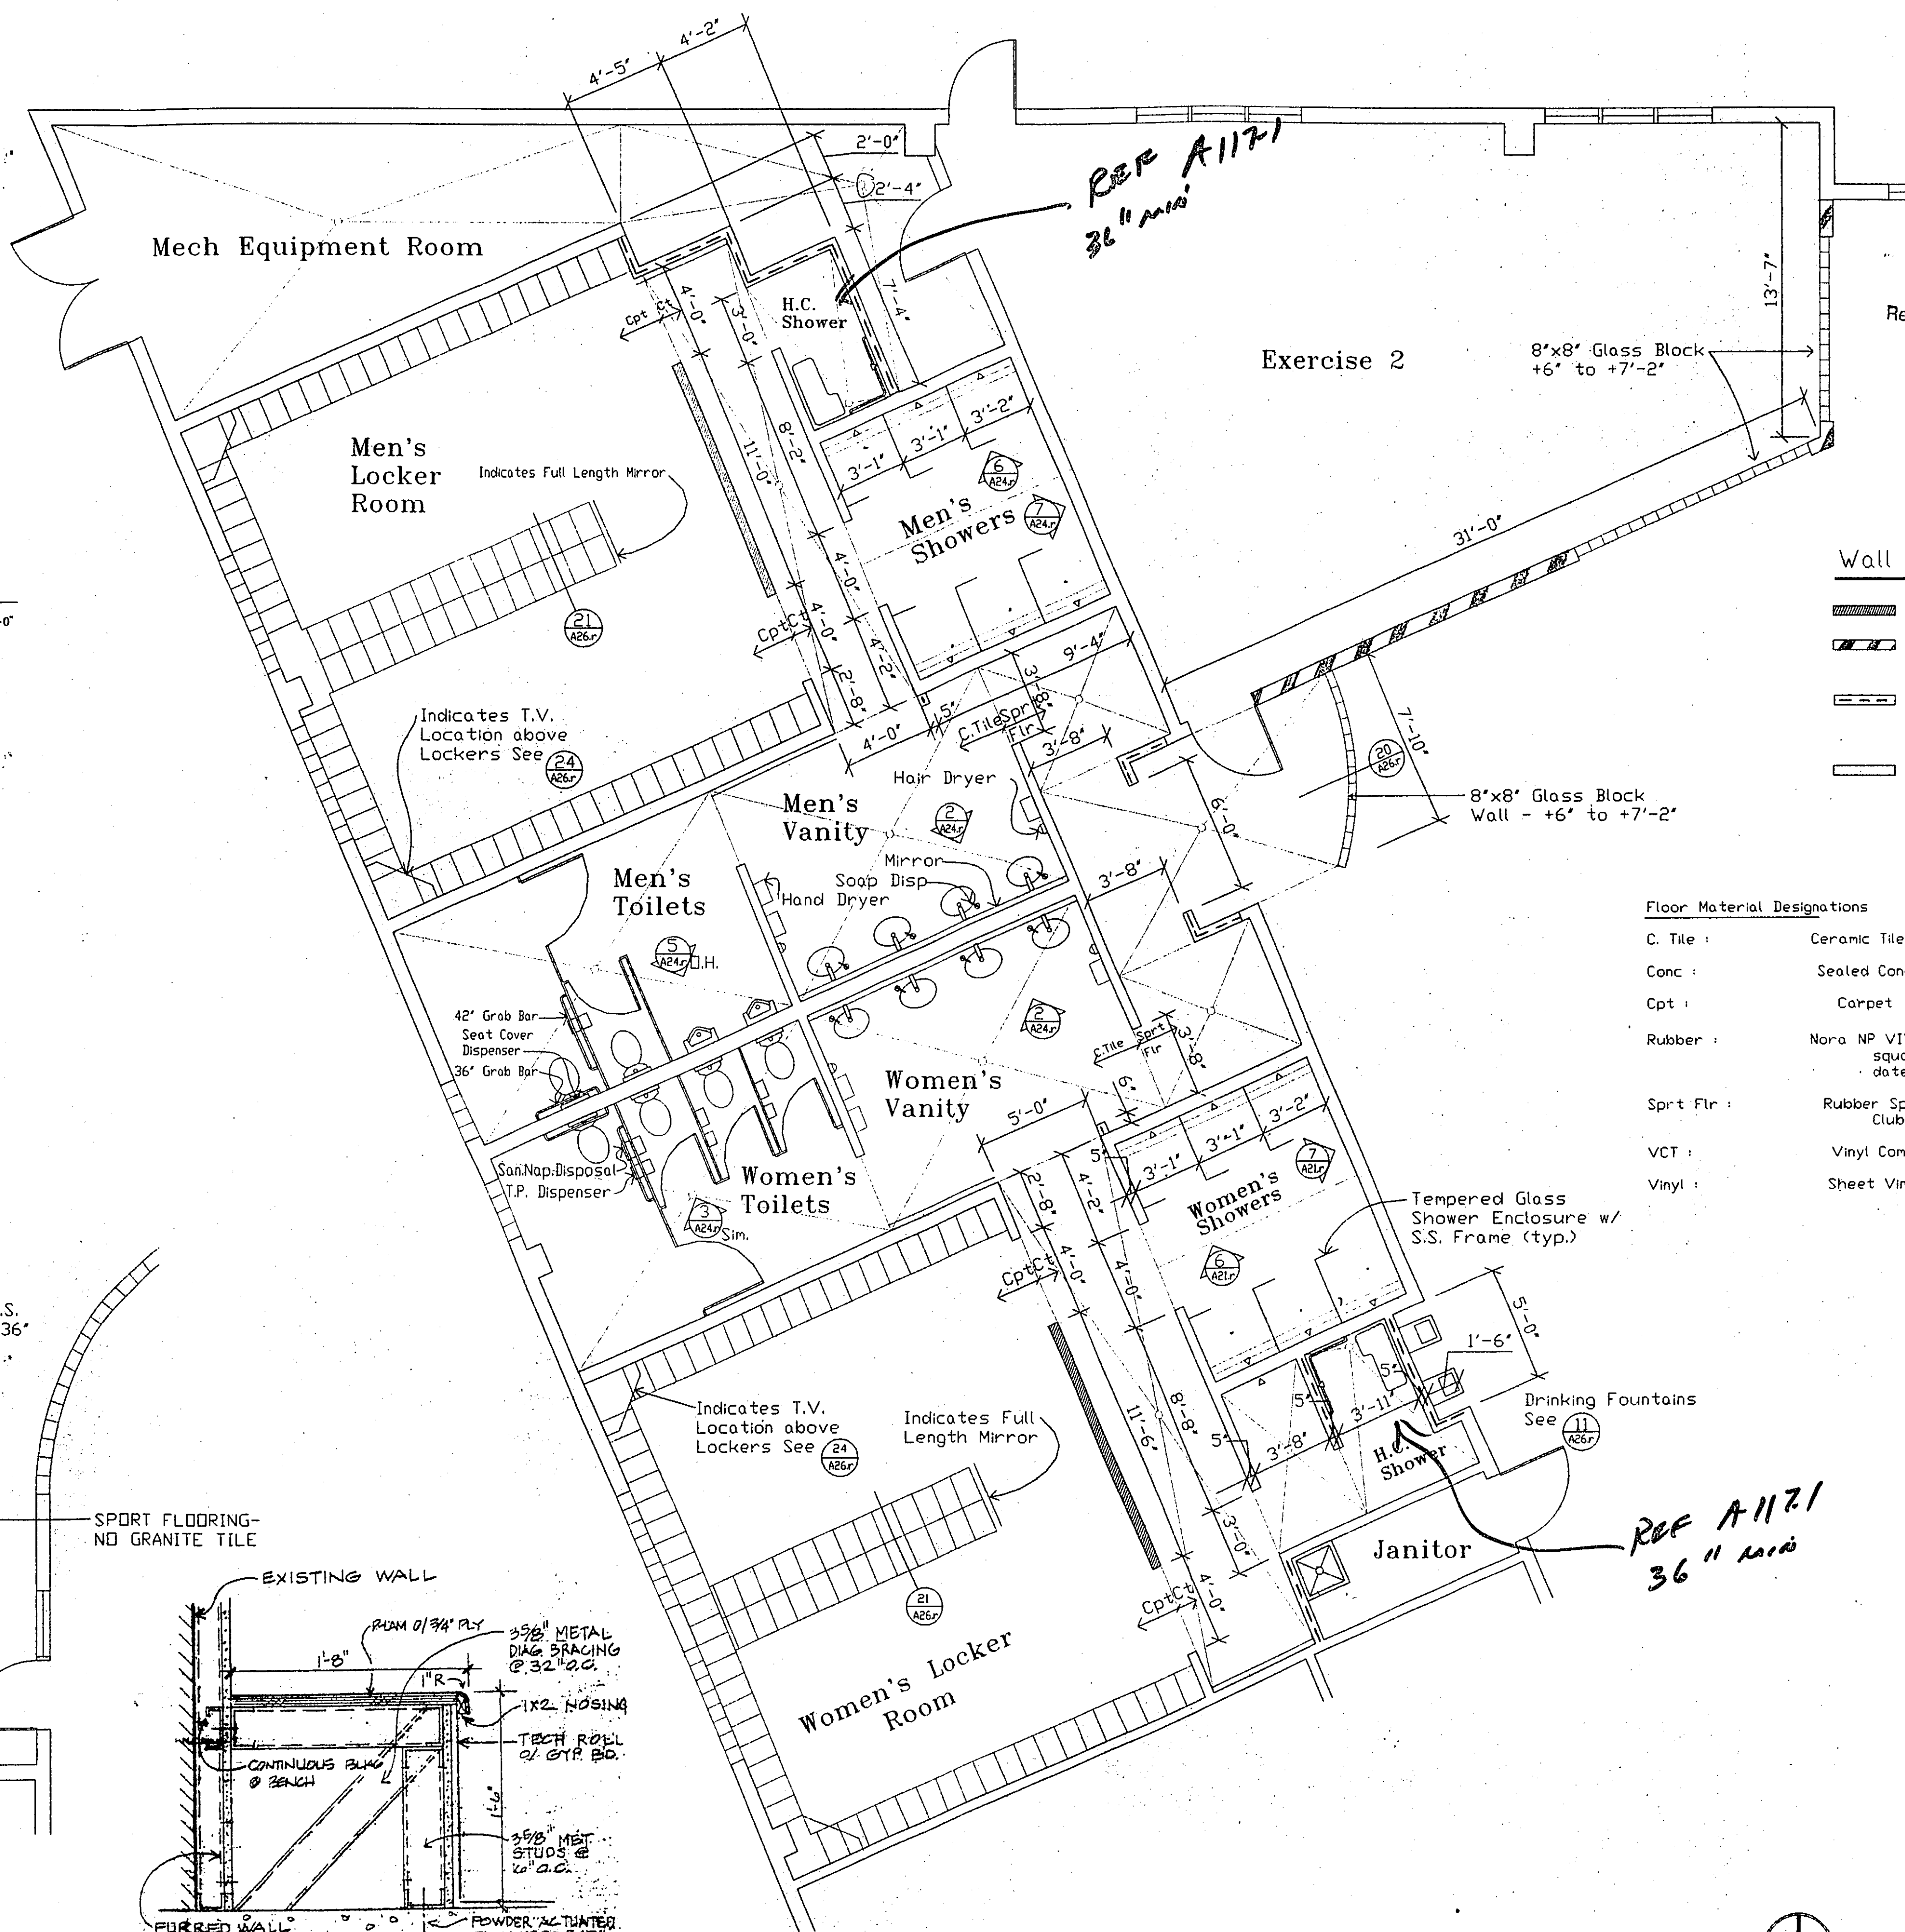

2 Locker Room Plan
1/4" = 1'-0"


Glass & Glazing
Shall Conform With
Requirements Chap. 24 U.B.C.

Wall Legend

- 3 5/8" Metal Studs @ 16" O.C.
- 6" Metal Studs @ 16" O.C.
(To Structure)
- 2 X 4 Pressure Treated and
Fire Retardant Treated
Studs @ 16" O.C.
- Existing Wall

Floor Material Designations

- C. Tile : Ceramic Tile
- Conc : Sealed Concrete
- Cpt : Carpet
- Rubber : Nora NP VIVA 1308 - 'VITA' with accent
squares. Pattern to be supplied at a later
date.
- Sprt Flr : Rubber Sport Flooring supplied by
Club Resource Group: (408) 354- 4133
- VCT : Vinyl Composition Tile
- Vinyl : Sheet Vinyl Flooring

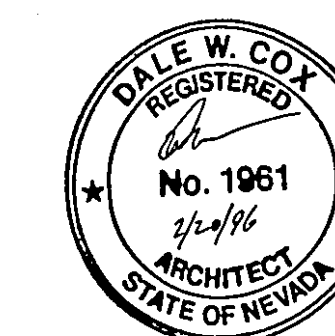

24 HOUR NAUTILUS
RENO 1
SKY MOUNTAIN DRIVE
RENO, NEVADA

COX & KROMYDAS
A.R.C.H.I.T.E.C.T.S


POST OFFICE BOX 459
TRUCKEE, CA 96160

(916) 587-6757
(916) 581-4422
FAX (916) 587-2136

THESE DRAWINGS HAVE BEEN PREPARED BY COX & KROMYDAS ARCHITECTS FOR THE 24 HOUR NAUTILUS PROJECT. THEY ARE NOT SUITABLE FOR USE ON OTHER PROJECTS, IN OTHER LOCATIONS, OR BY ANY OTHER INDIVIDUALS WITHOUT THE WRITTEN APPROVAL AND PARTICIPATION OF COX & KROMYDAS ARCHITECTS. REPRODUCTION IS PROHIBITED. ©

REVISIONS	DRAWN BY	JLS
DATE	02.20.96	
SCALE:	1/4" = 1'-0"	
JOB NO.	9604	

A3.1r

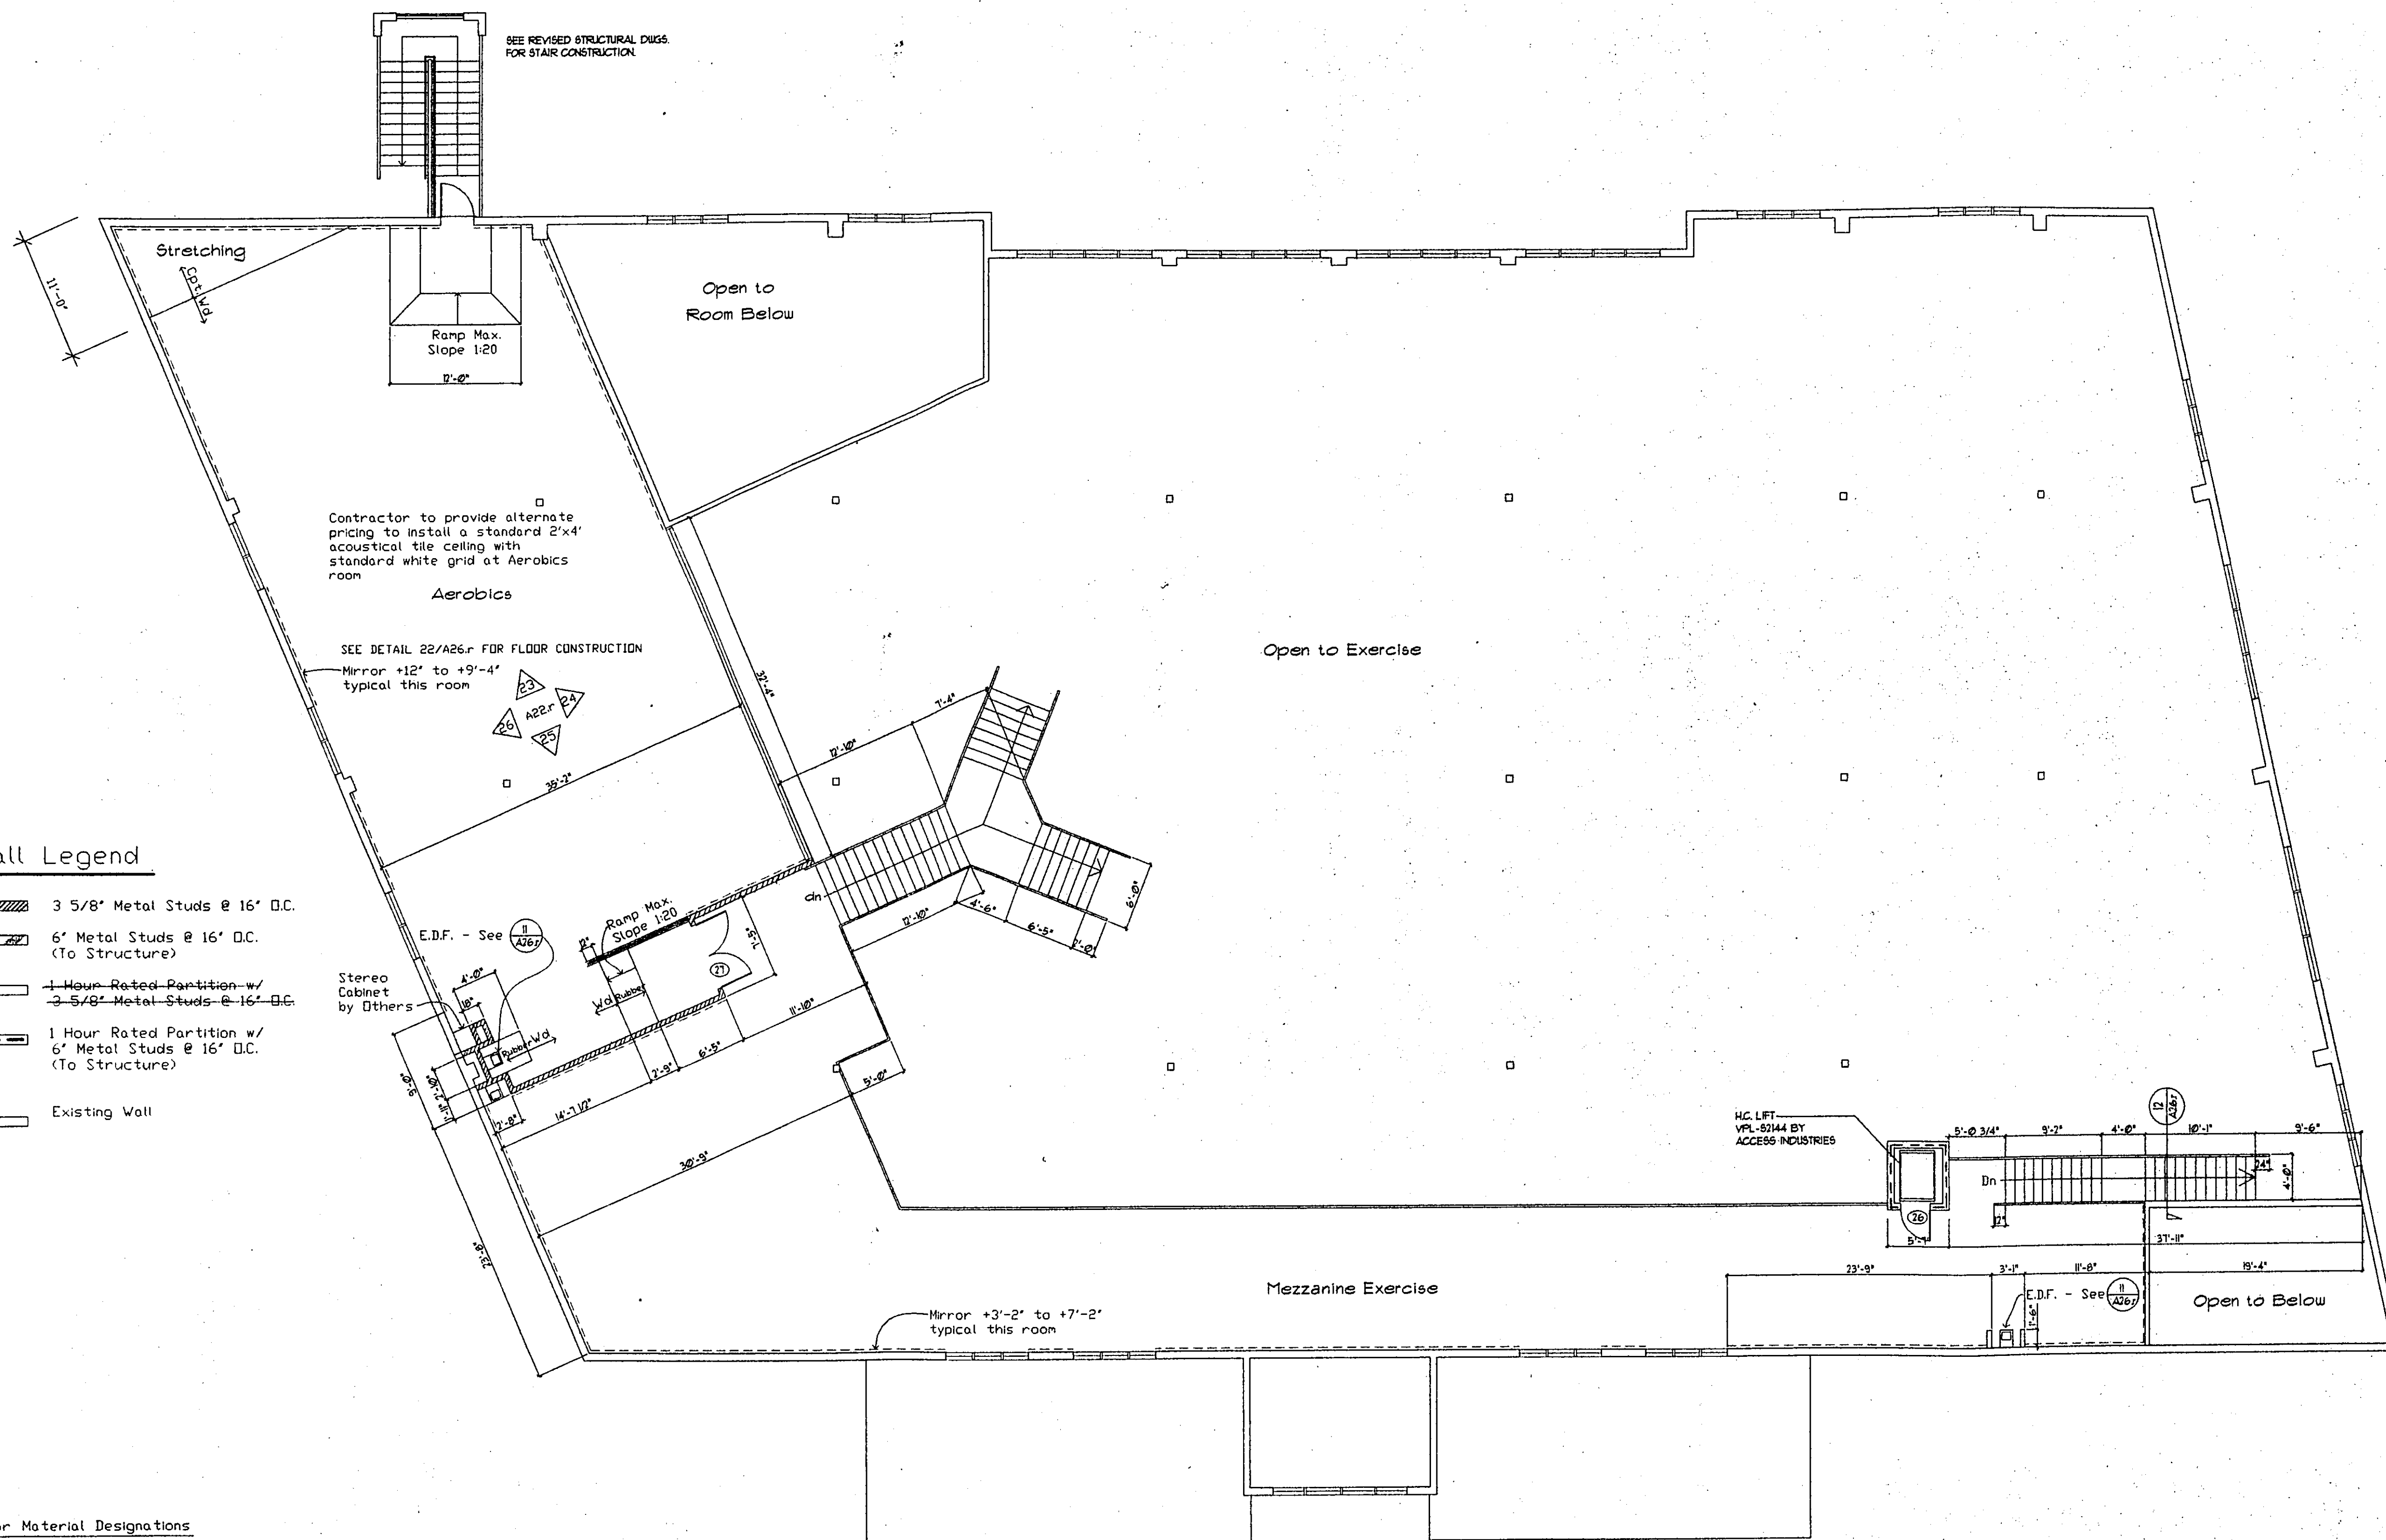

Wall Legend


- 3 5/8" Metal Studs @ 16" O.C.
- 6" Metal Studs @ 16" O.C. (To Structure)
- 1 Hour Rated Partition w/ 3 5/8" Metal Studs @ 16" O.C.
- 1 Hour Rated Partition w/ 6" Metal Studs @ 16" O.C. (To Structure)
- Existing Wall

Floor Material Designations


- C. Tile : Ceramic Tile
- Conc : Sealed Concrete
- Cpt : Carpet
- Hrd.Wd : Hardwood
- Rubber : Nora NP VIVA 1308 - "VITA" with accent squares. Pattern to be supplied at a later date.
- Sprt Flr : Rubber Sport Flooring supplied by Club Resource Group: (408) 354- 4133
- VCT : Vinyl Composition Tile
- Vinyl : Sheet Vinyl Flooring

Mezzanine Plan

1/8" = 1'-0"

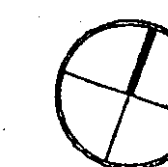

NORTH

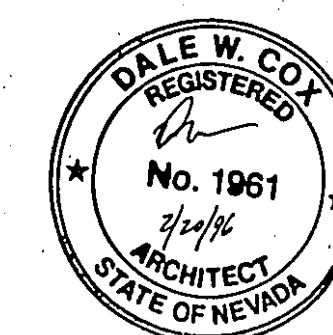

24 HOUR NAUTILUS
RENO 1
SKY MOUNTAIN DRIVE
RENO, NEVADA


COX & KROMYDAS
A.R.C.H.I.T.E.C.T.S

POST OFFICE BOX 459
TRUCKEE, CA 96160


(916) 587-6757
(916) 581-4422
FAX(916)587-2138

THESE DRAWINGS HAVE BEEN PREPARED BY COX & KROMYDAS ARCHITECTS FOR THE 24 HOUR NAUTILUS PROJECT. THEY ARE NOT SUITABLE FOR USE ON OTHER PROJECTS IN OTHER LOCATIONS, OR BY ANY OTHER INDIVIDUALS WITHOUT THE WRITTEN APPROVAL AND PARTICIPATION OF COX & KROMYDAS ARCHITECTS. REPRODUCTION IS PROHIBITED.


REVISIONS	DRAWN BY	JLS
DATE	02.20.96	
SCALE	1/8"=1'-0"	
JOB NO.	9604	
A4.r		

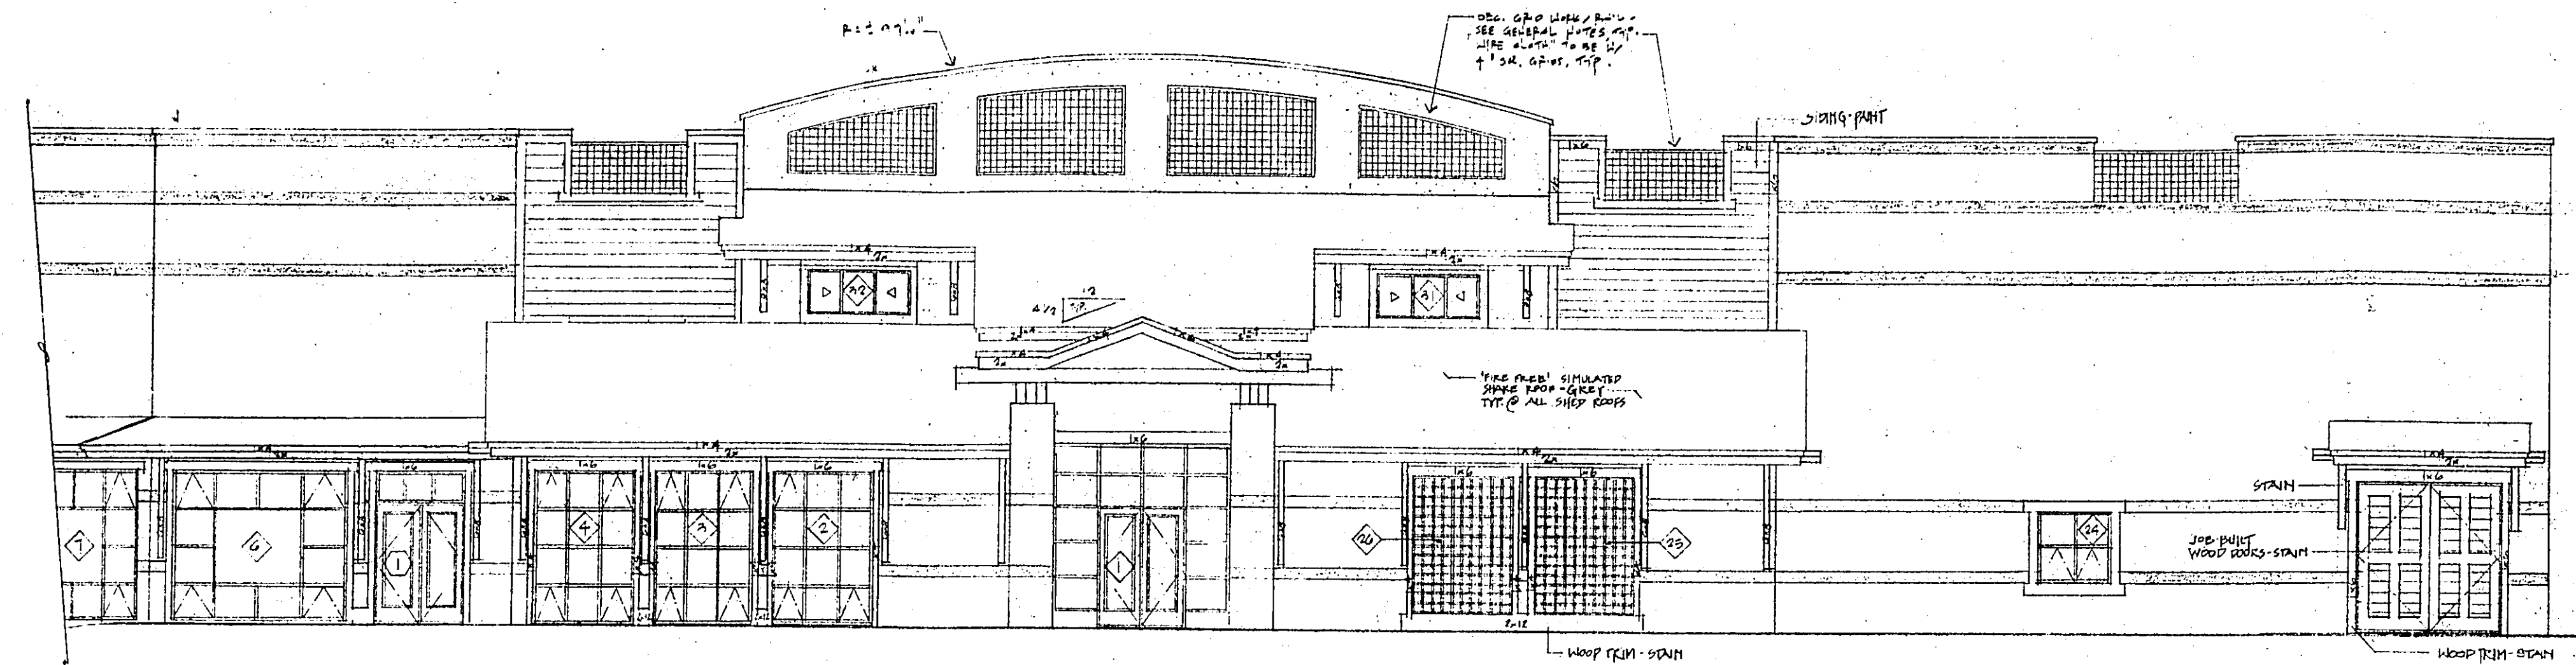

SOUTH ELEVATION
SCALE: 1/8" = 1'-0"

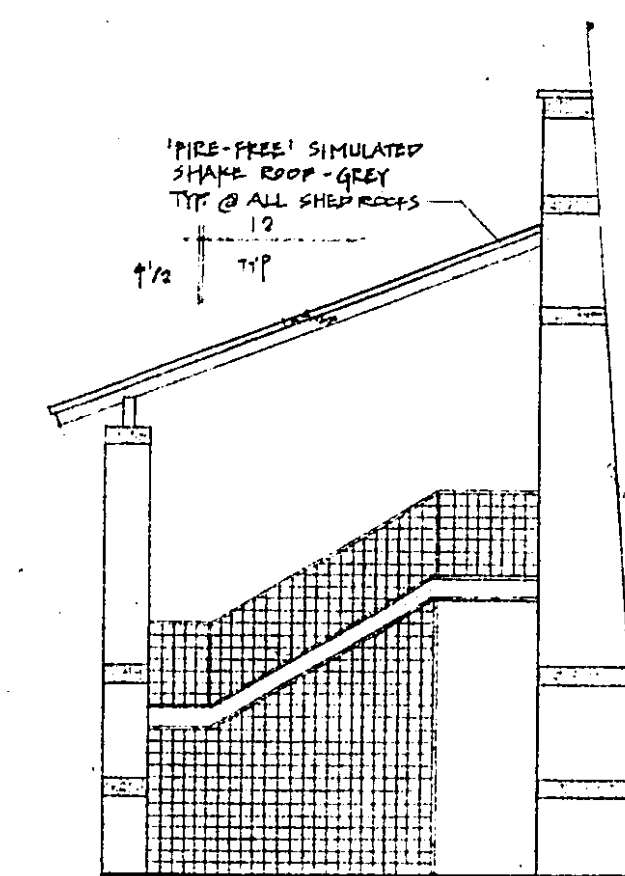


WEST ELEVATION
SCALE: 1/8" = 1'-0"

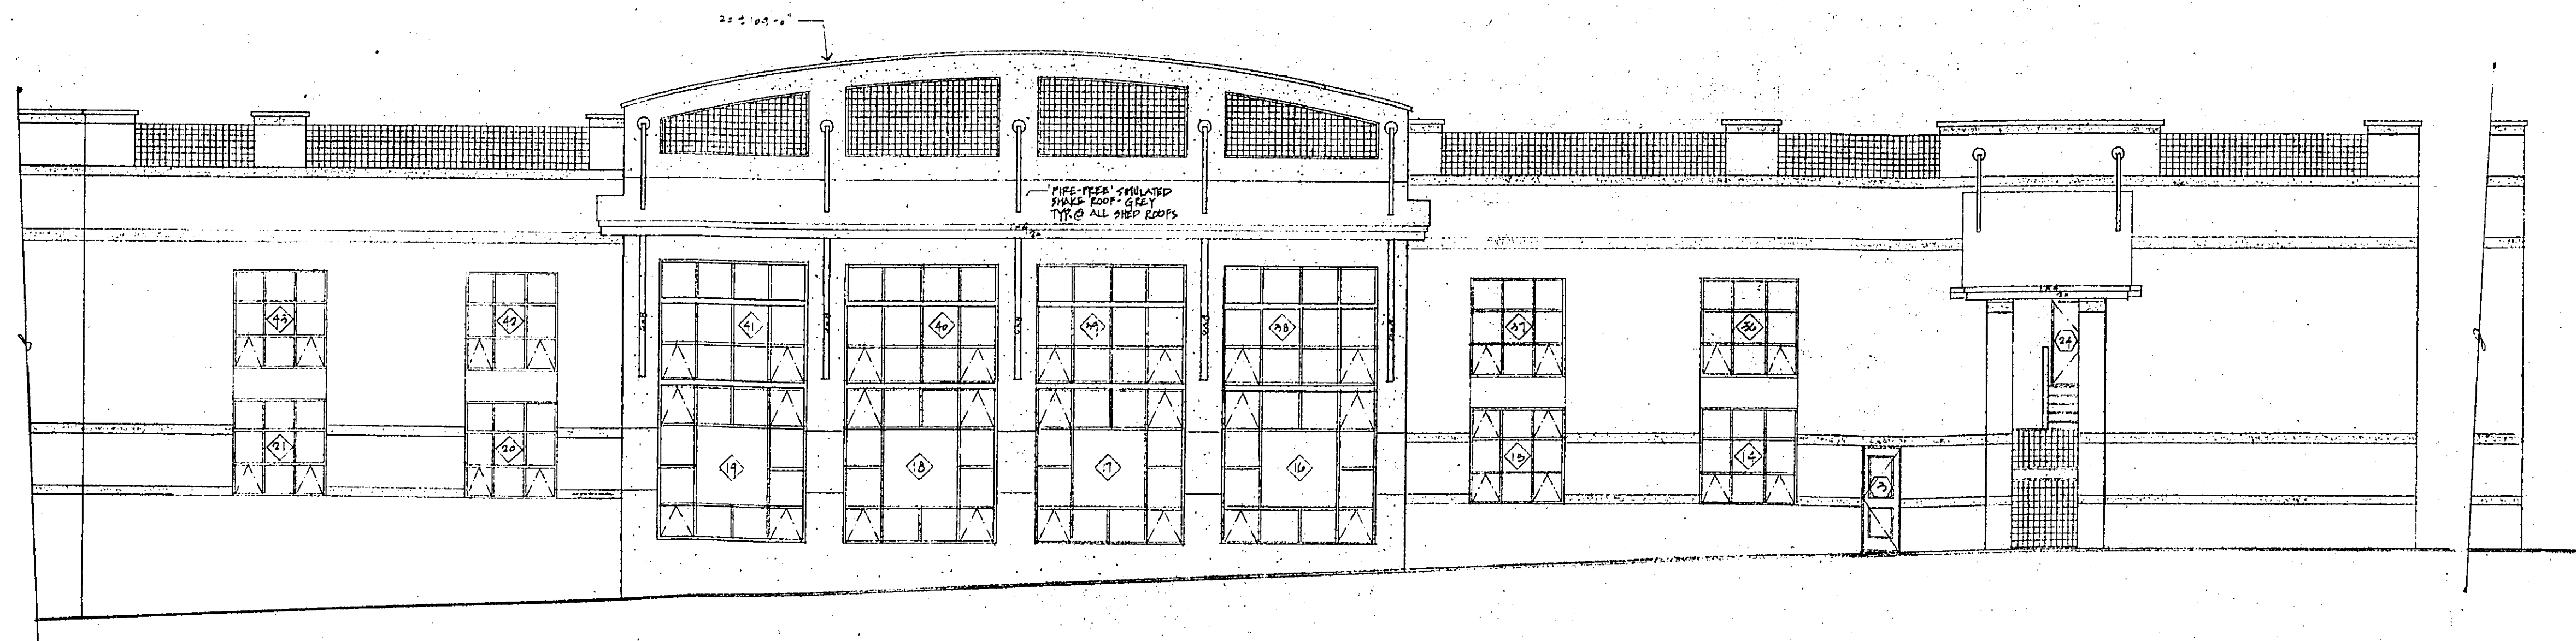

NORTH ELEVATION
SCALE: 1/8" = 1'-0"

- GENERAL EXTERIOR FINISH NOTES**
- The exterior walls to be split face C.M.U. "Natural" Basalt split face block. Provide one course #102 sump Basalt C.M.U. block @ +/- 4', 8', 24', 28', & 32' off F.F. (shown shaded). Verify exact location w/Architect.
 - The exterior "stucco" siding shall be "Dryvit". Provide "Dryvit" 100% acrylic-based "Santablast" finish. Install over "Dryvit" reinforced base coat. Install per manufacturer's specs., typ. Color "Pittsburgh Paint" #3610 Poplar. Submit sample and shop drawing details prior to construction.
 - All exposed wood structural members shall be stained w/2 coats of "Pittsburgh Paint" semi-transparent stain #51-23 "Driftwood". Submit sample prior to construction.
 - All railings, wire fabric, and decorative metal shall be primed & painted w/2 coats. Submit sample. "Pittsburgh Paint" #4004 Cactus.
 - The "flat" roof finish shall be "U.S. Intec" - "Bral/Flx". Class A roof. Continue "flat" roof up backside of parapets. Provide "Bral/Flx" base sheets, plys, membranes, joint strips, flashings & counter flashings as required. Install per manufacturer's specs. "Sloped" roof finishes to be "Pittsburgh Paint" #3610 Poplar. Submit sample and shop drawing details prior to construction. Color to be "Coastal Gray".
 - All windows and storefronts shall be "Kawneer" with thermal break or equal with anodized aluminum frames. Aqua in color. See window schedule for additional notes & information. Provide screens at all operational locations. Provide end blocks at all heads, jombs, and sills.
 - All exterior doors shall be metal insulated doors. See door schedule for add. notes & information. All doors & frames shall be primed & painted w/2 coats. Color to be "Pittsburgh Paint" #4004 Cactus.
 - All exposed metal flashings, etc. shall be cleaned, primed & painted to match adjacent color.
 - See roof plan for typical gutter specification and notes. Gutters and downspouts shall be installed at perimeter roof lines of the building in the locations shown.
 - Verify all finishes on all materials w/Architect prior to any staining, painting, or ordering. Provide samples of all finish material together for approval by Architect.

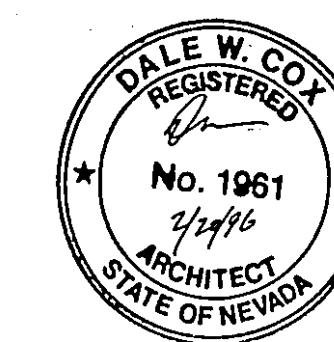

REVISIONS		
8-1-94	DEZ	
2-10-96	JLS	

24 HOUR NAUTILUS
RENO 1
SKY MOUNTAIN DRIVE
RENO, NEVADA


COX & KROMYDAS
A.R.C.H.I.T.E.C.T.S

POST OFFICE BOX 459
TRUCKEE, CA 96160


(916) 587-0757
(916) 581-4422
FAX (916) 587-2138

DRAWN	DEZ	SHEET
DATE	3/4/94	A9.R
SCALE	1/8" = 1'-0"	
JOB NO.	9222	

NO EXTERIOR WORK
THIS PERMIT

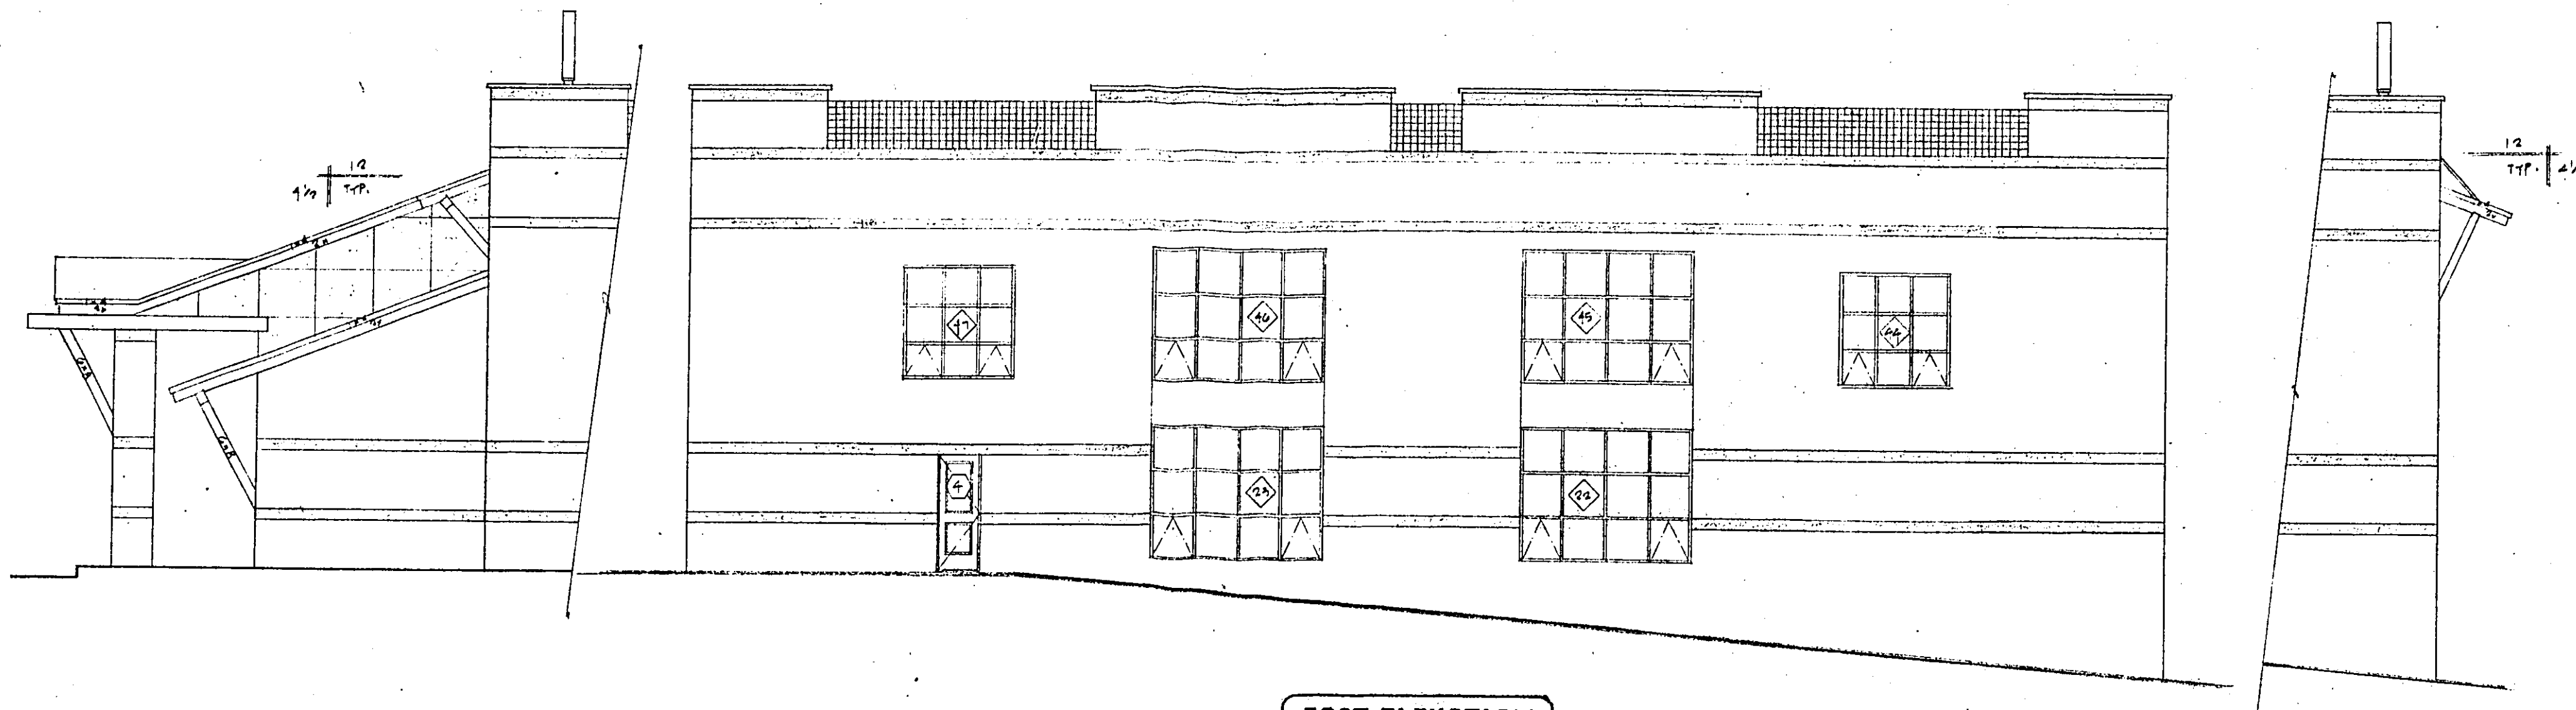

EAST ELEVATION
SCALE: 1/8" = 1'-0"

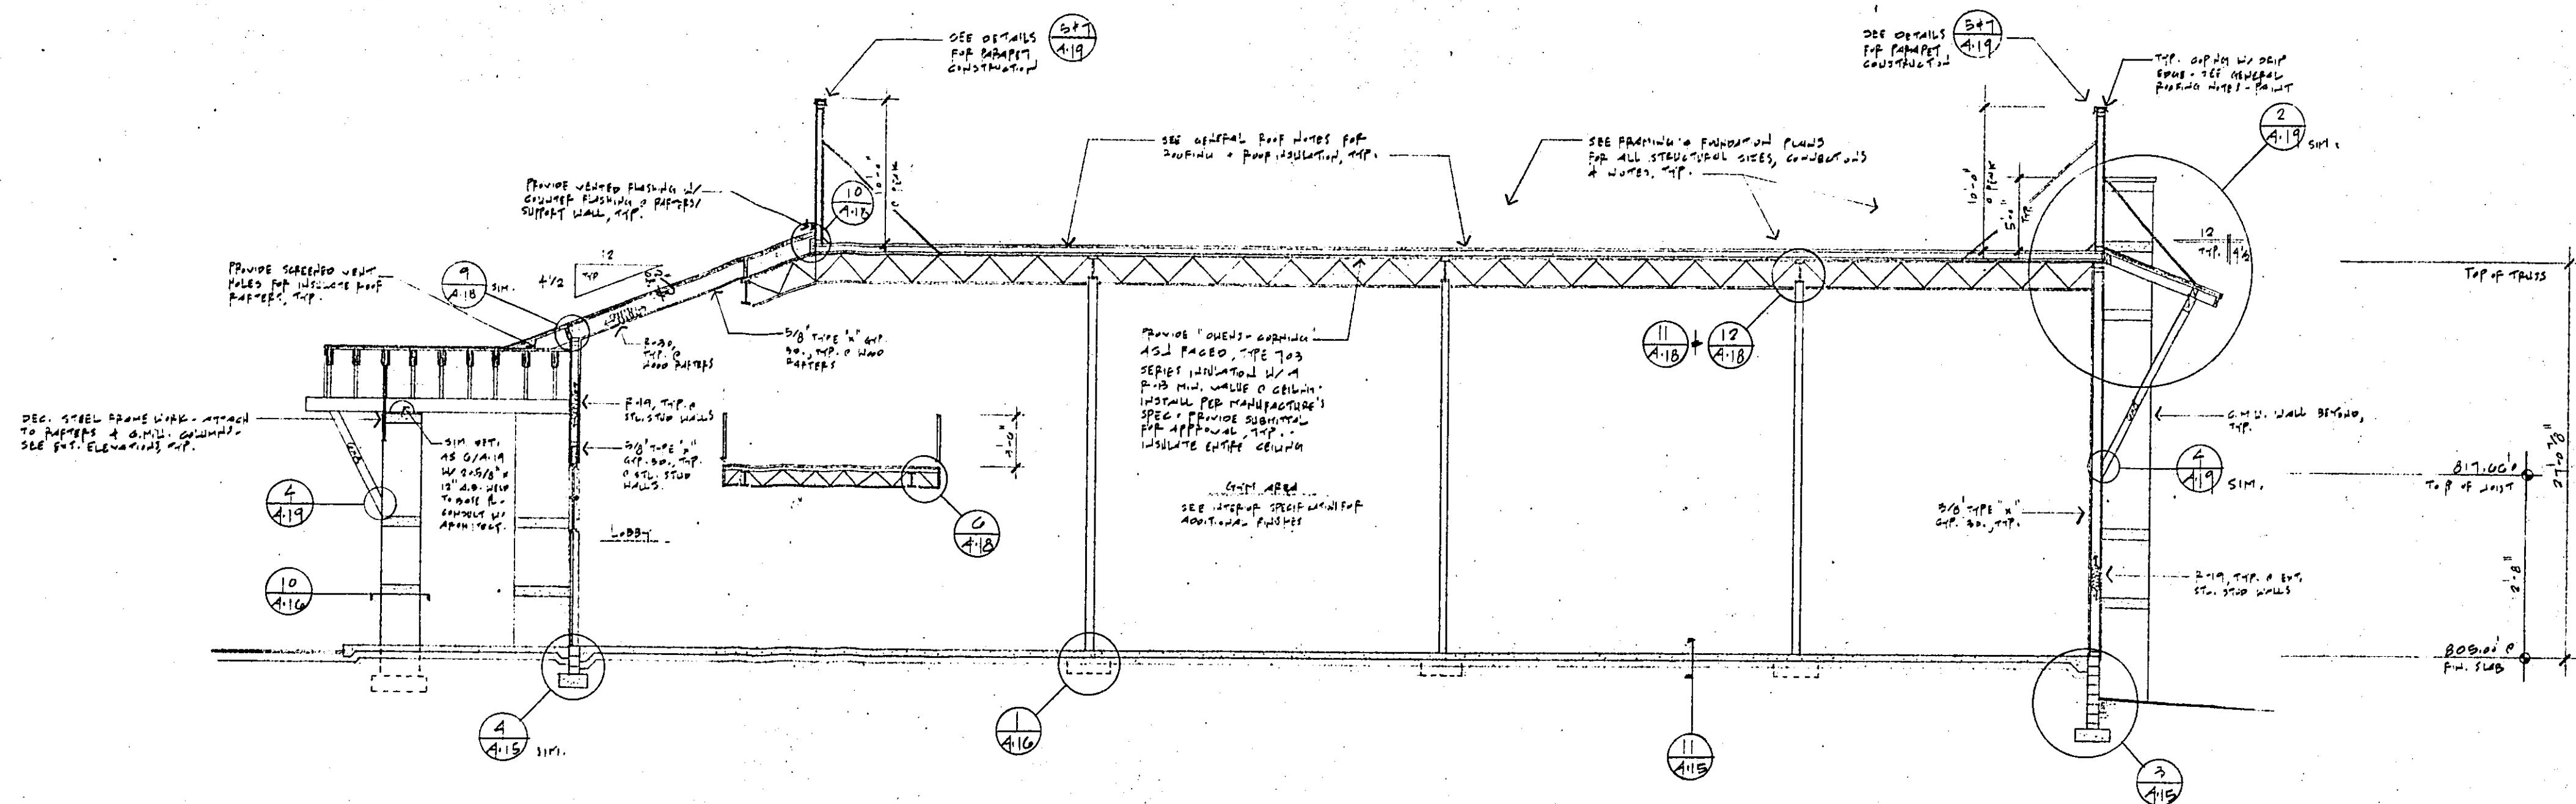

SECTION 2-2
SCALE: 1/8" = 1'-0"


- GENERAL EXTERIOR FINISH NOTES**
- The exterior walls to be split face C.M.U. "Natural" Basalt split face block. Provide one course #102 sump Basalt C.M.U. block @ +/- 4', 8', 24', 28', & 32' off F.F. (shown shaded). Verify exact location w/Architect.
 - The exterior "stucco" siding shall be "Dryvit". Provide "Dryvit" 100% acrylic-based "Sandblast" finish. Install over "Dryvit" reinforced base coat. Install per manufacturer's specs. typ. Color "Pittsburgh Paint" #3610 Poplar. Submit sample and shop drawing details prior to construction.
 - All exposed wood structural members shall be stained w/2 coats of "Pittsburgh Paint" semi-transparent stain #ST-23 "Driftwood". Submit sample prior to construction.
 - All railings, wire fabric, and decorative metal shall be primed & painted w/2 coats. Submit sample. "Pittsburgh Paint" #4004 Cactus.
 - The "flat" roof finish shall be "U.S. Intec" - "Bral/Flex". Class A roof. Continue "Bral" roof up backside of parapets. Provide "Bral/Flex" base sheets, plys, membranes, cant strips, flashings & counter flashings as required. Install per manufacturer specs. "Sloped" roof finishes to be "Firefree" Rustic Shake roofing. Install per manufacturer's specs. Color to be "Cocotal Gray".
 - All windows and storefronts shall be "Kawneer" with thermal break or equal with anodized aluminum frames. Aqua in color. See window schedule for additional notes & information. Provide screens at all operational locations. Provide and block at all heads, jams, and sills.
 - All exterior doors shall be metal insulated doors. See door schedule for add. notes & information. All doors & frames shall be primed & painted w/2 coats. Color to be "Pittsburgh Paint" #4004 Cactus.
 - All exposed metal flashings, etc. shall be cleaned, primed & painted to match adjacent color.
 - See roof plan for typical gutter specification and notes. Gutters and downspouts shall be installed at perimeter roof lines of the building in the locations shown.
 - Verify all finishes on all materials w/Architect prior to any staining, painting, or ordering. Provide samples of all finish material together for approval by Architect.

NO EXTERIOR WORK
THIS PERMIT

LIST OF SPECIFICATIONS - OLD'S OWN

- Pro Shop and Reception Area**
Flooring: Atlas Stonebridge, 3815 Wooded Glen, DuPont
Carpet: Antron Legacy Nylon, 12' wide
Vinyl Composition Tile: Armstrong, Imperial Texture, 31515 Charcoal, 12" x 12", Gauge 1/8", SD-7-3128(1), Type IV, Composition 1
Base: Burke, 701P Black, Top Set Rubber Base
- Wall Treatments:**
Stair Wall (Pro Shop) - 6" O.C., Wilsonart, Black, 1535-6, with heavy duty silver metal inserts, 4" x 8" sheets (to be installed to 12" to match height of black wall in reception area)
Paint: Ameritone, Interior/Exterior, Black - Satin Finish (for "log" wall behind reception desk)
Ameritone, 2940D Jaguar (for walls in waiting area, entry and wall space above 12' wall - Ameritone, 2940D Pussywillow Gray (window and door trim)
Ameritone, 2940D Cloverweest (ceiling)
- Reception Desk (Refer to Elevation Drawing):**
Laminates - Nevamar, ARP Surface, Blowing Test, 9-3-377 Textured (face of cabinet), Nevamar, Pure Metal, 9M-3 Brushed Chrome Band, between face and counter top and Wilsonart, Antique Leather 2929-6 (countertop)
Base - Burke, 701P - Black
- Refrigerated Back Counter:** Superior Products Manufacturing Company, 2-V-369 True Back Bar Cooler with Glass Doors, 70-3/8" W x 27 1/2" D x 35-3/4" H. Back counter should be built as shown on the floor plan. Cooler to be set in under counter top.
Laminates - Wilsonart 1535-6 Black (face and sides)
Wilsonart 2929-6 Antique Leather (countertop)
- Door to Storage Area in Pro Shop - Face with 1/4" mirror with safety backing and secured with 3 solid in satin aluminum finish**
- Door Hardware: Silver/Chrome Finish**
- Display Products:** Ralph Jones Display, Clothing Racks and Display Wall Accessories:
- R301/B Double center floor rack, Qty = 1
- RT6/B Top Shelf, Qty = 1
- RT7/B Interior Shelves, Qty = 3
- RT12/B 12" Face Out, Qty = 1
- RT12/B End Shelves, Qty = 2
- R307/B 36" Tower Ladder, Qty = 1
- RT12/B 12" Facetout, Qty = 1
- RT12/B 12" Facetout, 7 cubes, Qty = 3
- RT12/B 12" Facetout, 15", Qty = 3
- RT12/B 12" Facetout, 15", Qty = 4
- 1" Round Tubing
- Chromes or black finish on all products.**
Display products listed above are suggestions only. Retail inventory display requirements should be considered before purchasing.
- Window Coverings:** Levelor, Riviera, 1" Aluminum Mini Blinds, 34 Brushed Aluminum
Signage: Metal Cut Letters, Brushed Aluminum, "Gold's Gym" logo letter style to be used, letters to be approximately 8" tall and 1" thick, mounted with a 1/2" extension (gap) from the wall
- Dym/Weights Area**
Flooring: Vinyl Composition Tile - Armstrong, Imperial Texture, 31515 Charcoal, 12" x 12", Gauge 1/8", SD-7-3128(1), Type IV, Composition 1
Rubber Gym Floor - Tufflex, 3/8", Resilient Rubber Flooring, 4913 Grey, Base: Burke, Rubber Base, 701P Black
Logo - "G" to be painted in the center of the weight area (please see drawing), Paint as recommended by Tufflex Manufacturer
- Paints:**
- Ameritone, 2940D Jaguar (main wall color and to be used for metal frames on existing equipment)
- Ameritone, 2940D Pussywillow Gray (window and door trim)
- Ameritone, 2940D Cloverweest (ceiling)
- Notes:** Mechanical/Duct paint yet to be determined.
Powder Coat Finish for Railings: Tiger, Drylac, RAL-5020
Signage for Staff Hall: "STAFF" - 1/4" Mica/Acrylic letters, Microprisms Type Style, Brushed silver finish with matching painted edges. Staff wall to consist of framed photos and name plates of staff members. Please see floorplan for location.
- Window Coverings:** Levelor, Riviera, 1" Aluminum Mini Blinds, 817 Blue Gray
Door Hardware: Silver or Chrome Finish

- Aerobics:**
Flooring: Robbins, Sportswoodplus Ultra, 7/16" thickness (as per installer Matthew Burke), Base: Burke Rubber Base, 156P Crescent
Paints: Ameritone, 2935F Heather Beige (walls)
Ameritone, 2935P Cloverweest (ceiling)
Door Hardware: Silver or Chrome Finish
- Children's:**
Flooring: Carpet - Dimension, Blithmore 28, Color: 63109, 100S Nylon, textured level loop
Rubber Base - Burke, 323P - Blue Bonnet
Vinyl Composition Tile - Armstrong, Compagnon Square, 5197A Polychrome White (restroom, same base)
Paints: Ameritone, 2935P Cloverweest (main wall, ceiling and window mullions)
Ameritone, 2933B Sandana Blue (wall graphics)
Ameritone, 1922B Universe (wall graphic)
Notes: Door and window trim to be painted to follow wall graphics. Please see drawing.
Window Coverings: Levelor, Riviera, 1" Aluminum Mini Blinds, 817 Blue Gray
Door Hardware: Silver or Chrome Finish
- Window Treatments:** Valances, Fabric: Schumacher, Pattern #16250 NYC's, Colors Driveway, 24", 100% cotton (must be treated for fire retardancy), please see illustration
- Door Hardware and Faucets:** Silver or Chrome Finish
Notes: Storage area to have same carpet, base and 2935P Cloverweest paint
- Door Hardware:** Silver or Chrome Finish
- Men's Locker Room**
Flooring: Carpet - Atlas, Stonebridge, 3815 Wooded Glen, DuPont
Carpet: Antron Legacy Nylon, 12' wide
Tile - Dal Permatones, Matte Glazed Ceramic Mosaics, 2" x 2", 6514 Pearl Gray and 6517 Teal, (see tile design)
Grout - Hydromont, Misty Gray
Rubber Base - Burke 165P - Blush White, Premium
Countertop Laminates: Wilsonart, Palencia, 4517-6 (countertop)
- Wall Treatments:**
Wallpaper - Sinclair, 277-0432, Random Match, Single Roll = 30' wide x 5-0 yards long
Paint - Ameritone, 2940D Pussywillow Gray (trim)
Tile - Dal Permatones, Matte Glazed Ceramic Mosaics, 2" x 2", 6514 Pearl Gray and 6517 Teal (see tile design)
Grout - Hydromont, Misty Gray
- Locker Laminates:** Nevamar, ARP Surface, 5-2-521 Nude Beige
Benches: Madrian Locker Benches, 4", Powder Coat Finish
Pedestals, Color: Light Gray #533, Qty = 9
- Stall Partitions:** Madrian Floor Mounted Toilet Compartments, Powder Coat Finish - Light Gray #533
- Shower Curtains:** Clear/Semi-Transparent Vinyl Curtain
Door Hardware and Bathroom Faucets: Silver or Chrome Finish (Branded whenever possible)
- Women's Locker Room**
Flooring: Carpet - Atlas, Stonebridge, 3815 Wooded Glen, DuPont
Carpet: Antron Legacy Nylon, 12' wide
Tile - Dal Permatones, Matte Glazed Ceramic Mosaics, 2" x 2", 6514 Pearl Gray and 6517 Teal (see tile design)
Grout - Hydromont, Misty Gray
Rubber Base - Burke 165P - Blush White, Premium
Countertop Laminates: Nevamar, ARP Surface, Breccia, BR-6-17 Textured
- Wall Treatments:**
Wallpaper - Sinclair, 277-0432, Random Match, Single Roll = 30' wide x 5-0 yards long
Paint - Ameritone, 2940D Pussywillow Gray (trim)
Tile - Dal Permatones, Matte Glazed Ceramic Mosaics, 2" x 2", 6514 Pearl Gray and 6517 Teal (see tile design)
Grout - Hydromont, Misty Gray
- Locker Laminates:** Nevamar, ARP Surface, 5-2-521 Nude Beige
Benches: Madrian Locker Benches, 4", Powder Coat Finish
Pedestals, Color: Light Gray #533, Qty = 9
- Stall Partitions:** Madrian Floor Mounted Toilet Compartments, Powder Coat Finish - Light Gray #533
- Shower Curtains:** Clear/Semi-Transparent Vinyl Curtain
Door Hardware and Bathroom Faucets: Silver or Chrome Finish (Branded whenever possible)
- Sales Office (Downstairs)**
Flooring: Carpet - Dimension, Serene, 66209 Emerald, 100X C.F. Zetron Nylon, 12' wide
Rubber Base - Burke, 701P - Black
Paints: Ameritone, 2935F Heather Beige (wall, trim and ceiling)
Window Coverings: Levelor, Riviera, 1" Aluminum Mini Blinds, Color: 201 Ivory
Door Hardware: Silver or Chrome Finish
- Upstairs Office and Bathroom**
Flooring: Carpet - Dimension, Serene, 66209 Emerald
Vinyl Composition Tile: Armstrong, Premium Excelon Tile, Stonetex, 55-7-3129, #52125 Granite Gray
Rubber Base - Burke, 701P - Black
Paints: Ameritone, 2940D Pussywillow Gray (walls, trim and ceiling)
Ameritone, 2933B Sandana Blue (wall graphics)
Laminates: Wilsonart, Frosty White, 1573-6
Window Coverings: Levelor, Riviera, 1" Aluminum Mini Blinds, 817 Blue Gray
Door Hardware: Silver or Chrome Finish
- Staircases and Mezzanine**
Flooring: Carpet - Dimension, Serene, 66209 Emerald
Rubber Base - Burke, 701P - Black
Paints: Ameritone, 2940D Jaguar (walls)
Ameritone, 2940D Pussywillow Gray (trim)
Powder Coat Finish: Tiger, Drylac RAL 5020 (posts and railing)

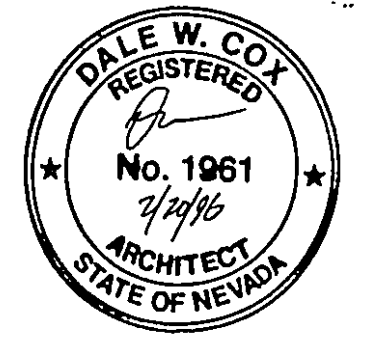











REVISIONS		
3-1-94	DEZ	
2-14-96	JLS	

24 HOUR NAUTILUS
RENO 1
SKY MOUNTAIN DRIVE
RENO, NEVADA

COX & KROMYDAS
A.R.C.H.I.T.E.C.T.S.
POST OFFICE BOX 459
TRUCKEE, CA 96160
(916) 587-0757
(916) 581-4422
FAX (916) 587-2138

DRAWN DEZ
DATE 3/4/94
SCALE 1/8" = 1'-0"
JOB NO. 9222

SHEET
A10.R

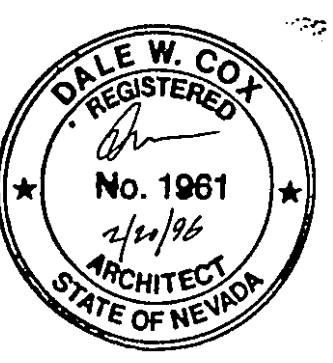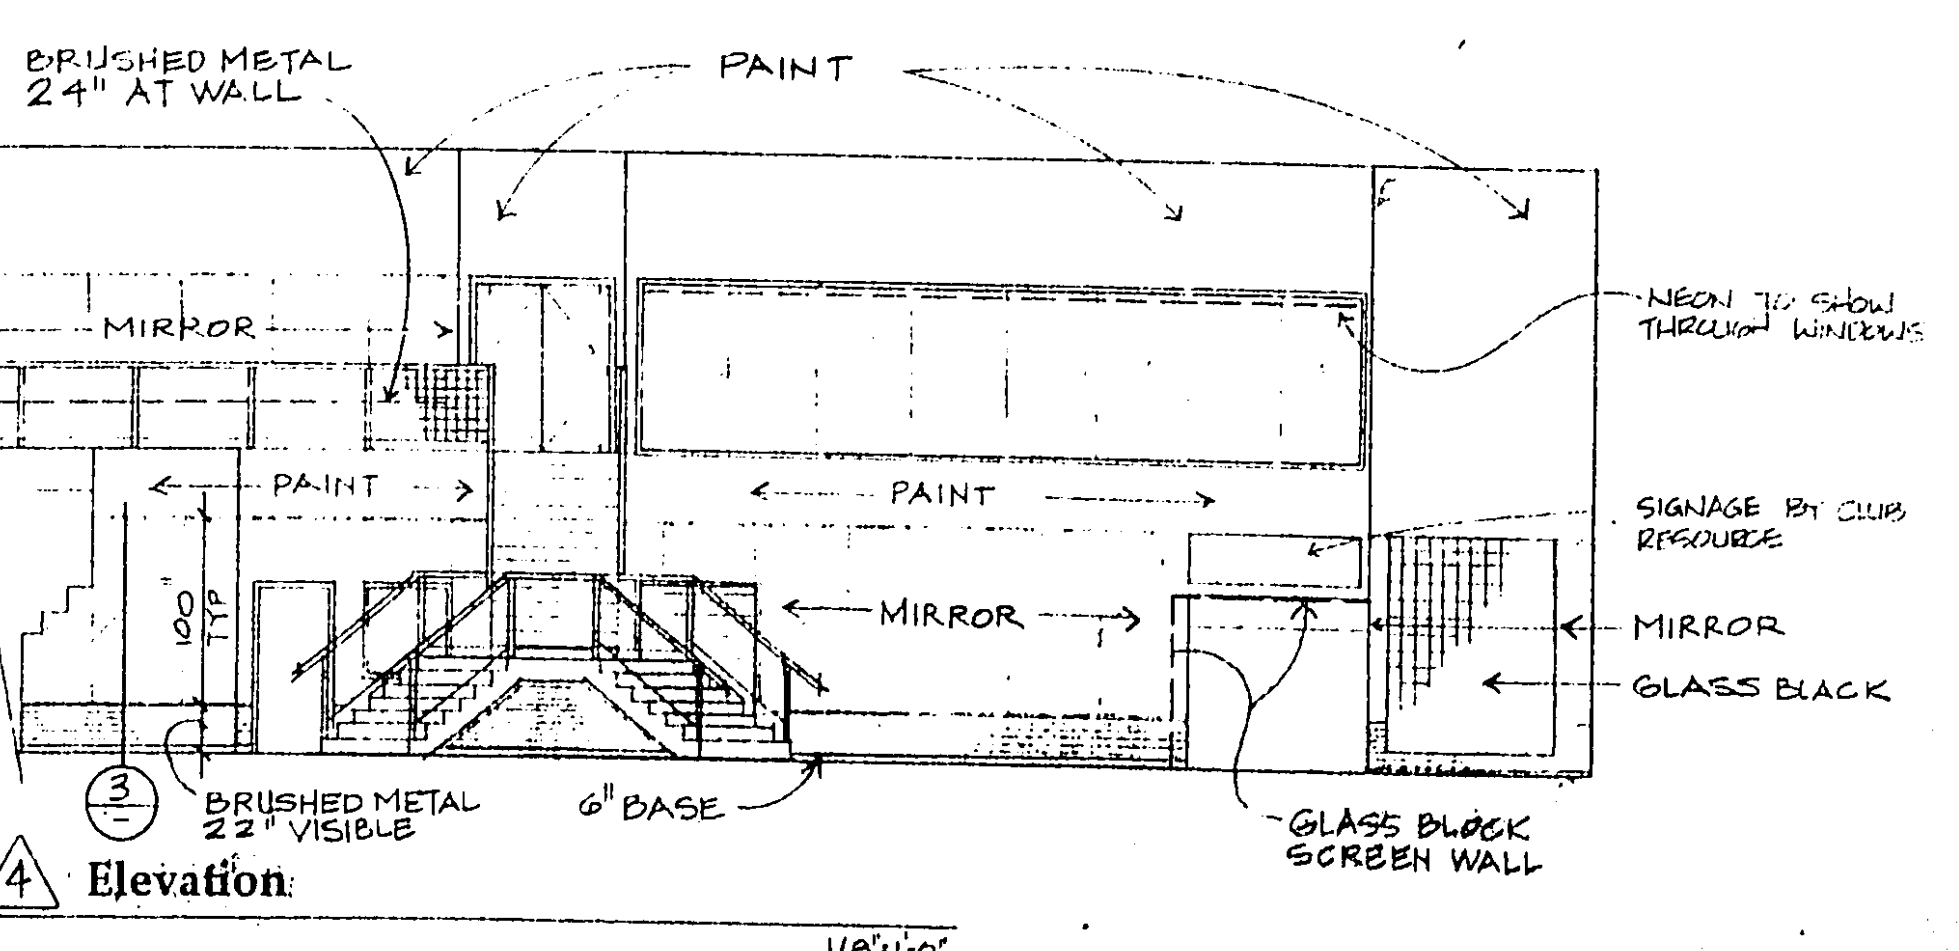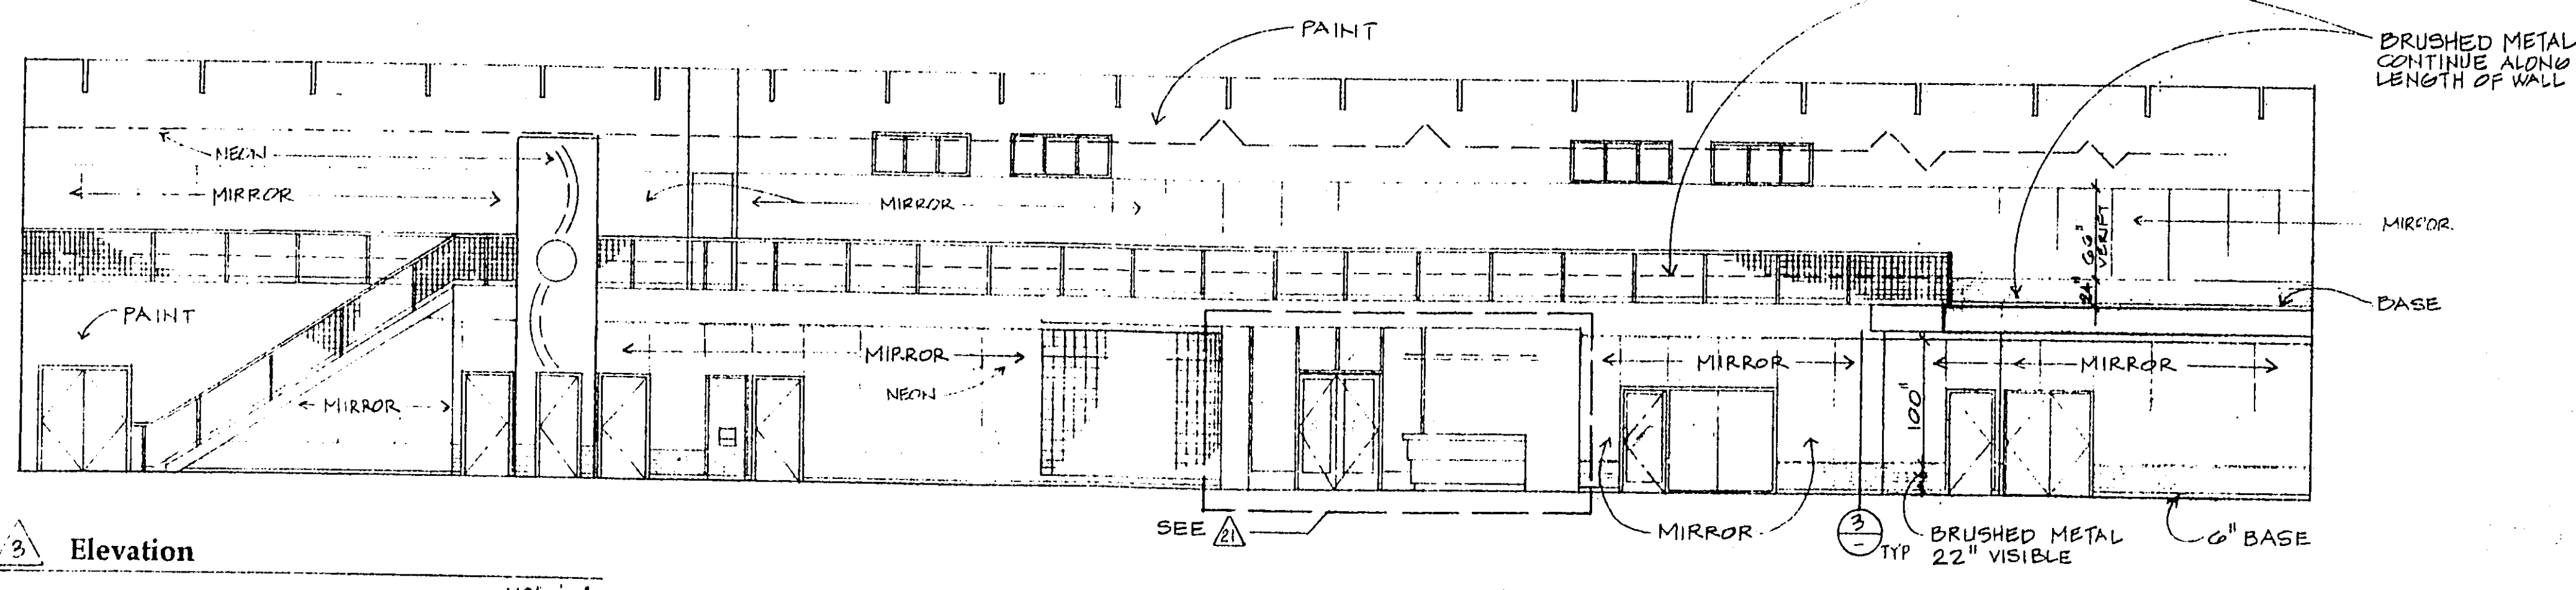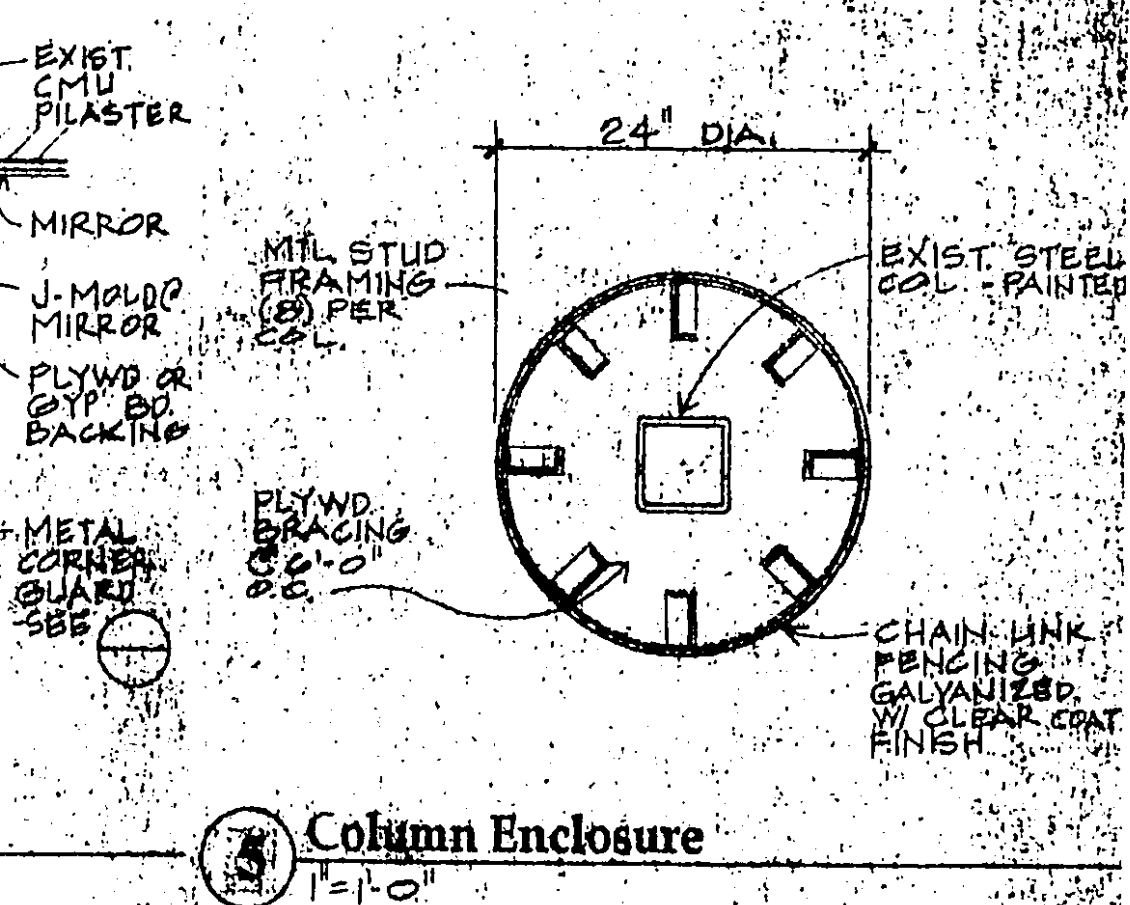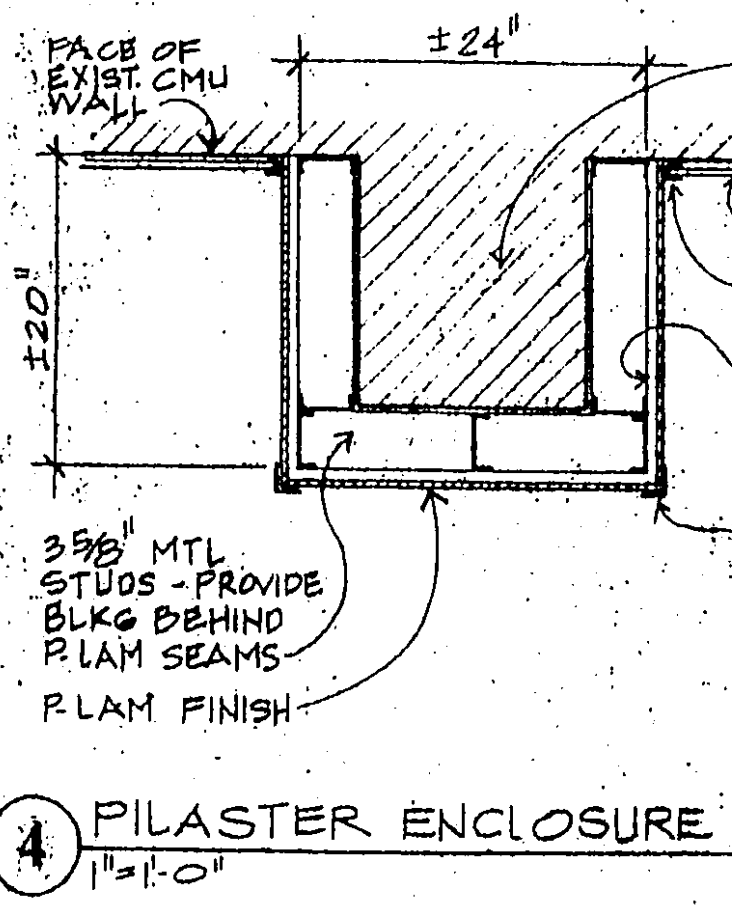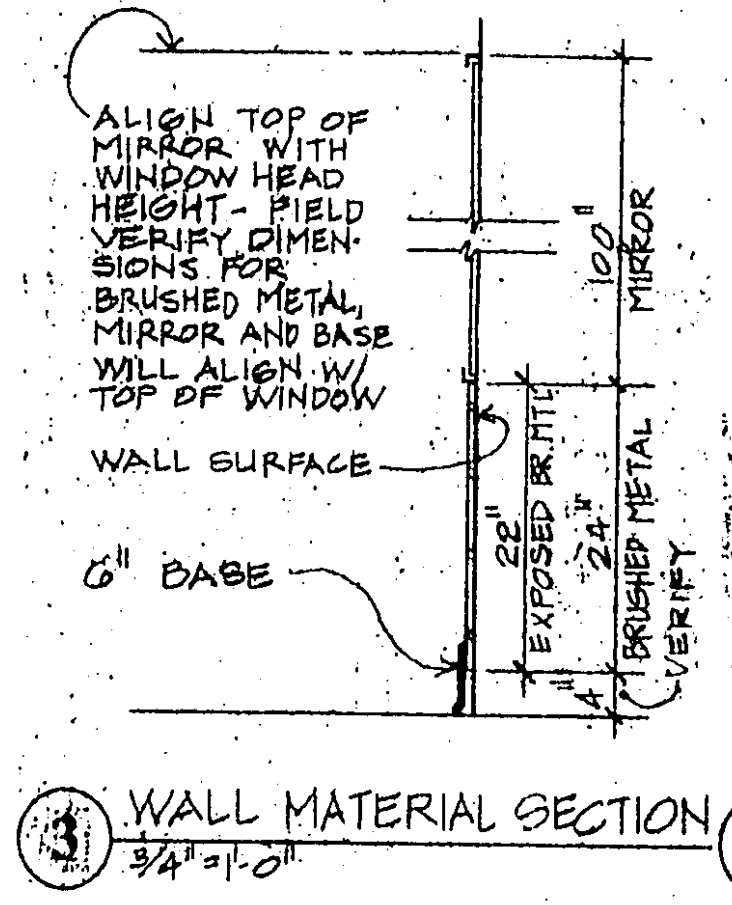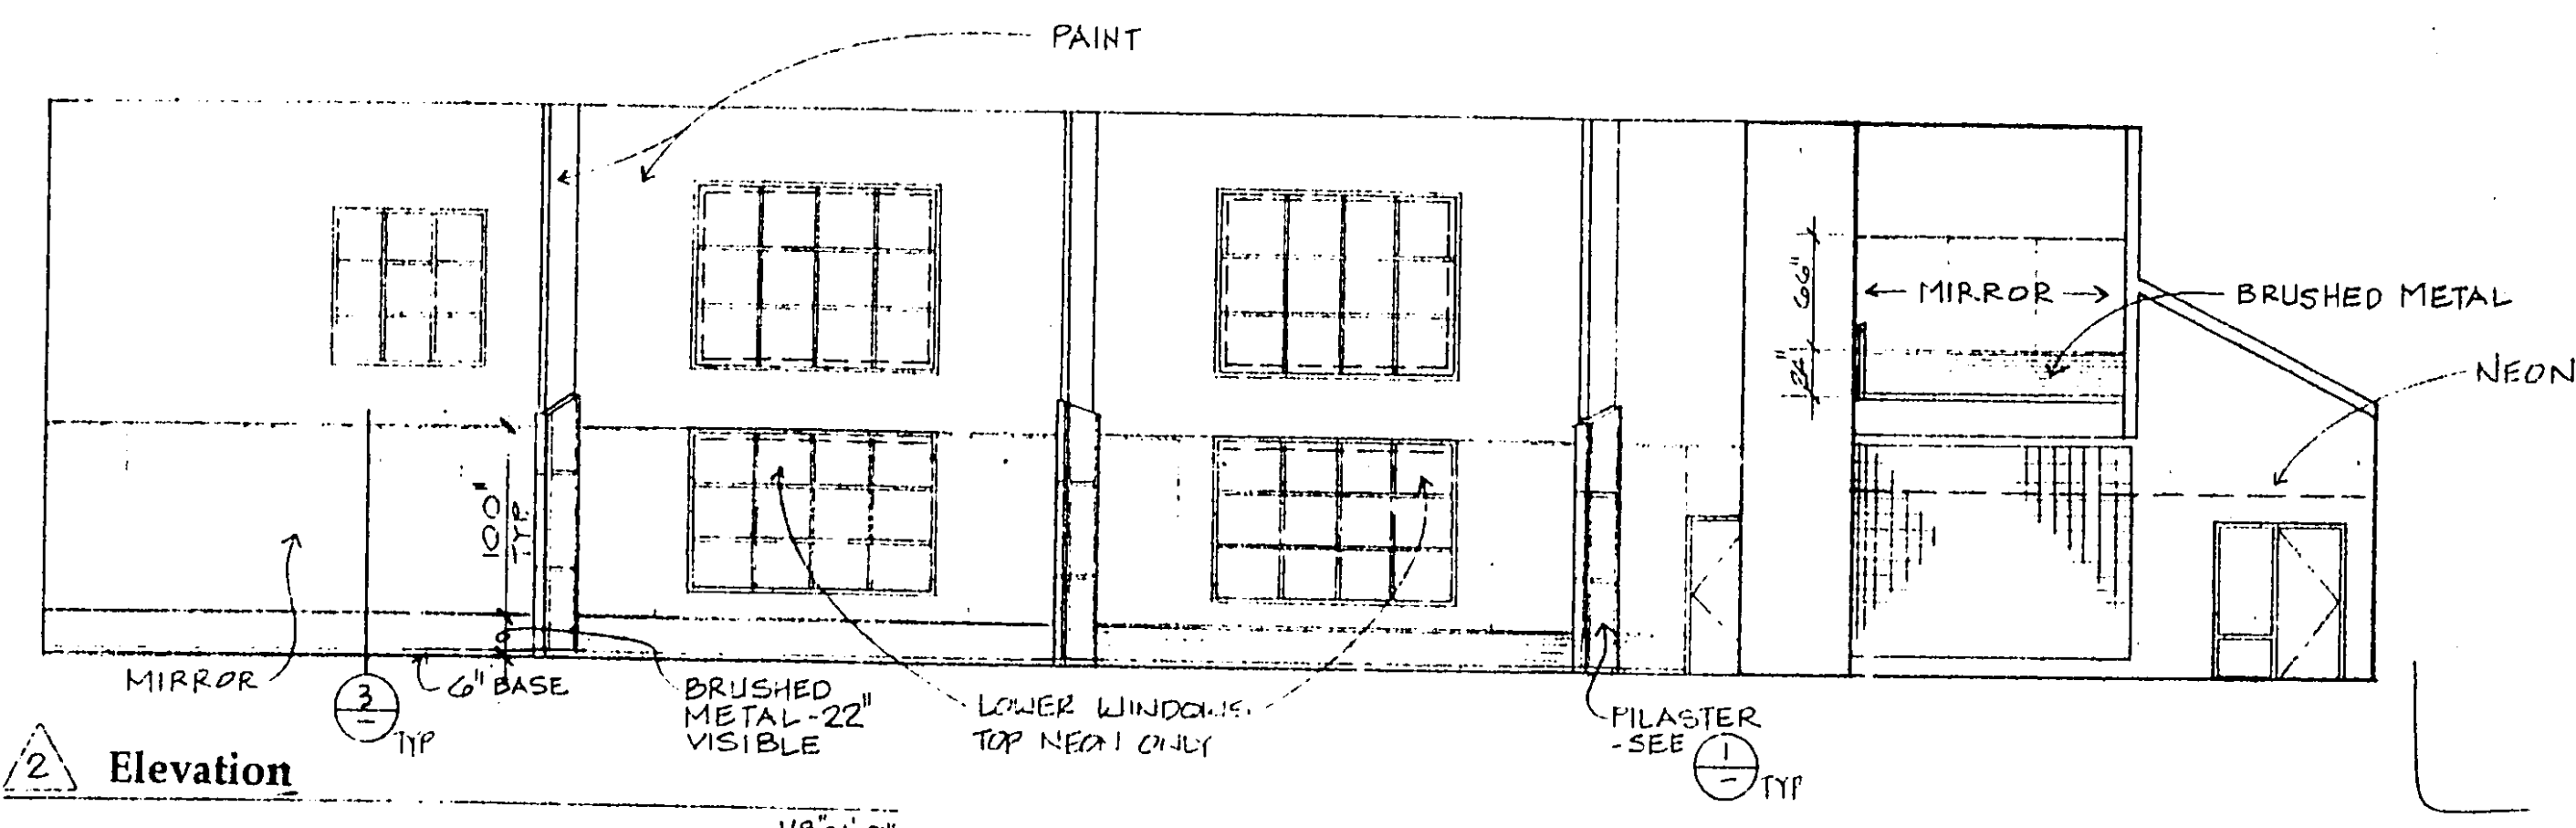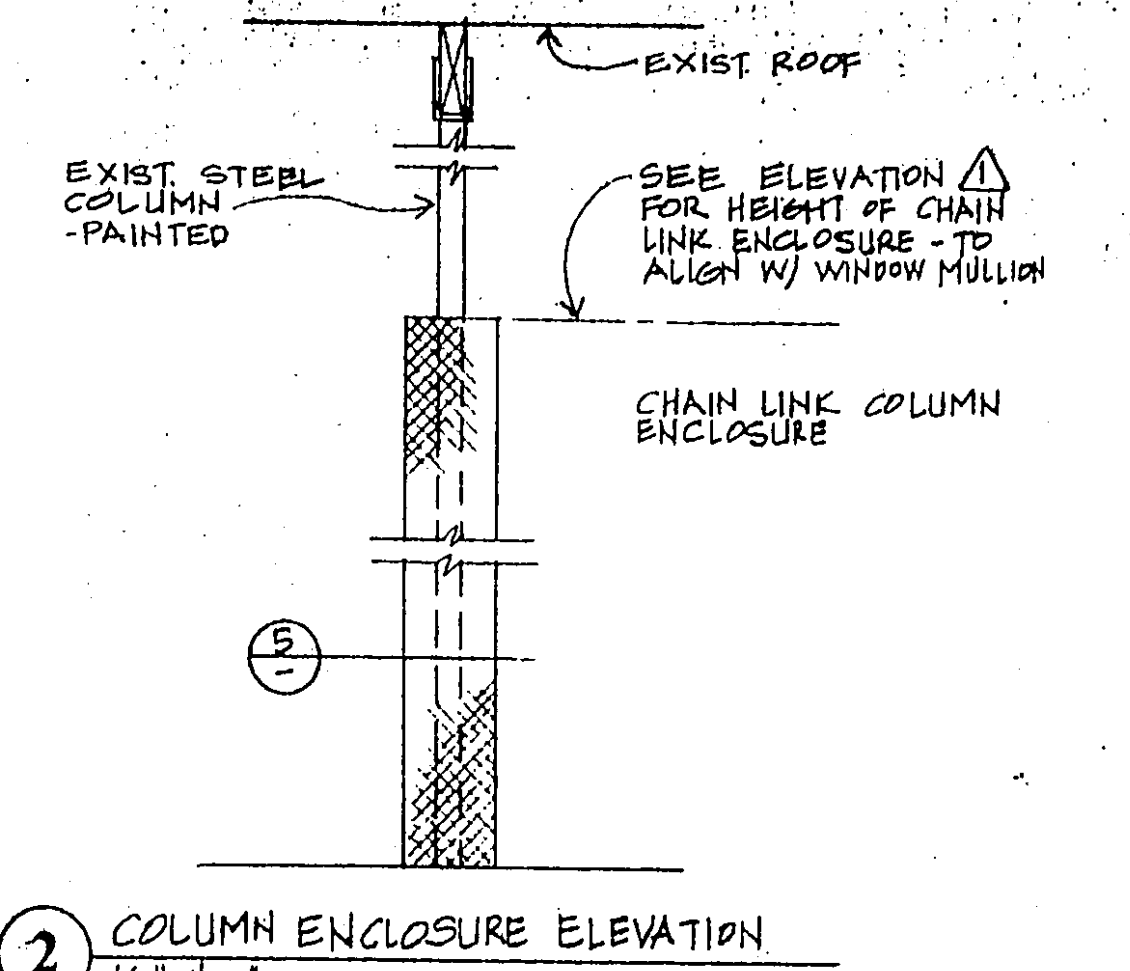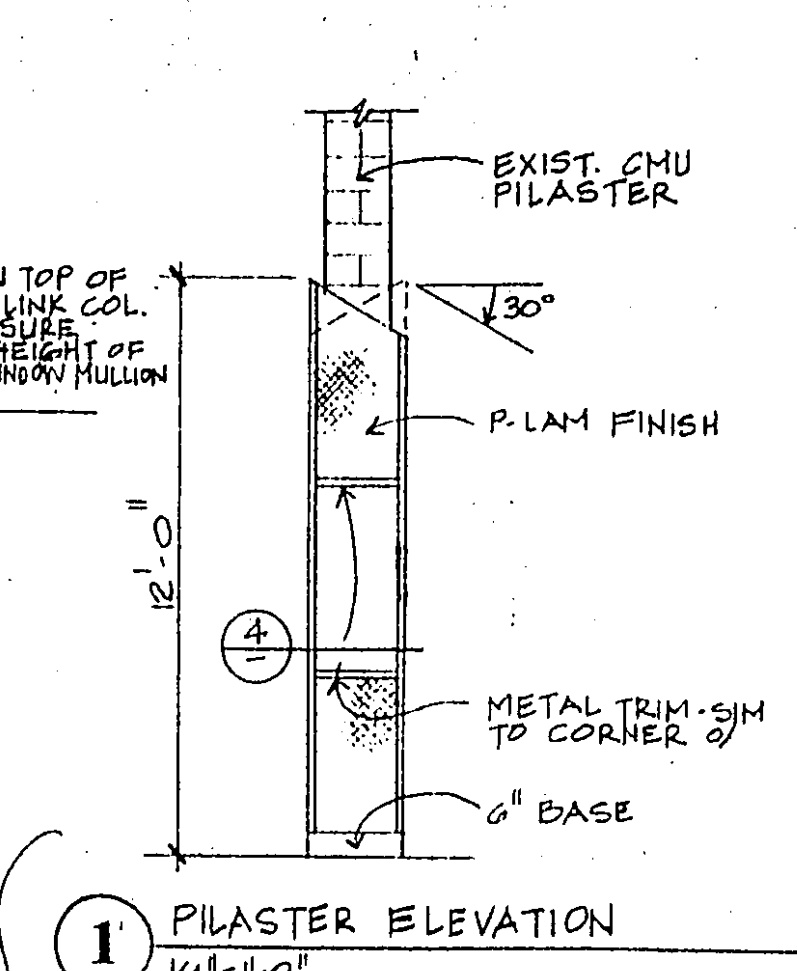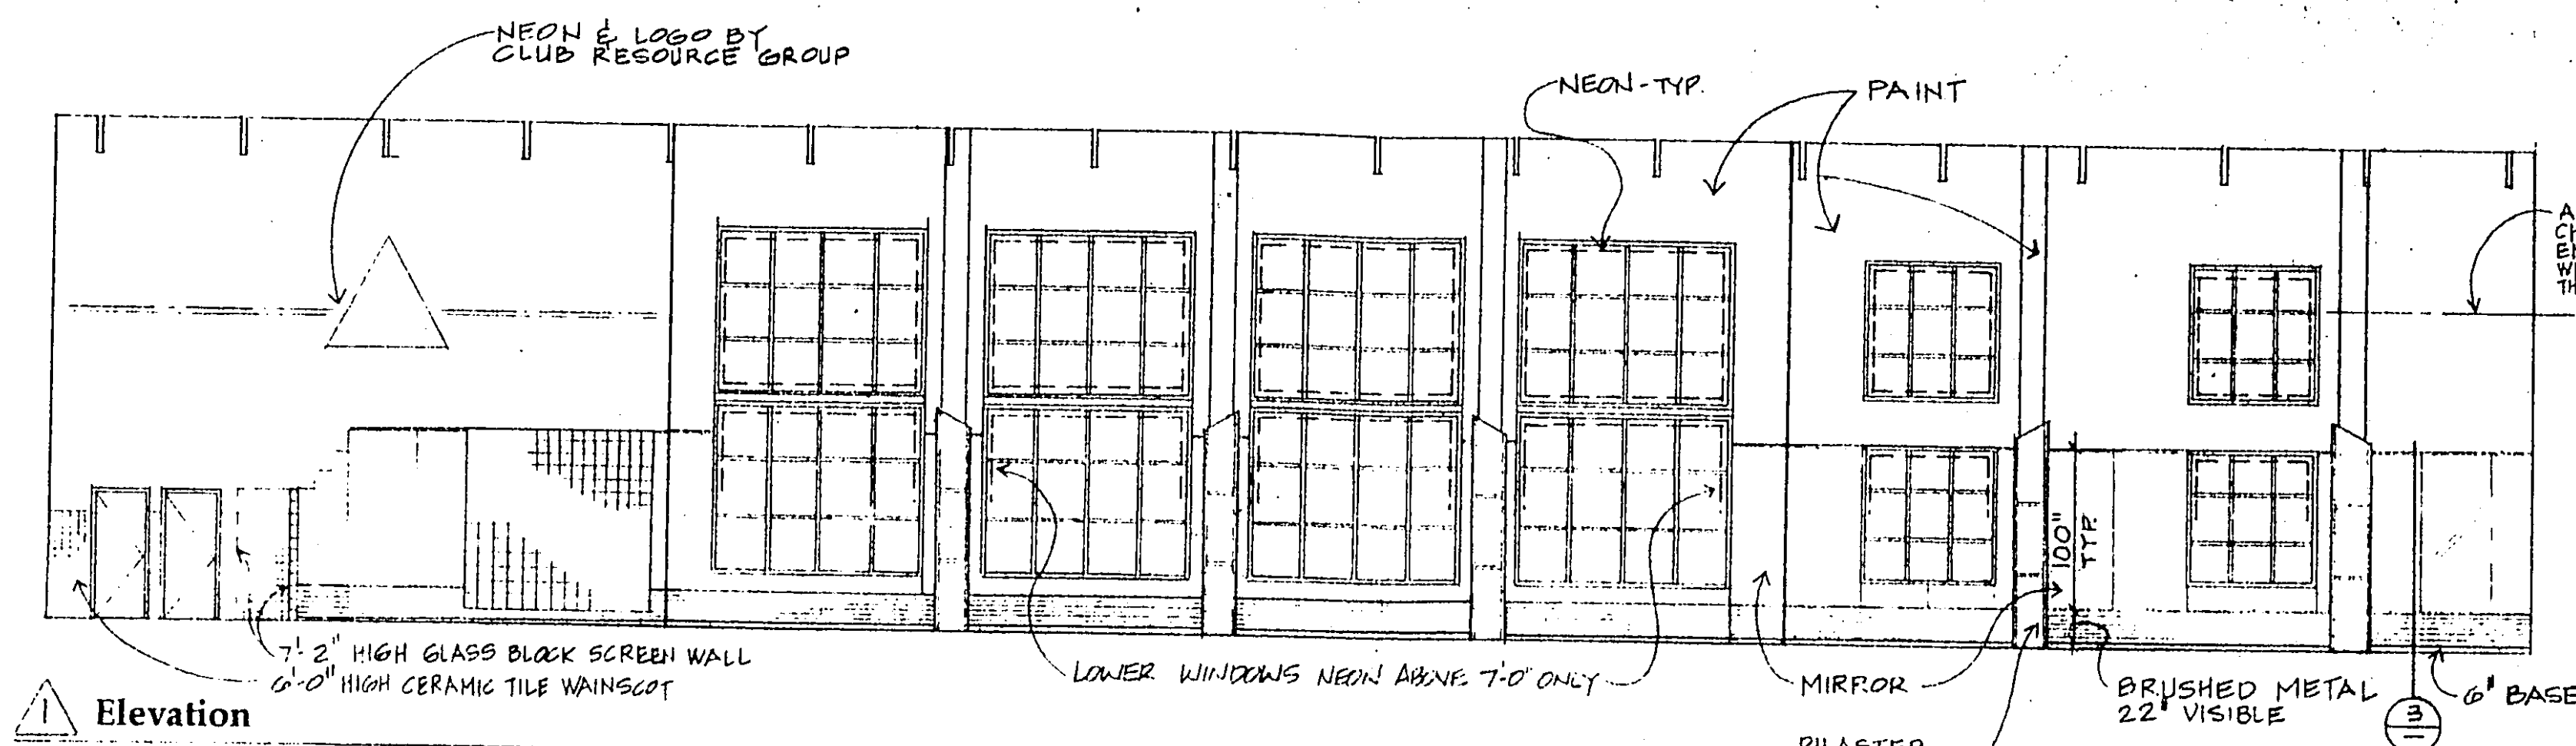

24 HOUR NAUTILUS
RENO 1
SKY MOUNTAIN DRIVE
RENO, NEVADA

COX & KROMYDAS
A.R.C.H.I.T.E.C.T.S.












POST OFFICE BOX 459
TRUCKEE, CA 96160

(916) 587-0757
(916) 581-4422
FAX (916) 587-2125


THESE DRAWINGS HAVE BEEN PREPARED BY COX & KROMYDAS ARCHITECTS FOR THE 24 HOUR NAUTILUS PROJECT. THEY ARE NOT TO BE USED FOR ANY OTHER PROJECTS IN OTHER LOCATIONS OR BY ANY OTHER PERSONS WITHOUT THE WRITTEN APPROVAL AND PARTICIPATION OF COX & KROMYDAS ARCHITECTS. REPRODUCTION IS PROHIBITED.

REVISIONS	DRAWN BY	JLS
	DATE	02.20.96
	SCALE	NOTED
	JOB NO.	9604

A20.r

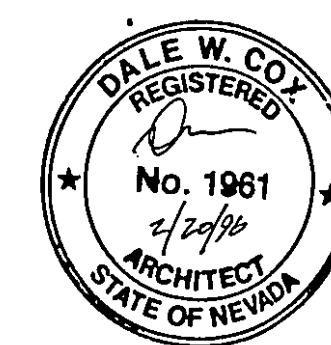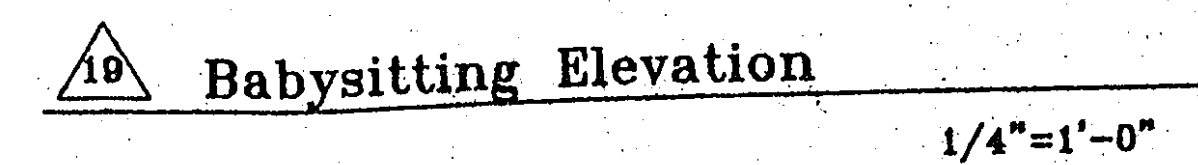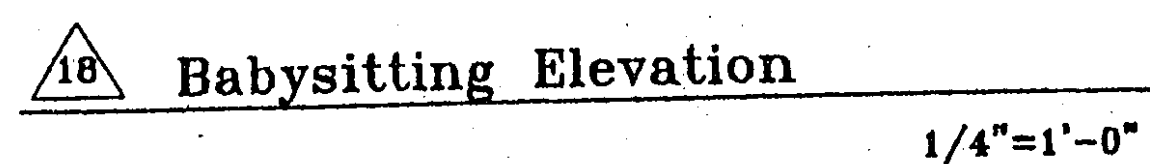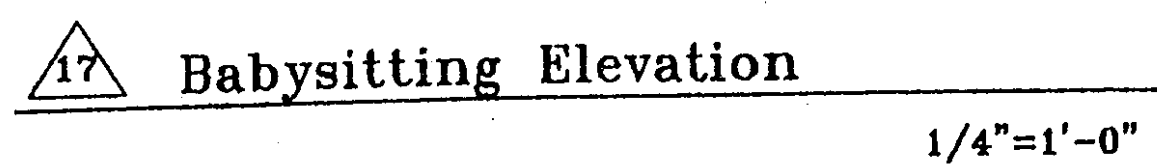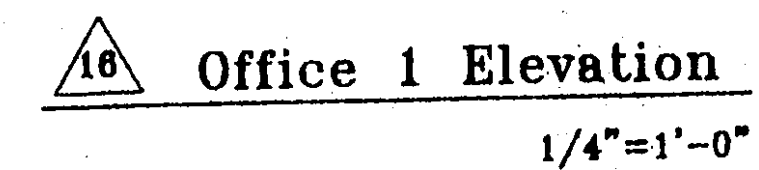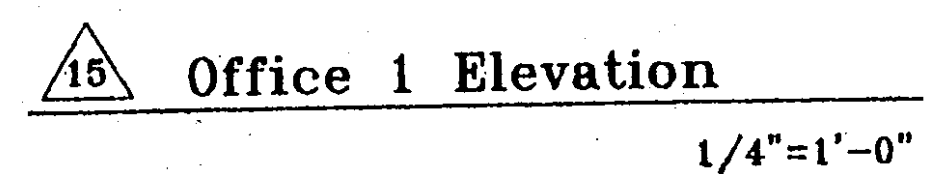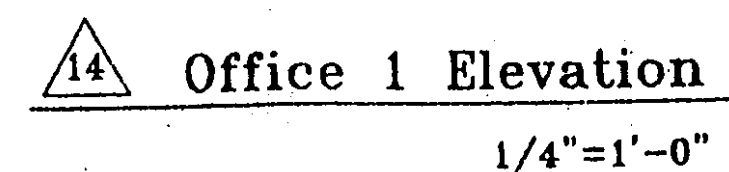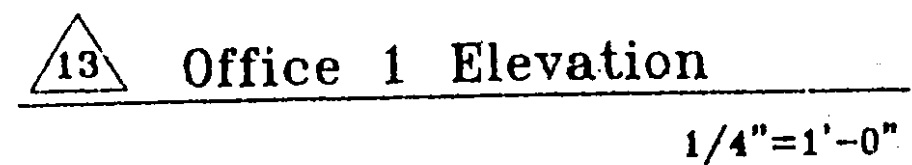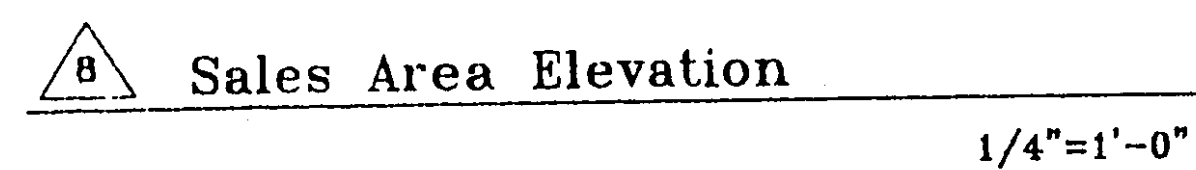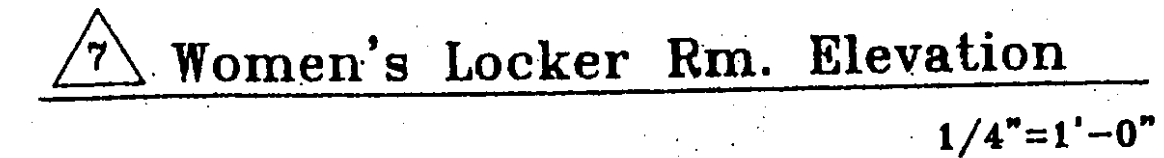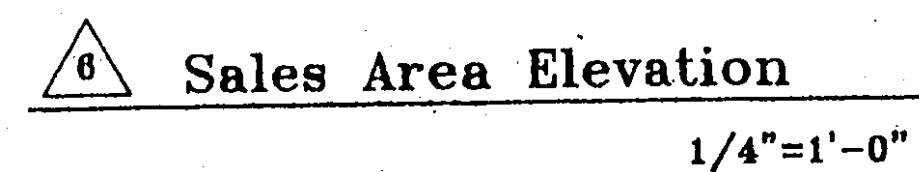


A21.r

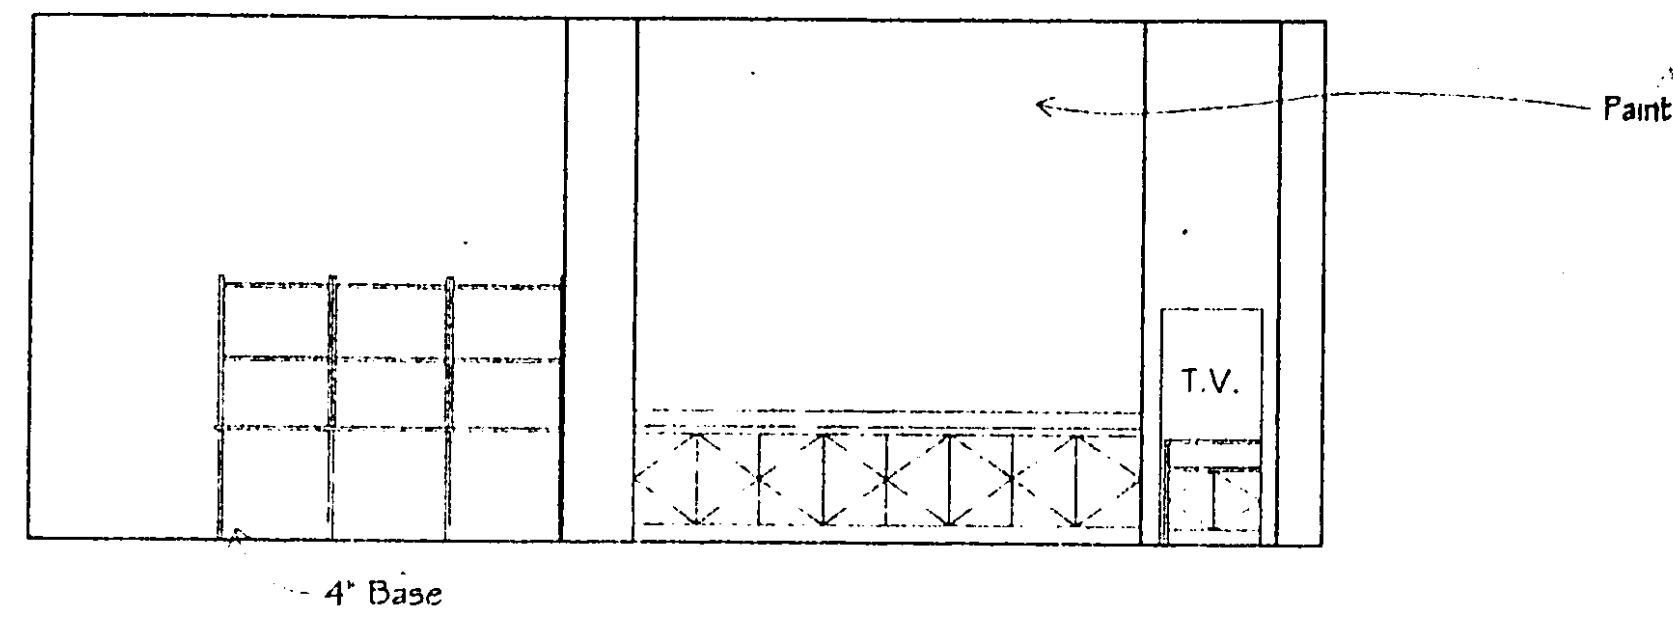


20 Babysitting Elevation

1/4"=1'-0"

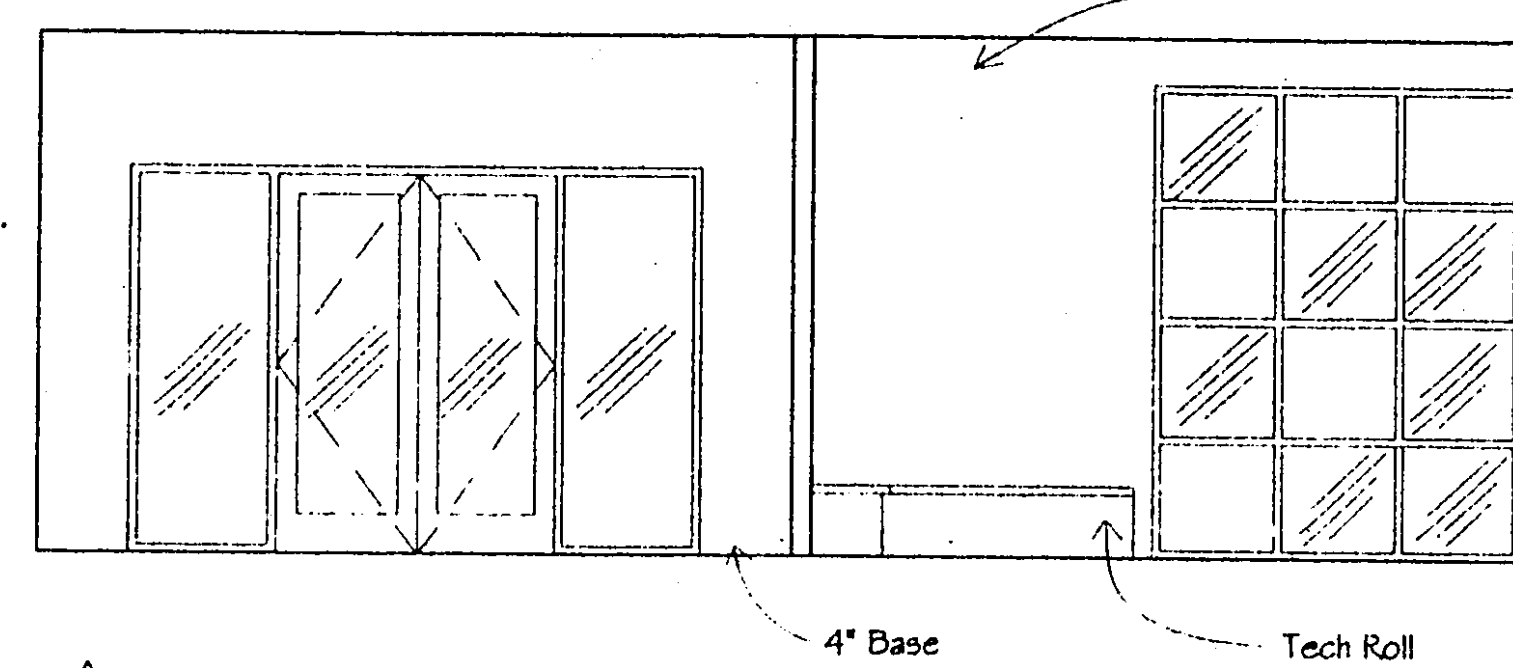


21 Lobby

1/4"=1'-0"

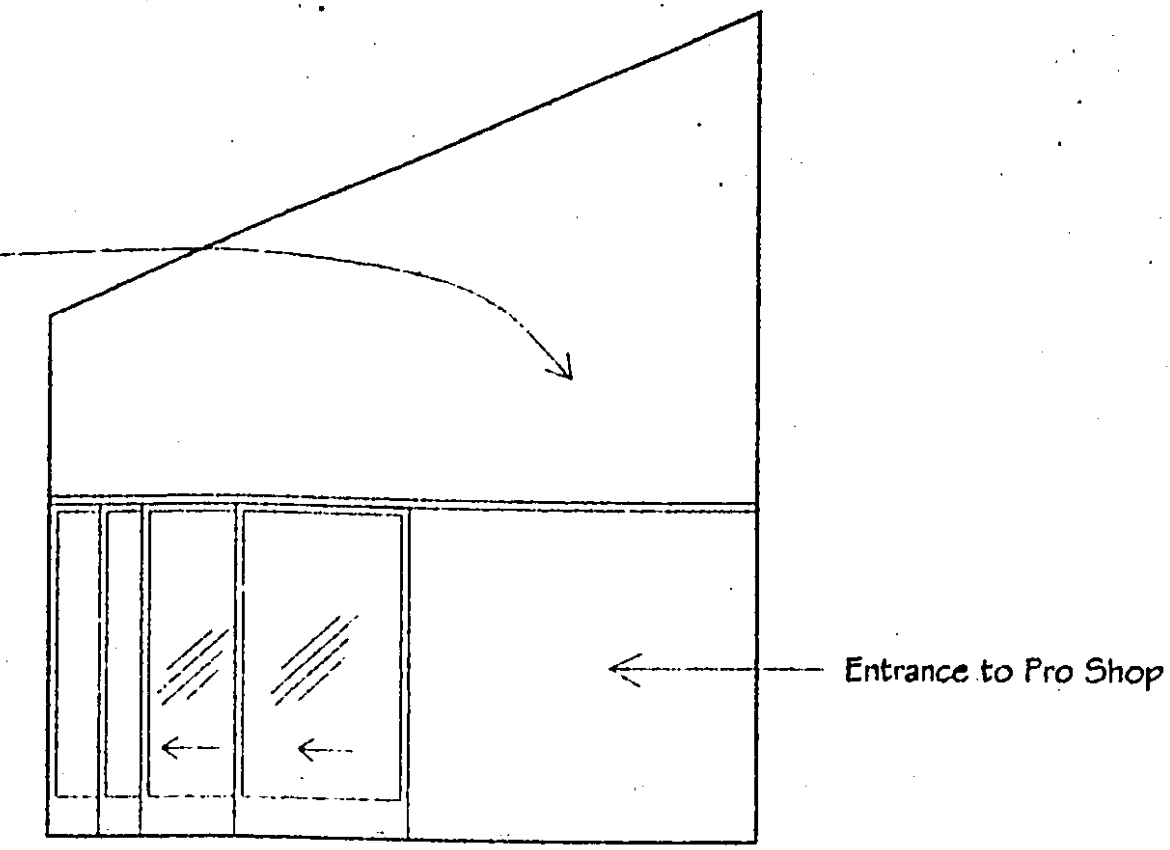


22 Lobby

1/4"=1'-0"

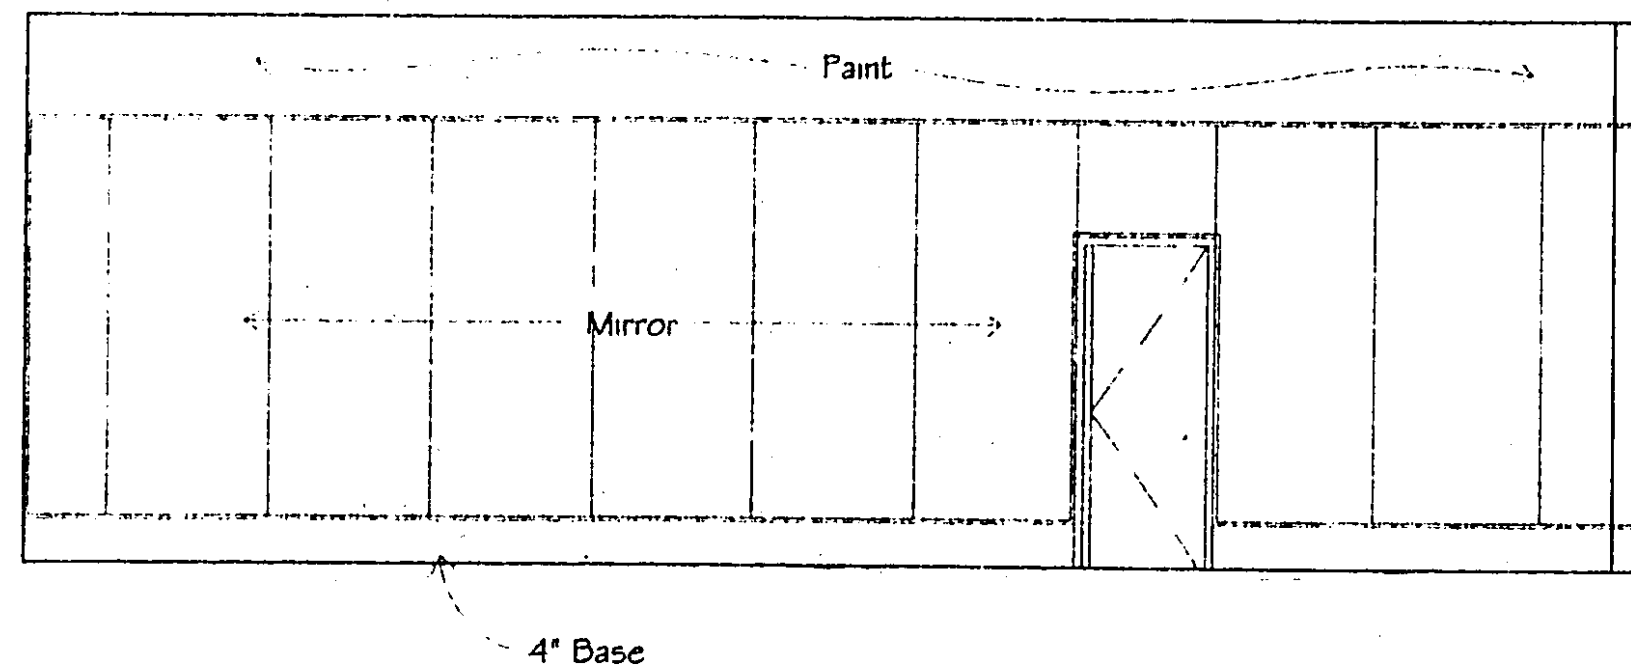


23 Aerobics

1/4"=1'-0"

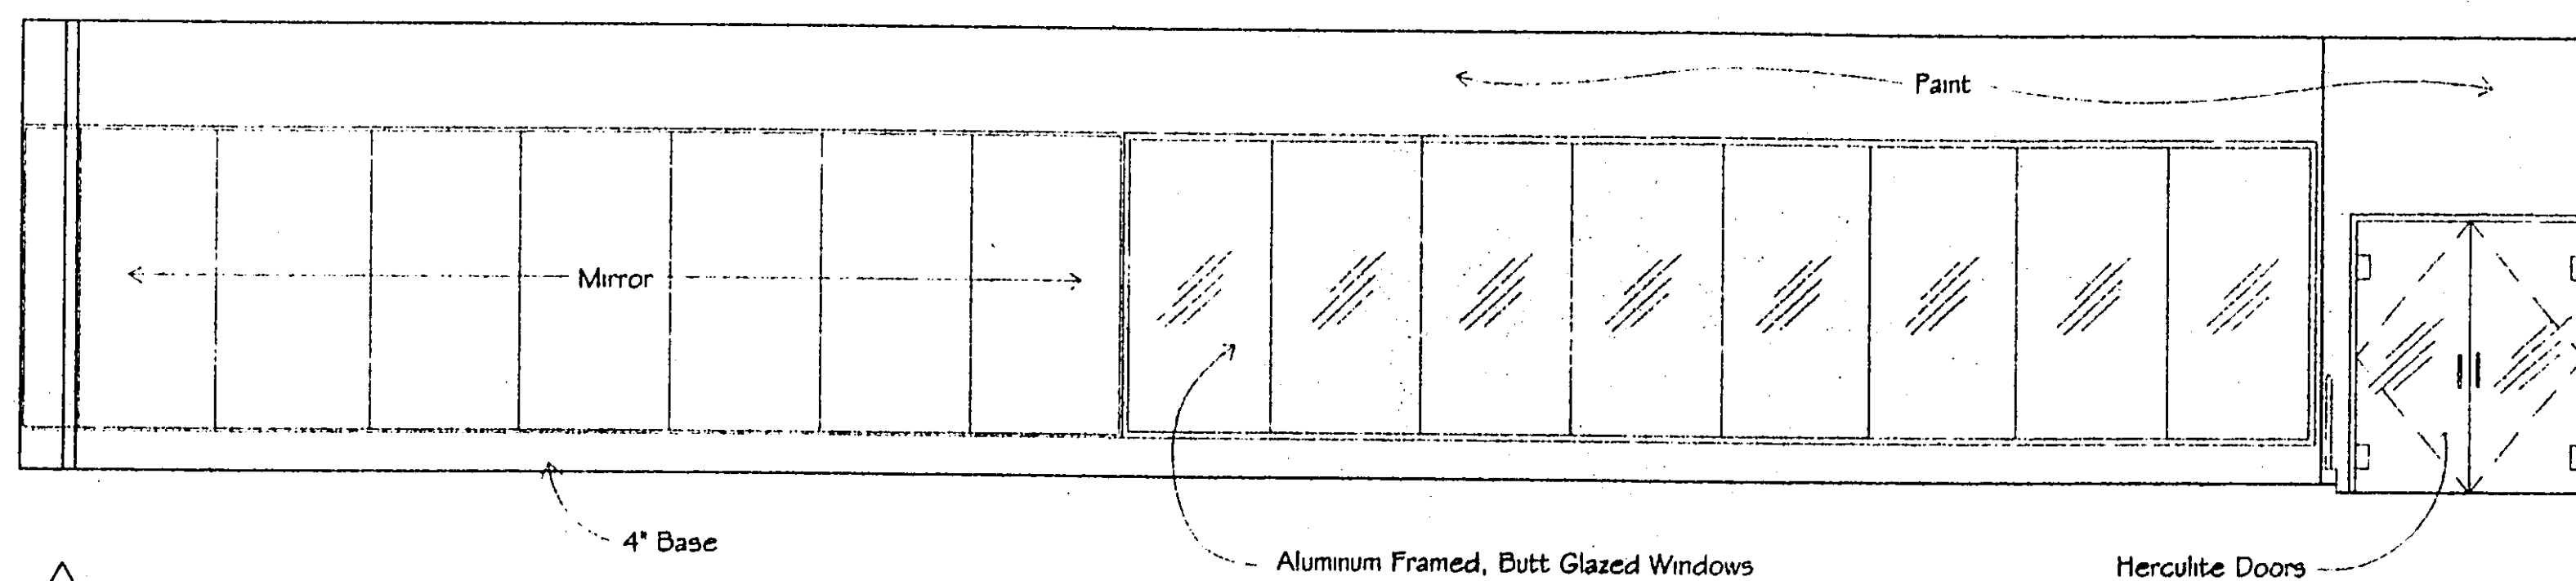


24 Aerobics

1/4"=1'-0"

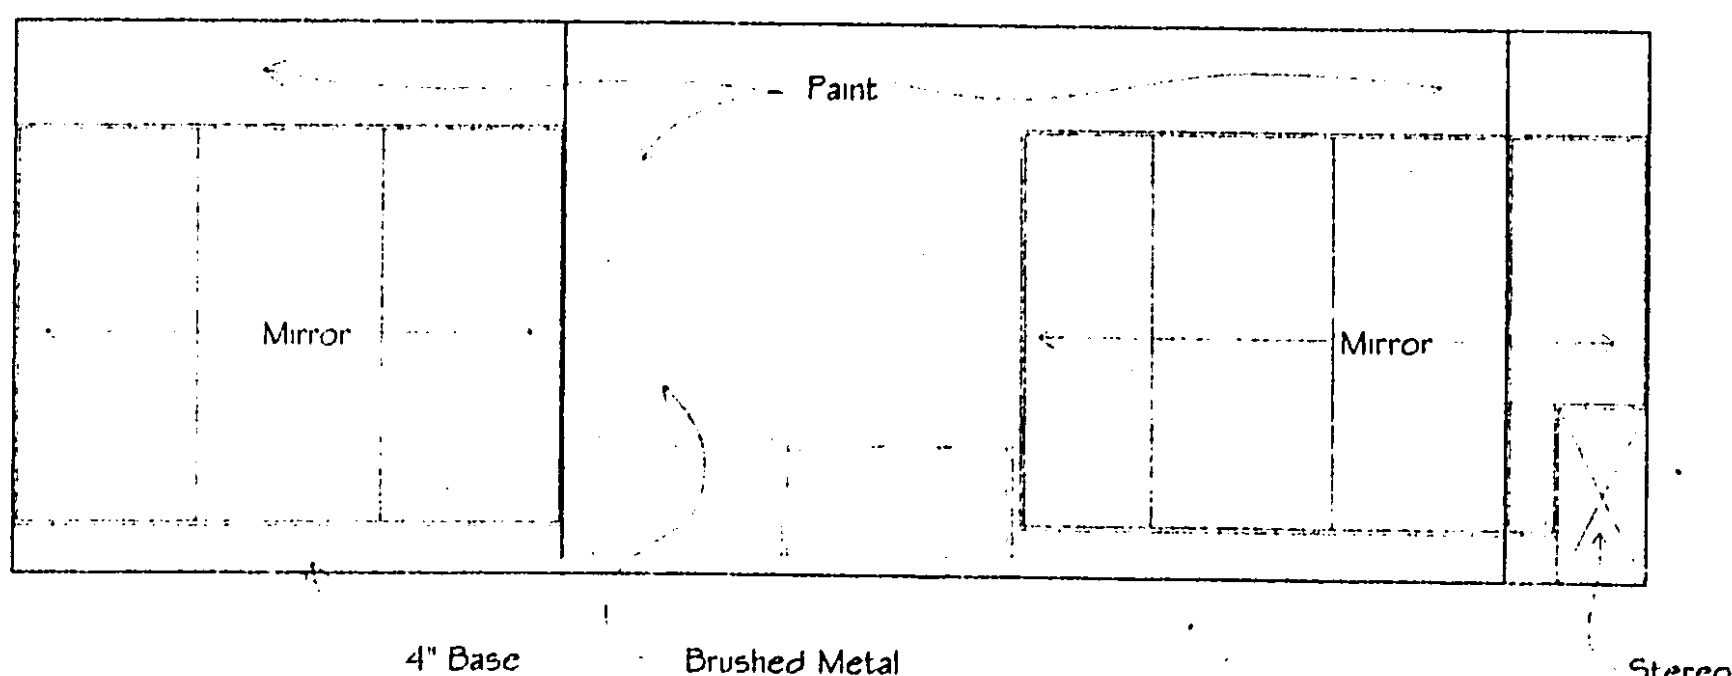


25 Aerobics

1/4"=1'-0"

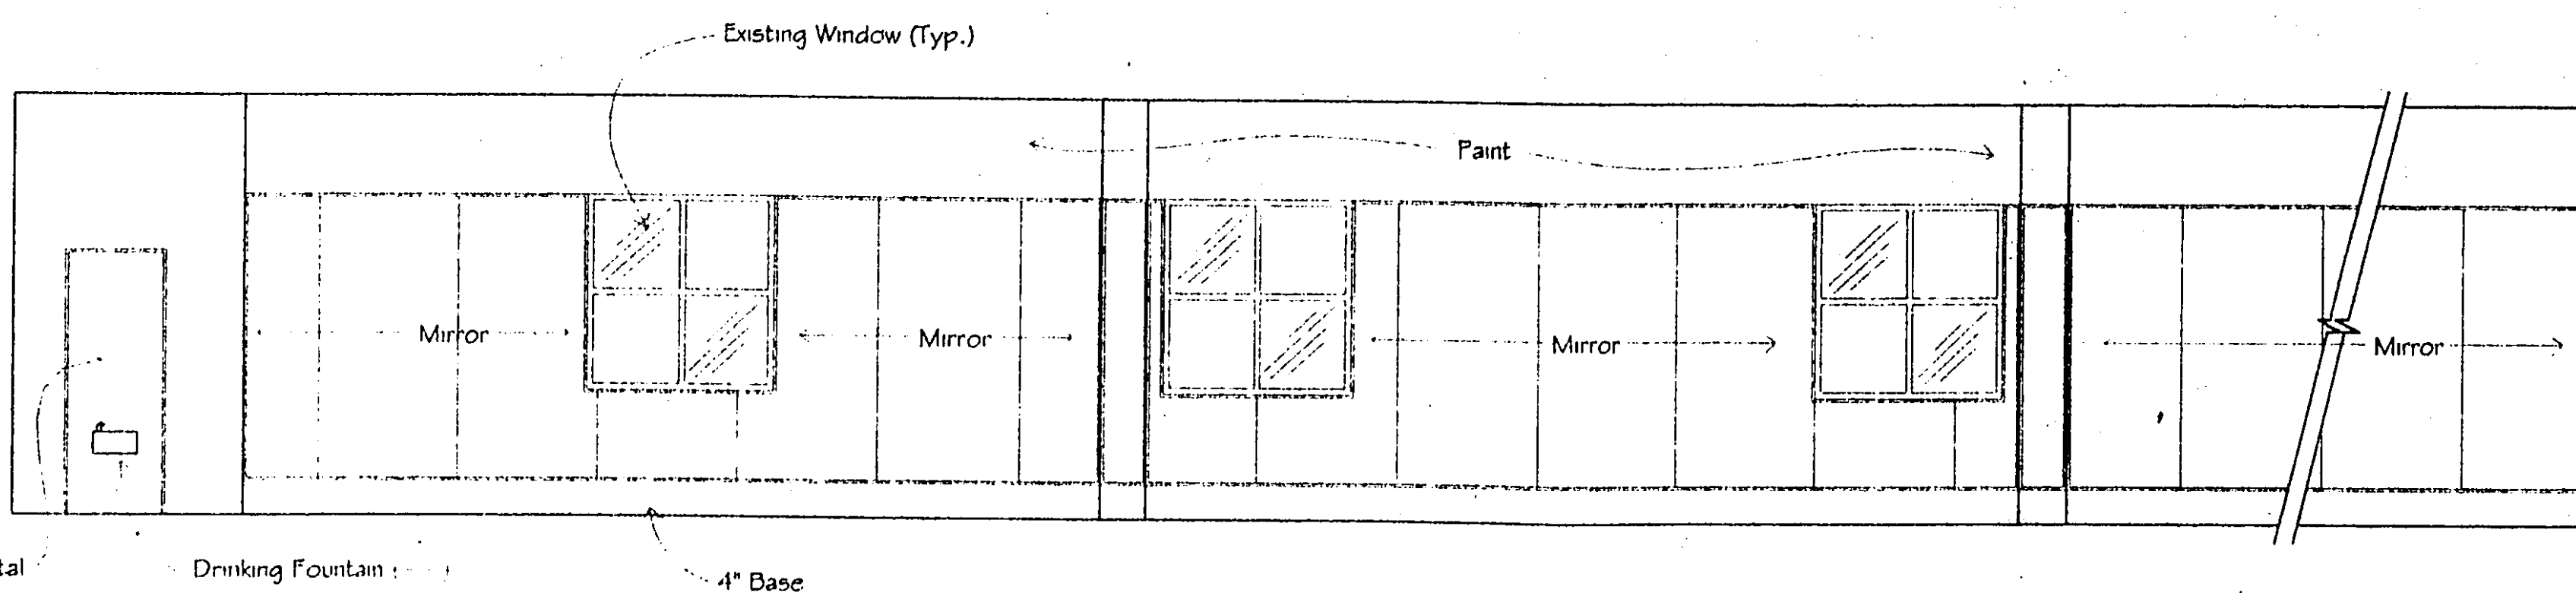

26 Aerobics

1/4"=1'-0"

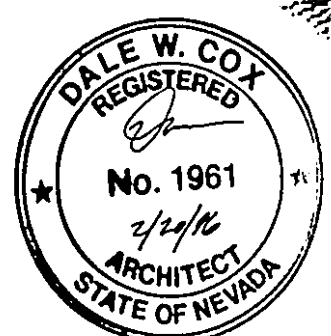

24 HOUR NAUTILUS
RENO 1
SKY MOUNTAIN DRIVE
RENO, NEVADA





COX & KROMYDAS
A.R.C.H.I.T.E.C.T.S

POST OFFICE BOX 459
TRUCKEE, CA 96160

(916) 567-6757
(916) 561-4422
FAX (916) 567-2136

THIS DRAWING AND ANY PART THEREOF IS THE PROPERTY OF COX & KROMYDAS ARCHITECTS. IT IS TO BE USED ONLY FOR THE PROJECT AND SITE SPECIFICALLY IDENTIFIED HEREON. IT IS NOT TO BE REPRODUCED, COPIED, OR IN ANY MANNER USED FOR ANY OTHER PROJECT WITHOUT THE WRITTEN APPROVAL AND SIGNATURE OF COX & KROMYDAS ARCHITECTS.

REVISIONS	DRAWN BY	JLS
DATE	02.20.98	
SCALE	NOTED	
JOB NO.	9604	
A22.r		

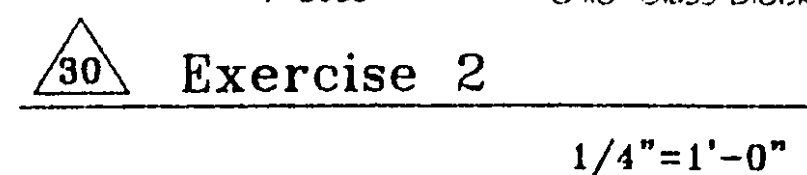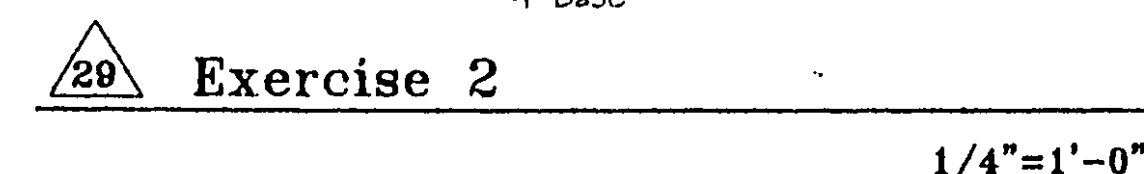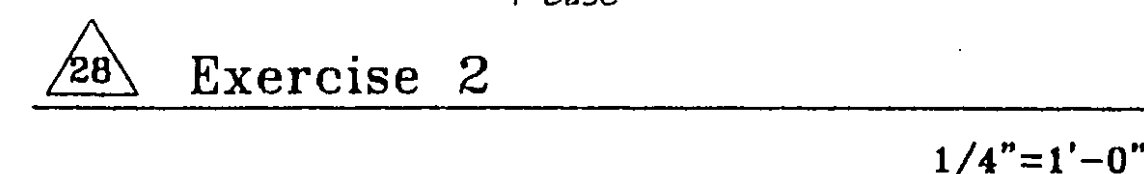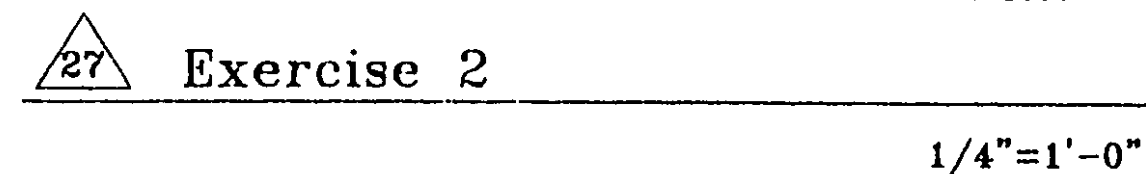

DOOR SCHEDULE REVISIONS


NOTE: ALL LATCHING DOORS TO HAVE LEVER HARDWARE
ALL DOORS RECEIVE STAINLESS STEEL KICK PLATE
STEAM & SALINA ROOM DOORS WITH PUSH/PULL BARS, WEATHER STRIPPING & THRESHOLDS
DOORS TO HAVE THE FOLLOWING CLOSURE FORCES: EXTERIOR DOORS 8.5 LBS. MAX.
INTERIOR DOORS 5 LBS. MAX.
FIRE DOORS 15 LBS. MAX.

DOOR NO.	THICKNESS	WIDTH	HEIGHT	MATERIAL	CORE	FINISH	FRAME	ACTION	THRESHOLD	REMARKS
①	1 3/4"	3'-0"	7'-0"	ALUM.	GLASS	CLR. ANOD.	ALUM.	SWING -	-	PANIC HWR., CLOSER, STOREFRONT
②		3'-0"	7'-0"	ALUM.	GLASS	CLR. ANOD.	ALUM.	SWING -	-	STOREFRONT
③		3'-0"	7'-0"	WOOD	SOLID	P. LAM.	ALUM.	SWING -	-	
④		15'-7"	7'-0"	ALUM.	GLASS	CLR. ANOD.	ALUM.	SWING -	-	SLIDING METAL TRACK-TEMPERED GLASS
⑤		3'-0"	7'-0"	WOOD	SOLID	P. LAM.	ALUM.	SWING -	-	CLOSER
⑥		3'-0"	7'-0"	WOOD	SOLID	P. LAM.	ALUM.	SWING -	-	
⑩		3'-0"	7'-0"	ALUM.	GLASS	CLR. ANOD.	ALUM.	SWING -	-	
⑪		3'-0"	7'-0"	ALUM.	GLASS	CLR. ANOD.	ALUM.	SWING -	-	CLOSER
⑬		3'-0"	7'-0"	WOOD	SOLID	P. LAM.	ALUM.	SWING -	-	
⑮	PR 3'-0"	7'-0"	7'-0"	WOOD	SOLID	P. LAM.	ALUM.	SWING -	-	
⑰		3'-0"	7'-0"	WOOD	SOLID	P. LAM.	ALUM.	SWING -	-	
⑲		3'-0"	7'-0"	WOOD	SOLID	P. LAM.	ALUM.	SWING -	-	ELEC. LOCK; CLOSER; 24"x30" GLASS
㉑		3'-0"	7'-0"	WOOD	SOLID	P. LAM.	ALUM.	SWING -	-	
㉒		3'-0"	7'-0"	WOOD	SOLID	P. LAM.	ALUM.	SWING -	-	
㉓		3'-0"	7'-0"	WOOD	SOLID	P. LAM.	ALUM.	SWING -	-	PANIC HWR.; CLOSER
㉔		3'-0"	7'-0"	WOOD	SOLID	P. LAM.	ALUM.	SWING -	-	ELEC. LOCK; CLOSER; 24"x30" GLASS
㉕		PR 3'-0"	7'-0"	GLASS	GLASS	CLR.	ALUM.	SWING -	-	HERCULITE
㉖	PR 3'-0"	10'-0"	10'-0"	WOOD	SOLID	STAIN	WOOD	SWING		BUILD OVER EXST. ROLL-UP DOOR

Room Finish Schedule										Notes
Description	Floor	Base	Walls	Ceiling	Ceil. Ht.					
	12" x 12" Granite Tiles Carpet w/ pad Ceramic Tile Hardwood Rubber Sports Flooring Sanded Concrete Sheet Vinyl Vinyl Comp. Tile 6" Corvel Ceramic Tile 6" Corvel Vinyl 6" Granite Vinyl 4" Ceramic Tile Walnut 28" Gyp Bd. 58" Type "X" Gyp Bd. Ceramic Tile Mirror Bathrooms Cadin T&G 7' x 9' Acoustical Tile 28" Gyp Bd. 58" Type "X" Gyp Bd. Ceramic Tile Elate Expand Struct Reinforced in Cadin T&G									
Accounting Office	X				9'-0"					
Aerobics	X	X								
Asst Mgr	X									
Balancing	X									
Employee Room		X								
Exercise Area		X								
Holding Rm		X								
Janitor		X								2-Water Resis
Laundry Rm				2						1 - No Pad
Men's Lockers	1			X						
Men's Showers		X								
Men's Toilet		X		2						2-Water Resis
Men's Vanity		X		X						2-Water Resis
Mng. Office	X			X						
Office 1 & 6	X			X						
Oper Mgr		X								
Pzo Shop		X		X						
Reception		X		X						
Sauna										2-Water Resis
Tee	X			2						2-Water Resis
Trg Equipment		X								
Steam	X			X						
Storage 1				X						
Storage 2	X			X						
Storage 3		X		X						1 - No Pad
Women's Lockers	1			X						
Women's Shower		X		X						2-Water Resis
Women's Toilet		X		X						2-Water Resis
Women's Vanity		X		2						

Room Finish Notes:

1. All floor tile shall be slip resistant
2. All drapes, hangings, curtains, drops and all other decorative material shall comply with the Uniform Fire Code, Article 25.103 (a)
3. Finishes on walls & ceilings to have min. flame spread Class of III, for A.3 occupancy
4. Finishes on walls & ceilings to have min. flame spread class of II, for A.2 occupancy
5. All interior finishes must comply with Chapter 42 of the UBC.
6. Floors and walls in toilet rooms shall have finishes surfaced with smooth, hard non-absorbent material, notably for the 6" base and tile 4" wainscot around the toilets and urinals, per UBC Section 510 (6).
7. Suspended ceilings shall comply with UBC Tables 47A and 23P.

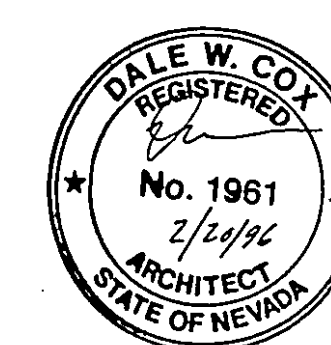

24 HOUR NAUTILUS
RENO 1
SKY MOUNTAIN DRIVE
RENO, NEVADA

COX & KROMYDAS
A.R.C.H.I.T.E.C.T.S

POST OFFICE BOX 48
TRUCKEE, CA 96160

(916) 567-6737
(916) 581-4422
FAX (916) 567-2133

<p>THIS DRAWING HAS BEEN PREPARED BY ONE OF VANDERBILT ARCHITECTS FOR THE U.S. ARMY MILITARY PROJECT.</p> <p>IT MAY NOT BE REPRODUCED FOR USE ON OTHER PROJECTS, IN OTHER LOCATIONS OR BY ANY OTHER VANDERBILT ARCHITECTS WITHOUT THE APPROVAL AND PERMISSION OF ONE OF VANDERBILT ARCHITECTS.</p> <p>REPRODUCTION IS PROHIBITED. (C)</p>	
REVISIONS	<p>DRAWN BY J</p> <p>DATE 02.20.5</p> <p>SCALE: NOTE</p> <p>JOB NO. 06</p> <p>A23.</p>



$$1/4'' = 1' - 0''$$

$$1/4'' = 1' - 0''$$


$$1/4'' = 1' - 0''$$

$$1/4^n = 1' - 0^n$$


A23.r

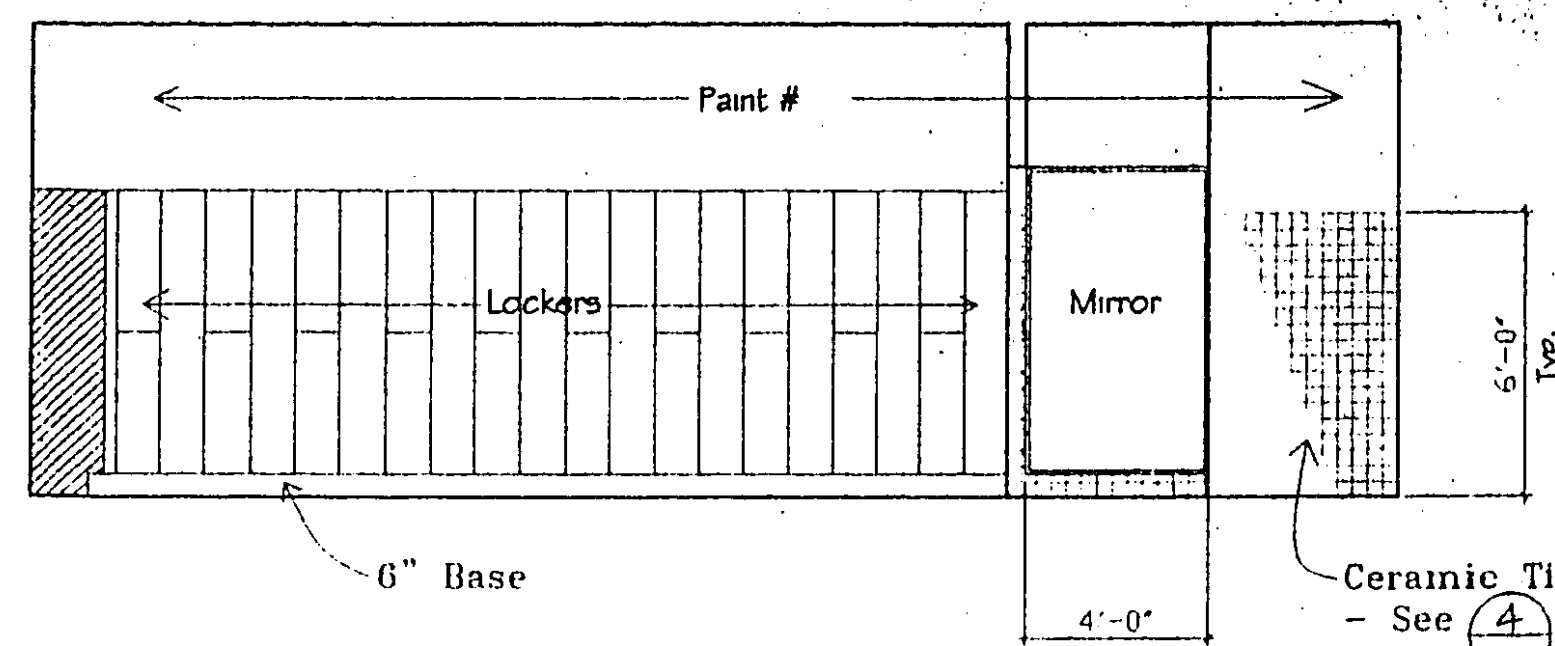

31 Men's Lockers

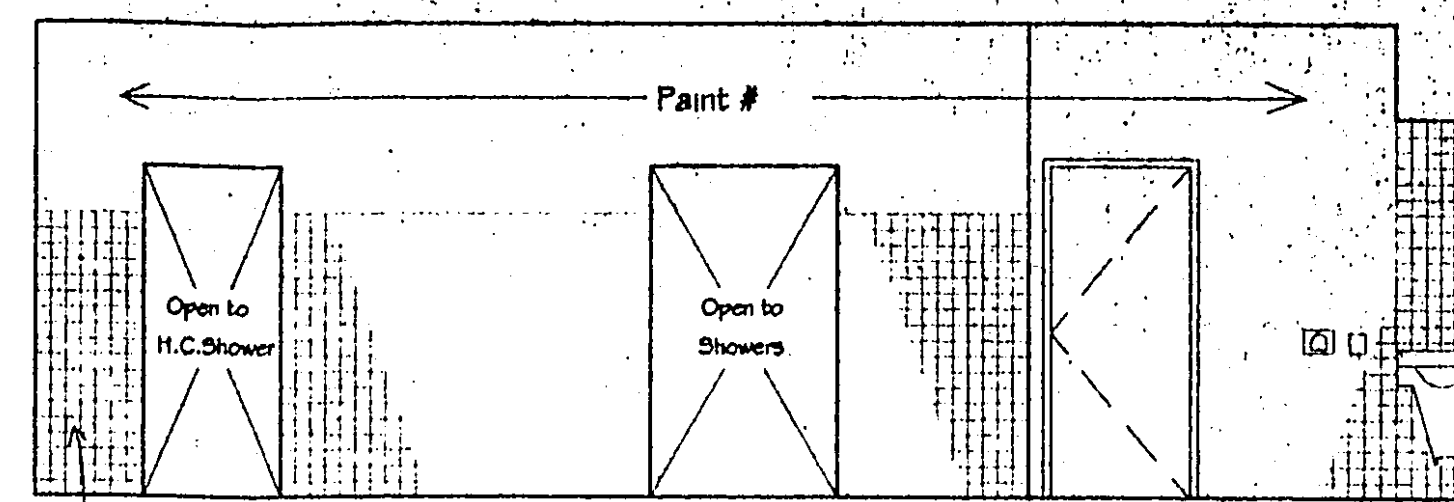


32 Men's Lockers

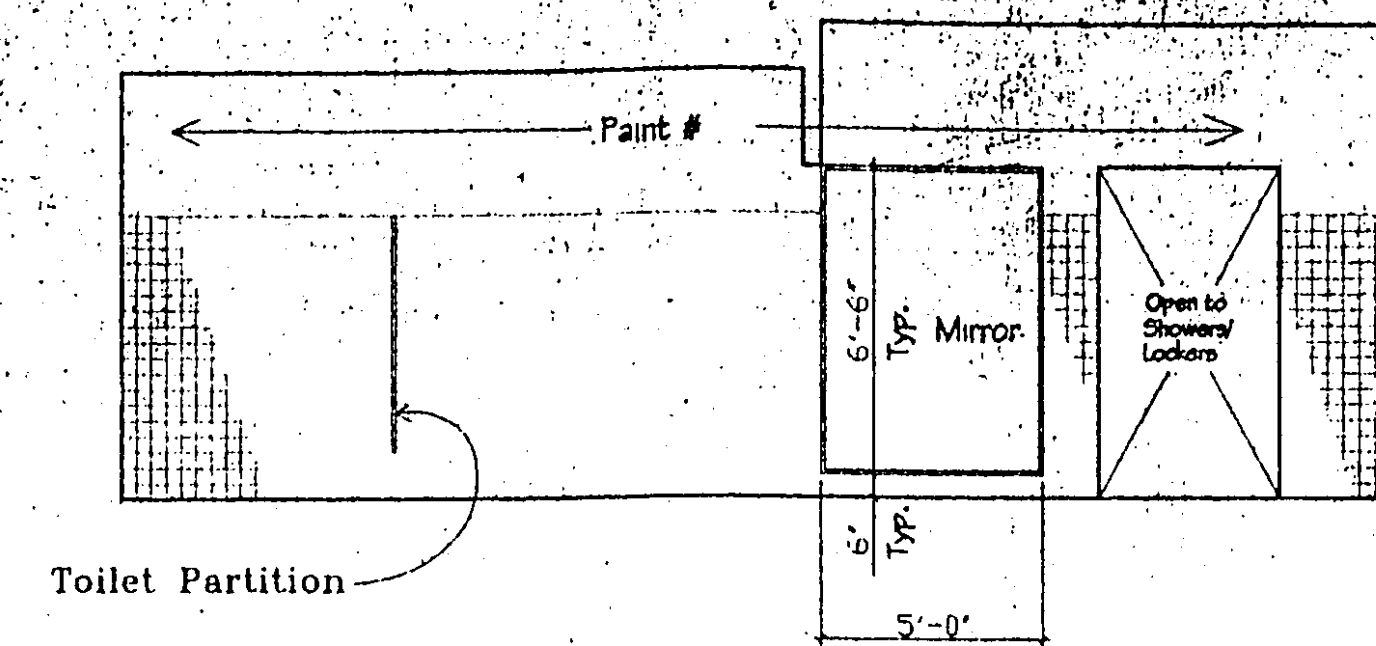

33 Men's Toilet


1/4"=1'-0"

1/4"=1'-0"

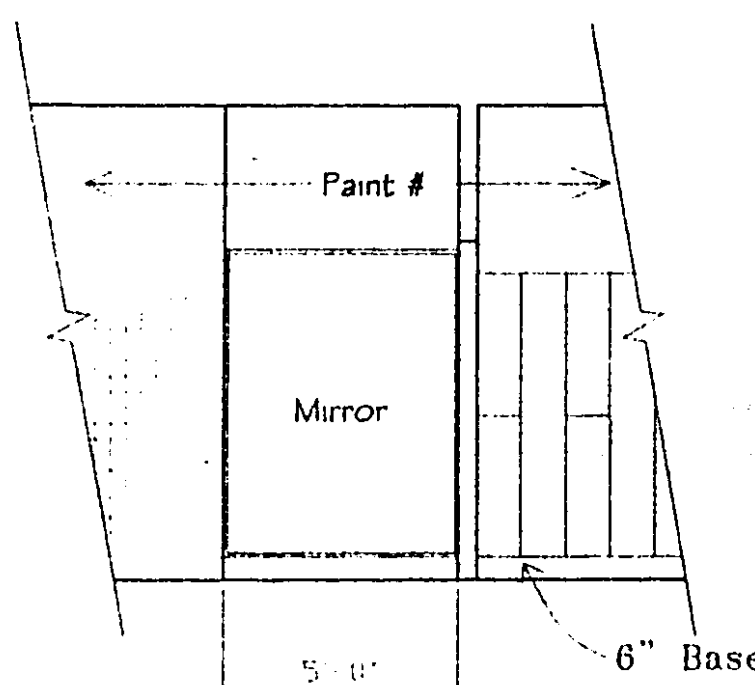


34 Women's Lockers


1/4"=1'-0"

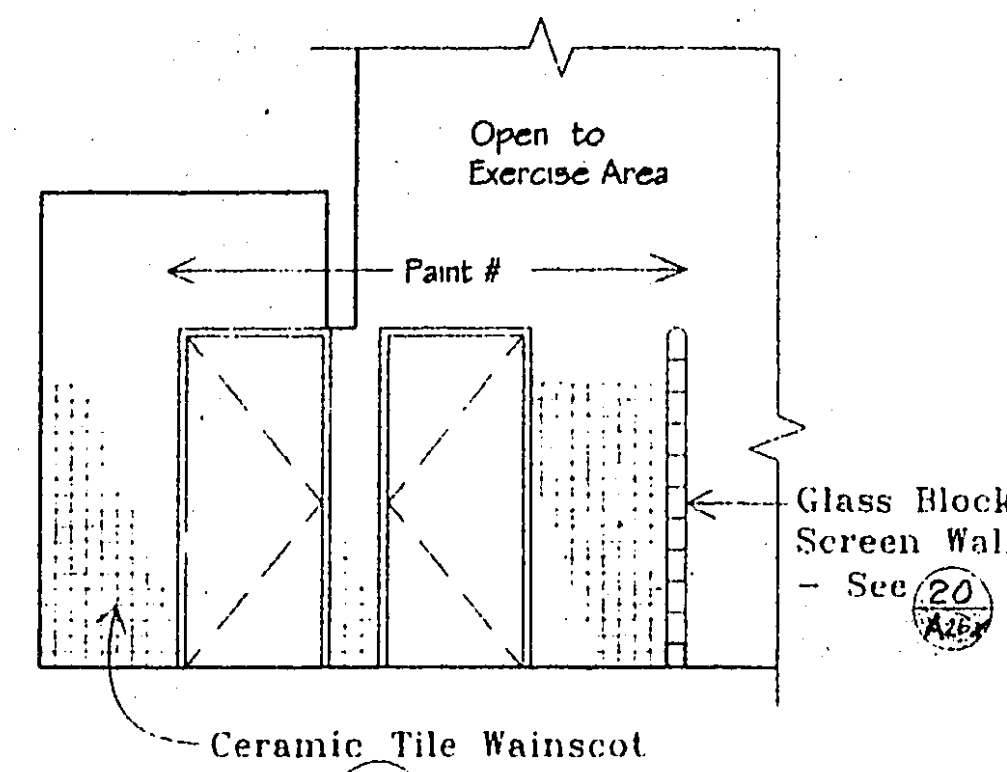

35 Vestibule at Lockers

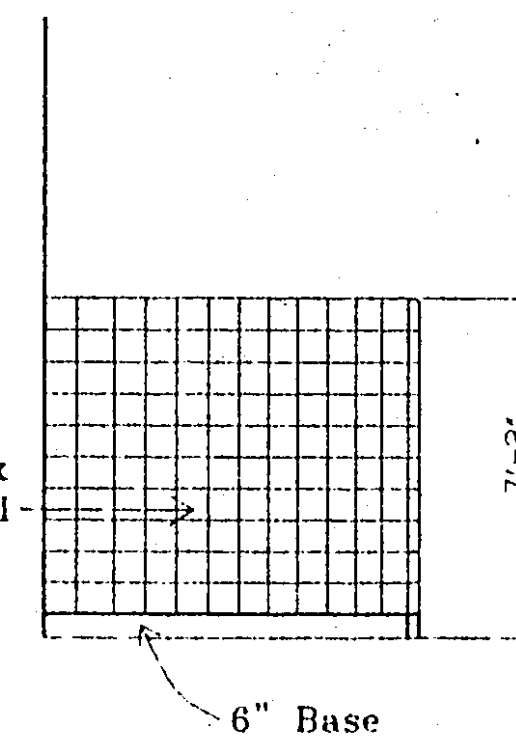


36

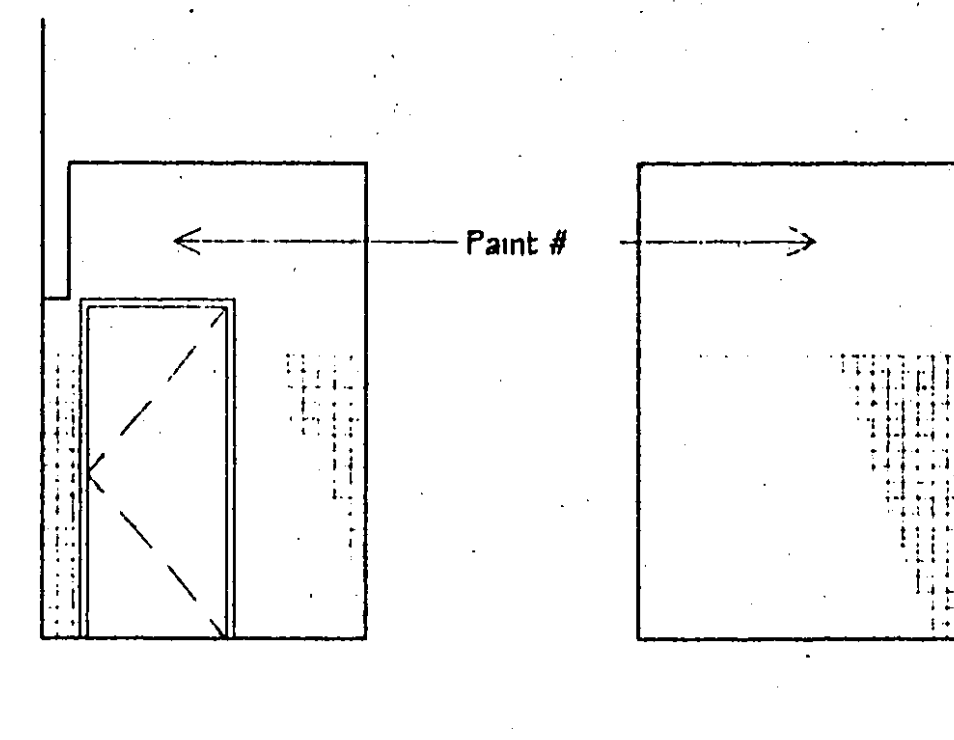

37


1/4"=1'-0"

Note: All walls adjacent to ceramic tile floors shall have ceramic tile wainscotting

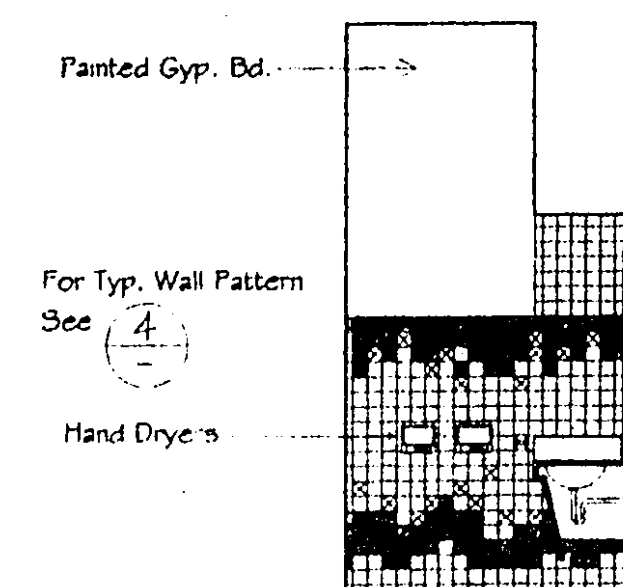


1 Vanity Elevations

1/4"= 1'-0"

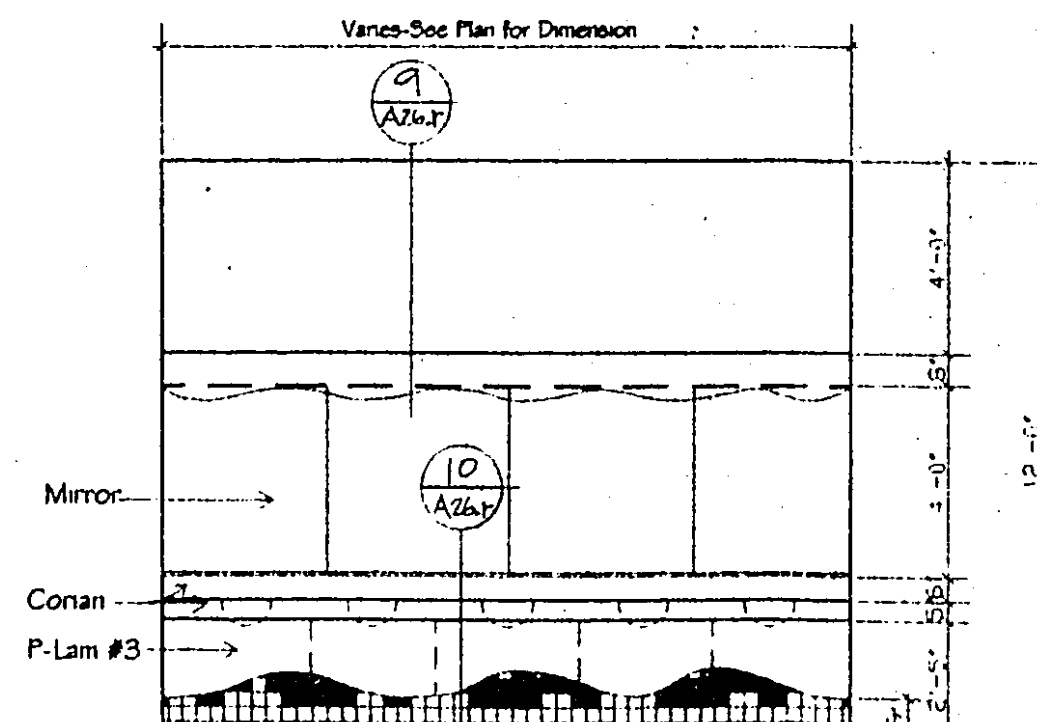


2 Vanity Elevations

1/4"= 1'-0"

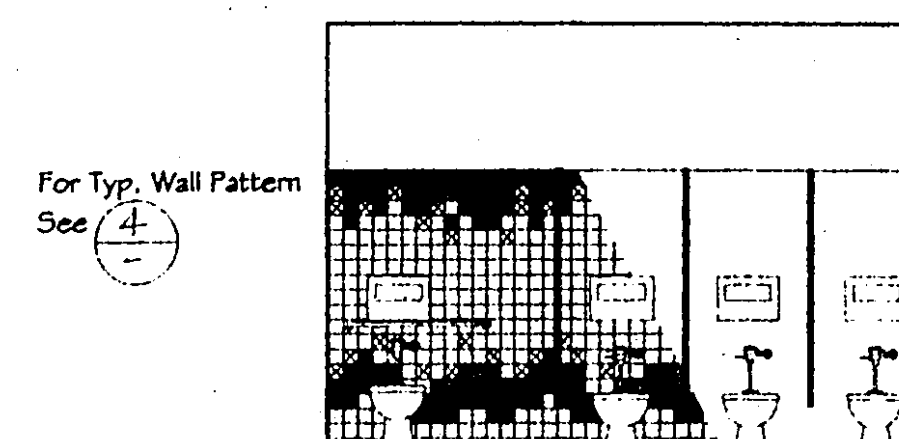


3 Women's Toilet Rm. Elevation

1/4"= 1'-0"

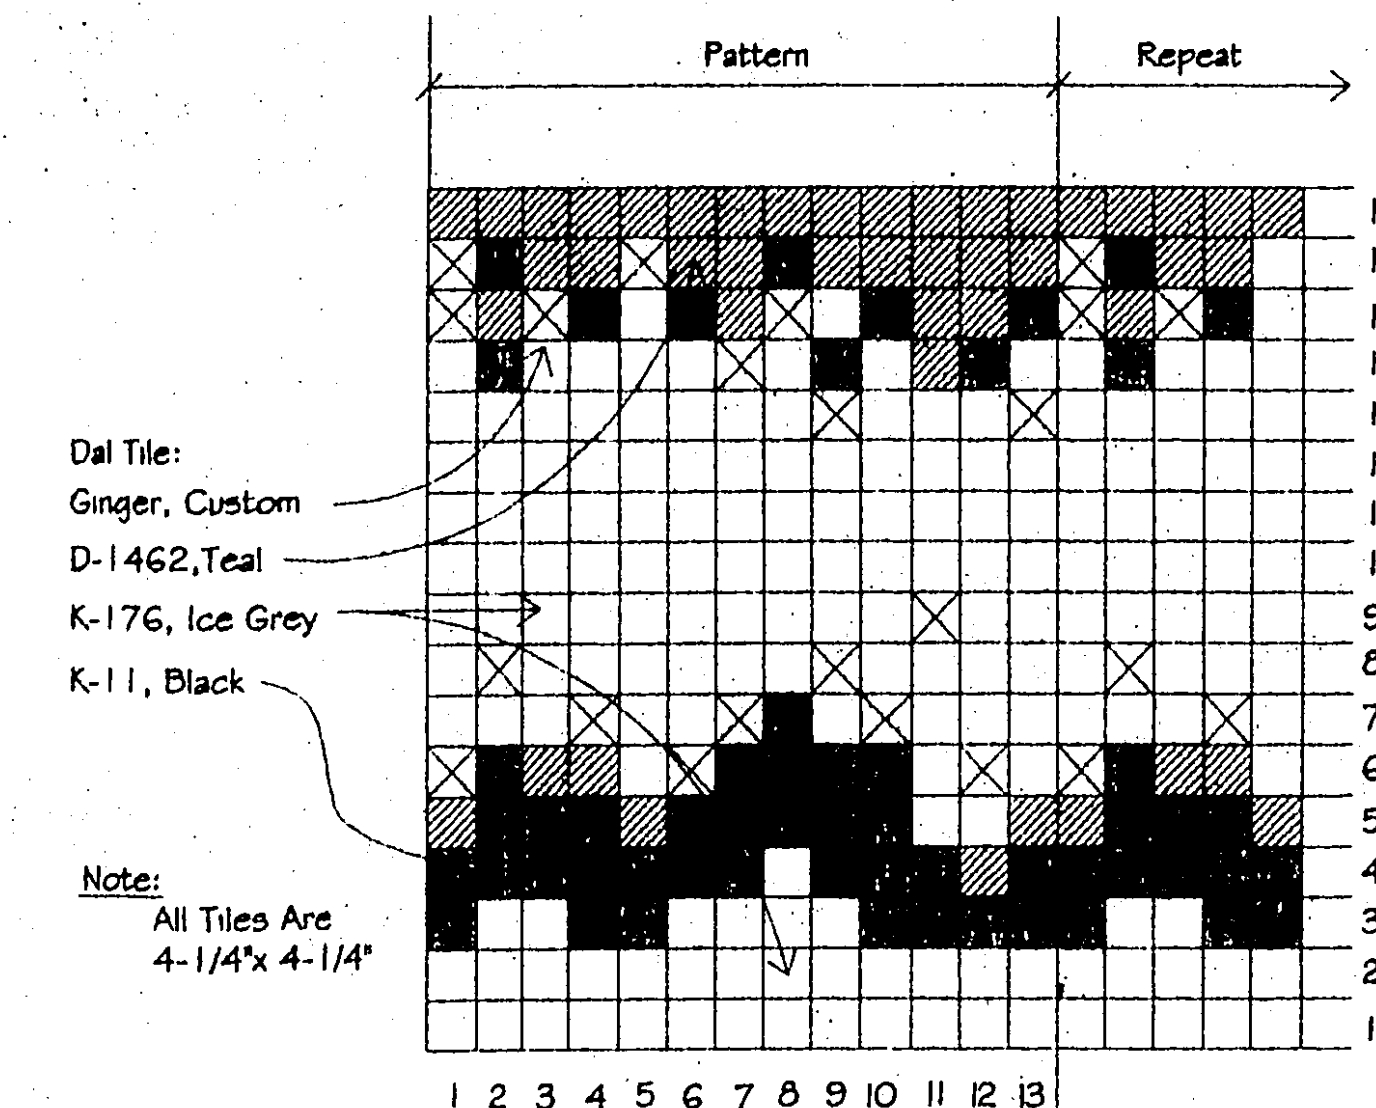


4 Typ. Wall Tile Pattern

3/4"= 1'-0"

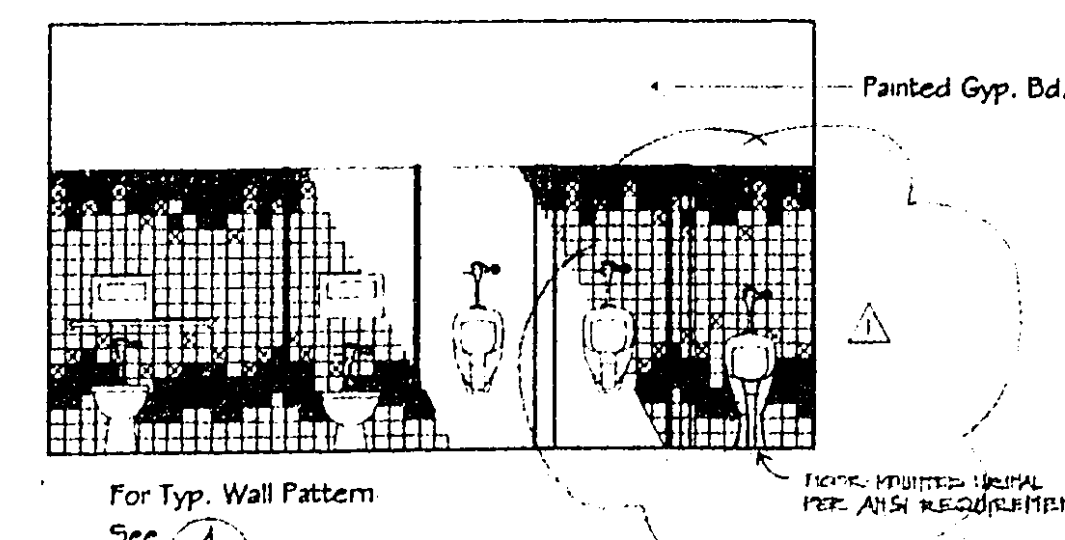


5 Men's Toilet Rm. Elevation

1/4"= 1'-0"

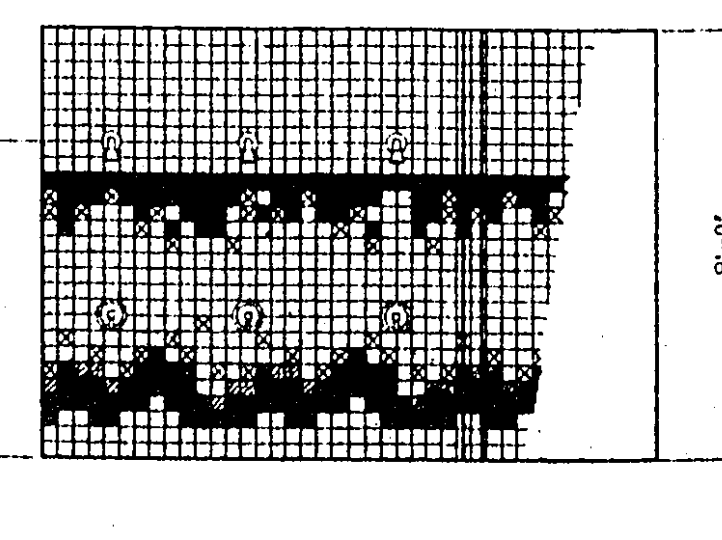


6 Shower Rm. Elevation

1/4"= 1'-0"

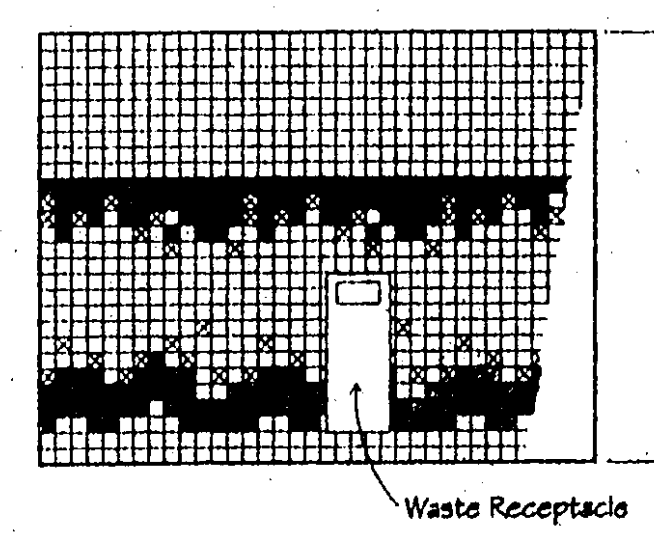

7 Shower Rm. Elevation

1/4"= 1'-0"

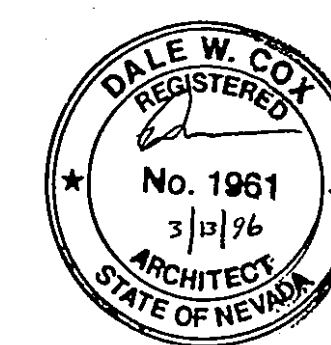

24 HOUR NAUTILUS
RENO 1
SKY MOUNTAIN DRIVE
RENO, NEVADA

COX & KROMYDAS
A.R.C.H.I.T.E.C.T.S


POST OFFICE BOX 450
TRUCKEE, CA 96160

(916) 587-6757
(916) 581-4422
FAX (916) 587-2108


THIS DRAWING HAS BEEN PREPARED BY COX & KROMYDAS ARCHITECTS FOR THE 24 HOUR NAUTILUS PROJECT. IT IS NOT TO BE USED FOR ANY OTHER PROJECTS IN OTHER LOCATIONS. COX & KROMYDAS ARCHITECTS SHALL BE RESPONSIBLE FOR THE DESIGN AND CONSTRUCTION OF THE 24 HOUR NAUTILUS PROJECT. NO PART OF THIS DRAWING SHALL BE REPRODUCED OR TRANSMITTED IN ANY FORM OR BY ANY MEANS, ELECTRONIC OR MECHANICAL, INCLUDING PHOTOCOPYING, RECORDING, OR BY ANY INFORMATION STORAGE AND RETRIEVAL SYSTEM, WITHOUT THE WRITTEN PERMISSION OF COX & KROMYDAS ARCHITECTS.

REVISIONS	DATE	BY	REASON
1	02/20/96	JLS	NOTED
2	02/20/96	JLS	NOTED
3	02/20/96	JLS	NOTED

A24.r

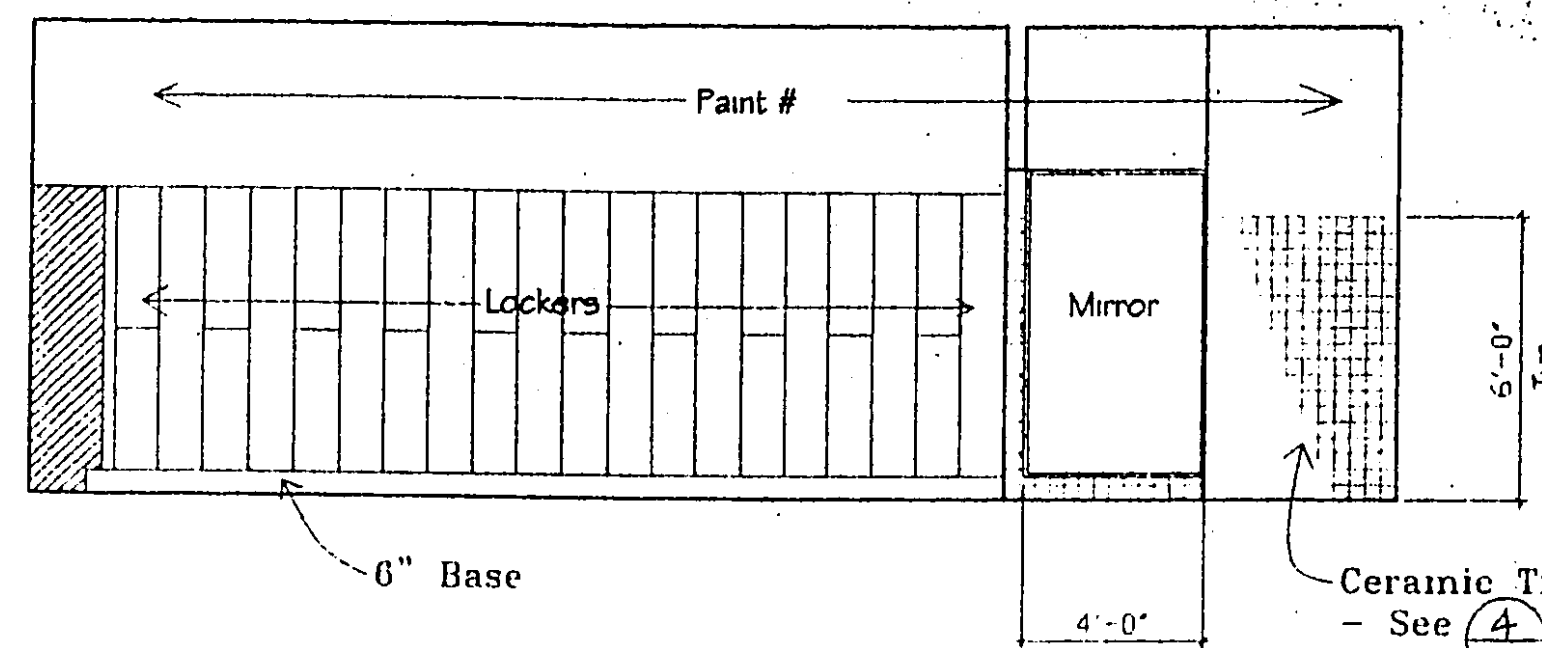

31 Men's Lockers

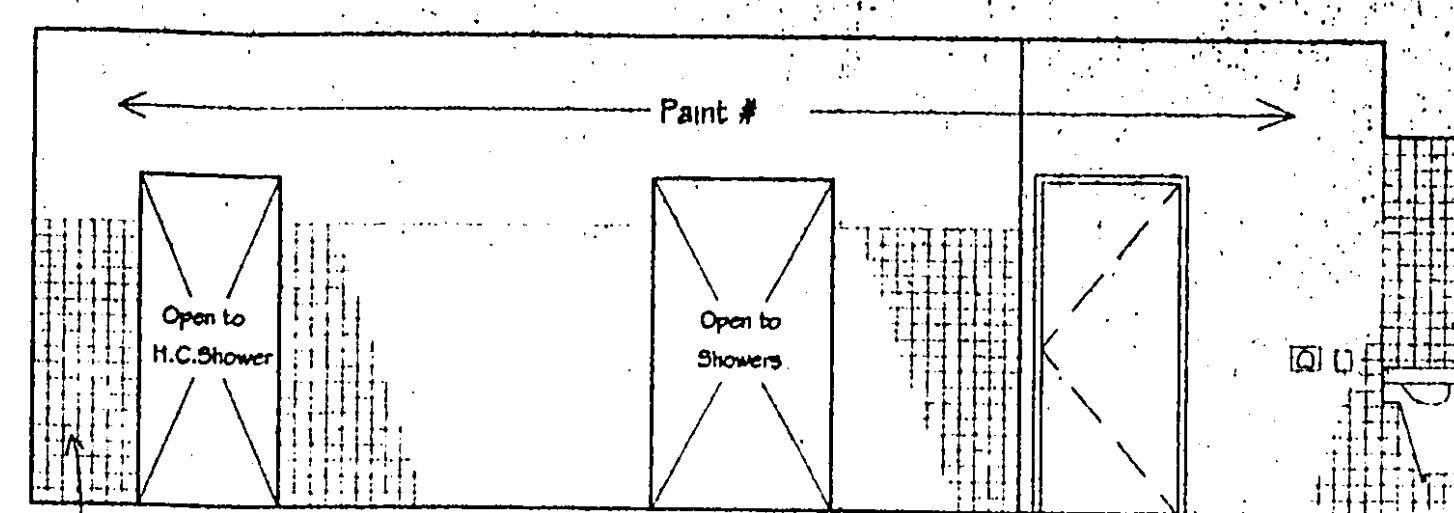

32 Men's Lockers

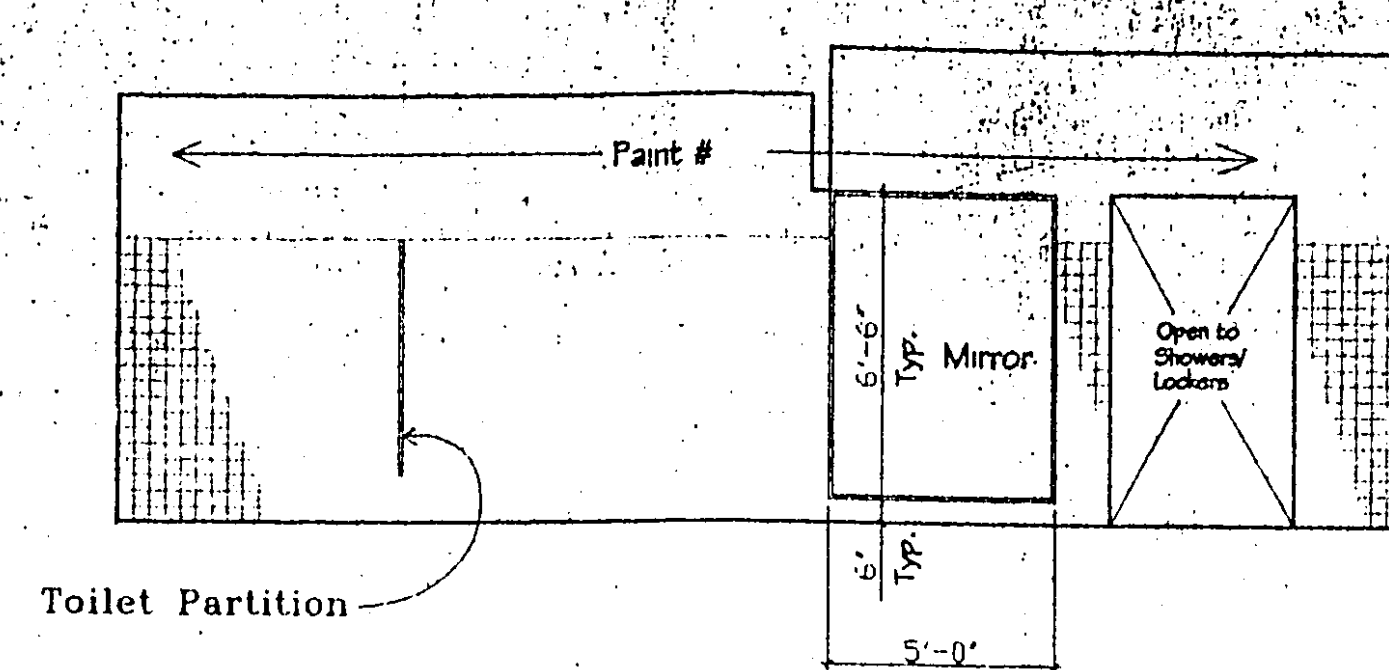


33 Men's Toilet

1/4"=1'-0"


1/4"=1'-0"

239521
0301-05
REVISED

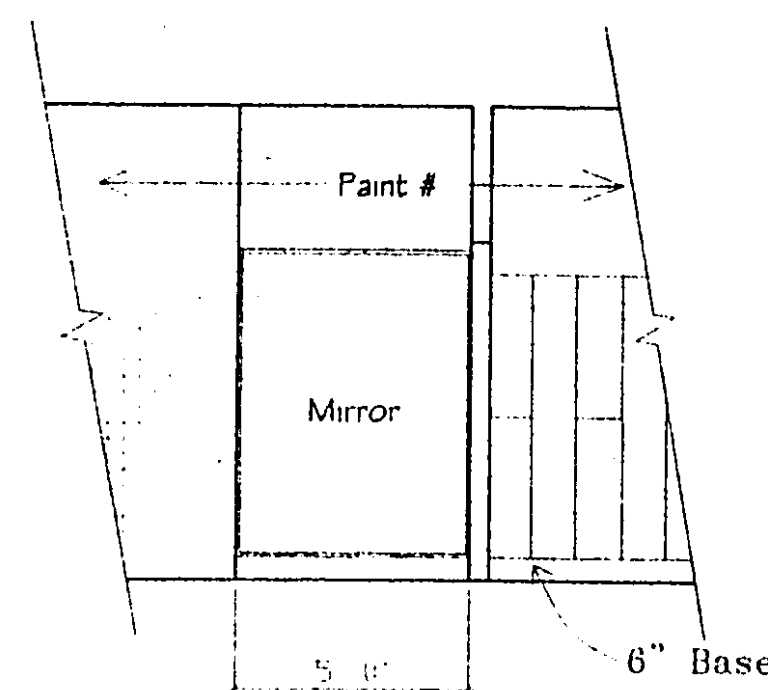


34 Women's Lockers


1/4"=1'-0"

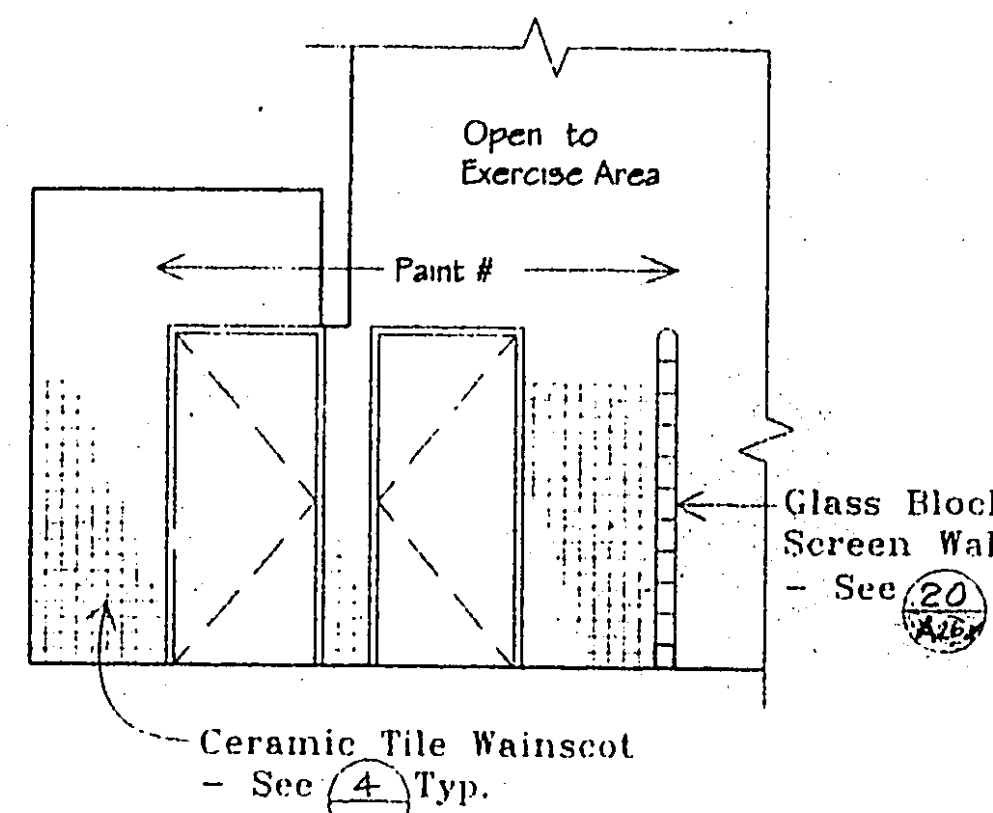

35 Vestibule at Lockers

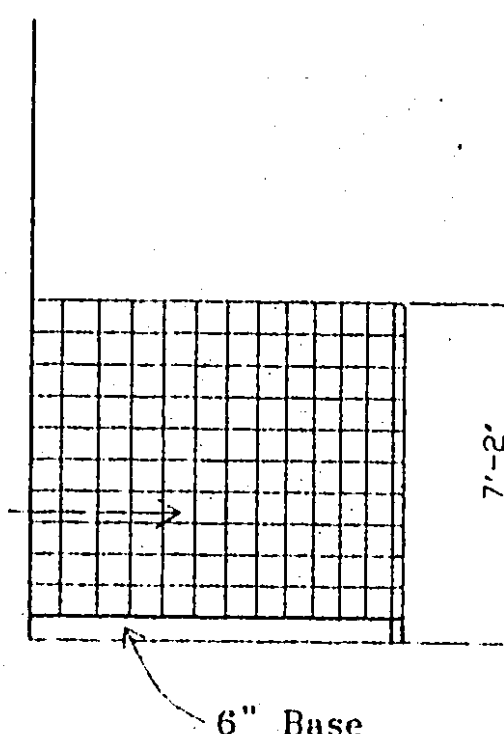

36

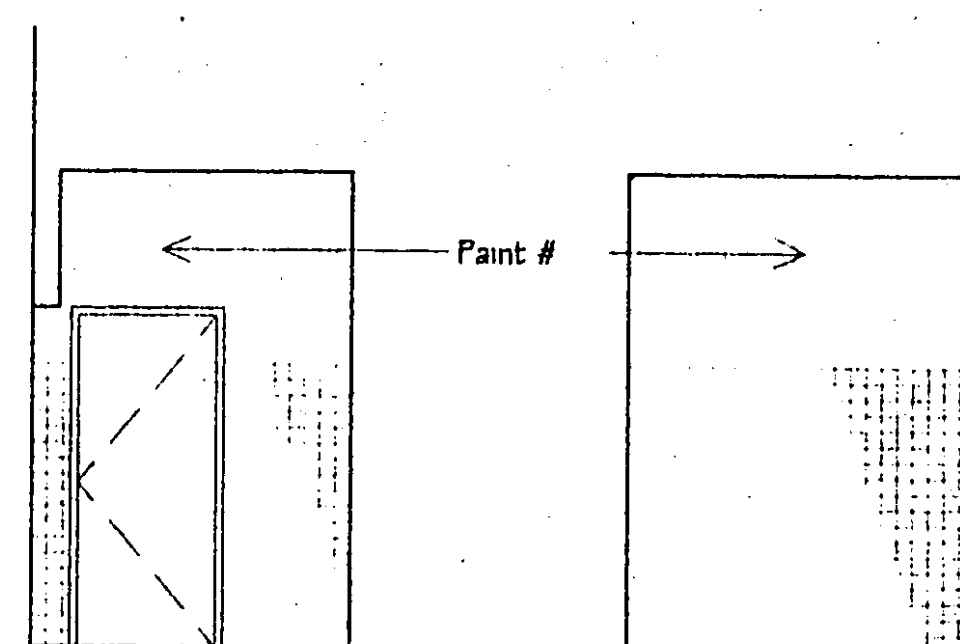


37

38


1/4"=1'-0"

Note: All walls adjacent to ceramic tile floors shall have ceramic tile wainscotting

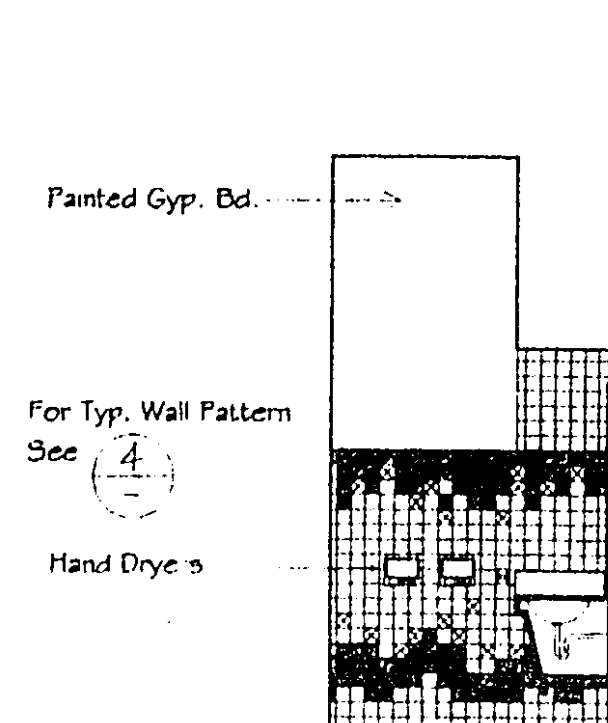


1 Vanity Elevations

1/4"= 1'-0"

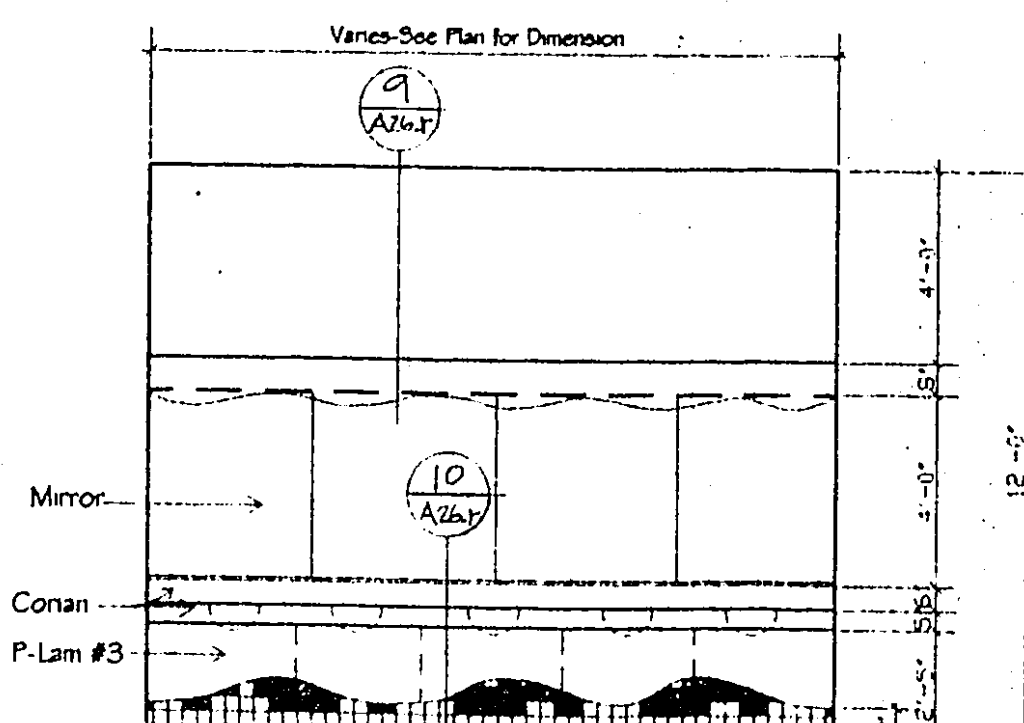


2 Vanity Elevations

1/4"= 1'-0"

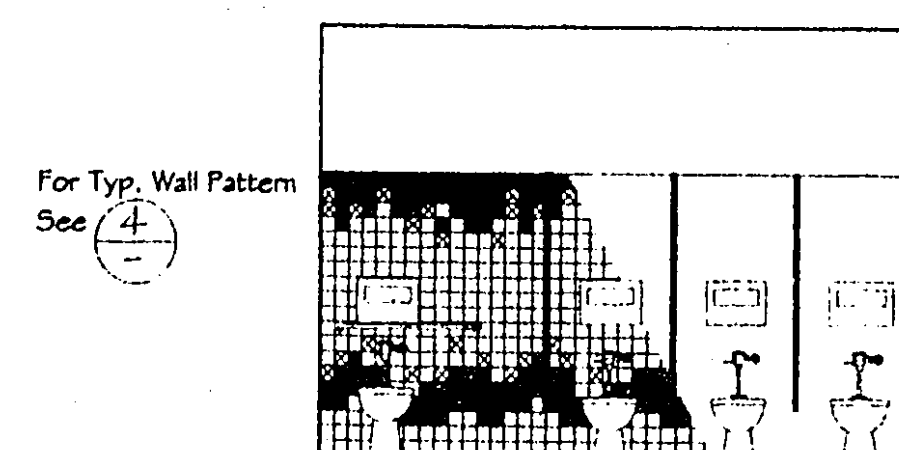


3 Women's Toilet Rm. Elevation

1/4"= 1'-0"

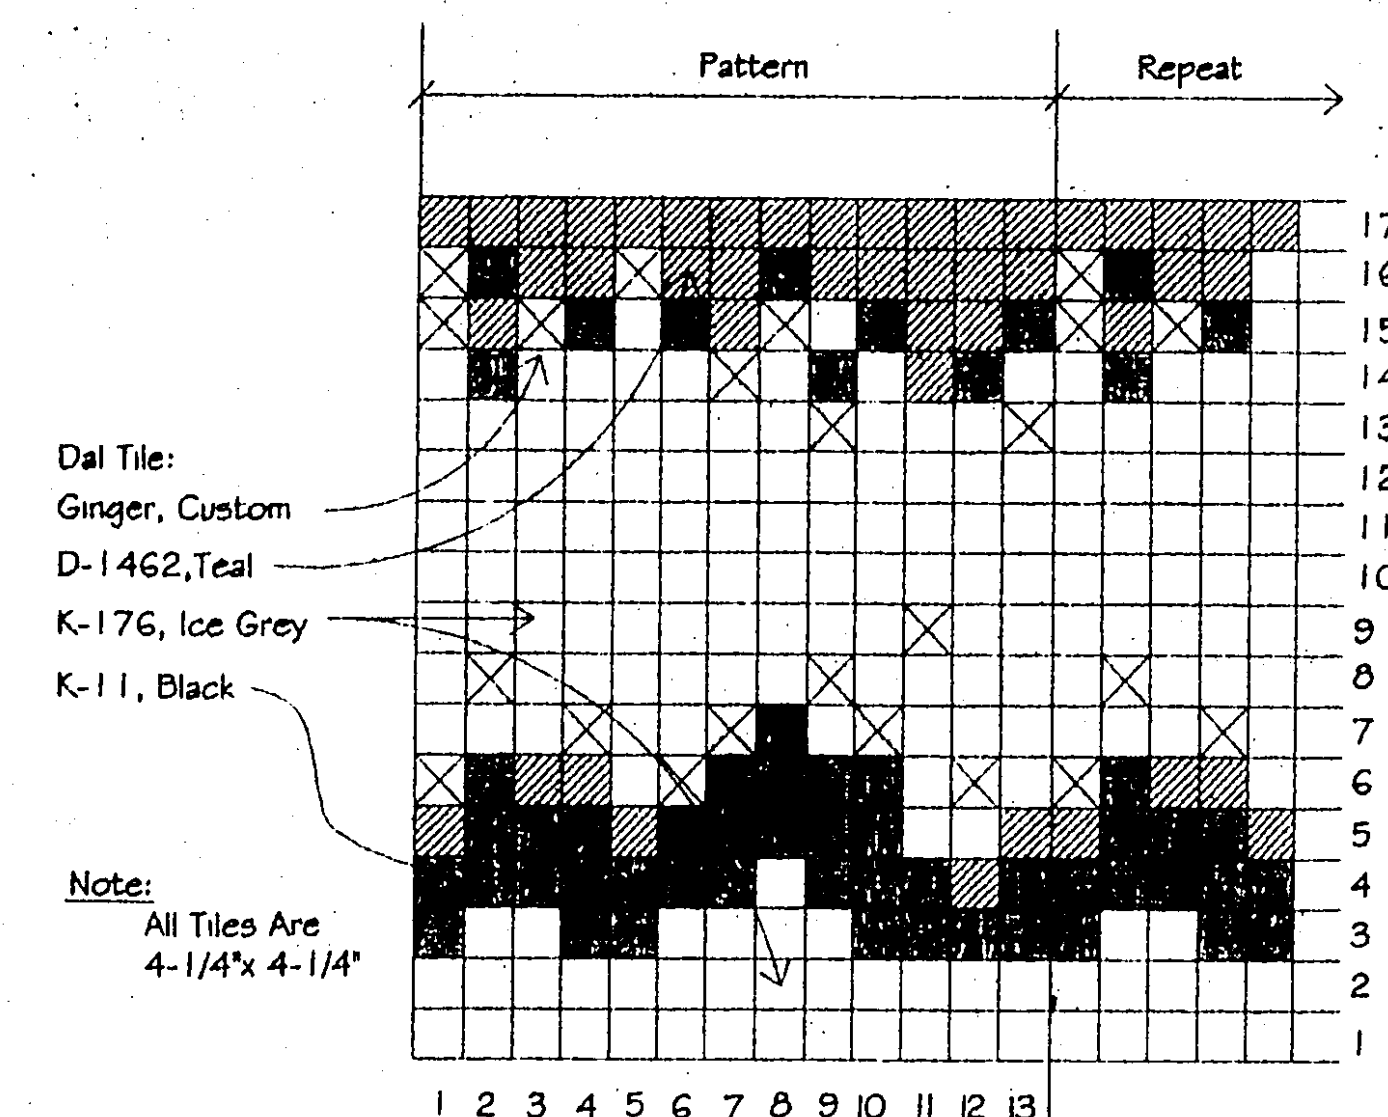


4 Typ. Wall Tile Pattern

3/4"= 1'-0"

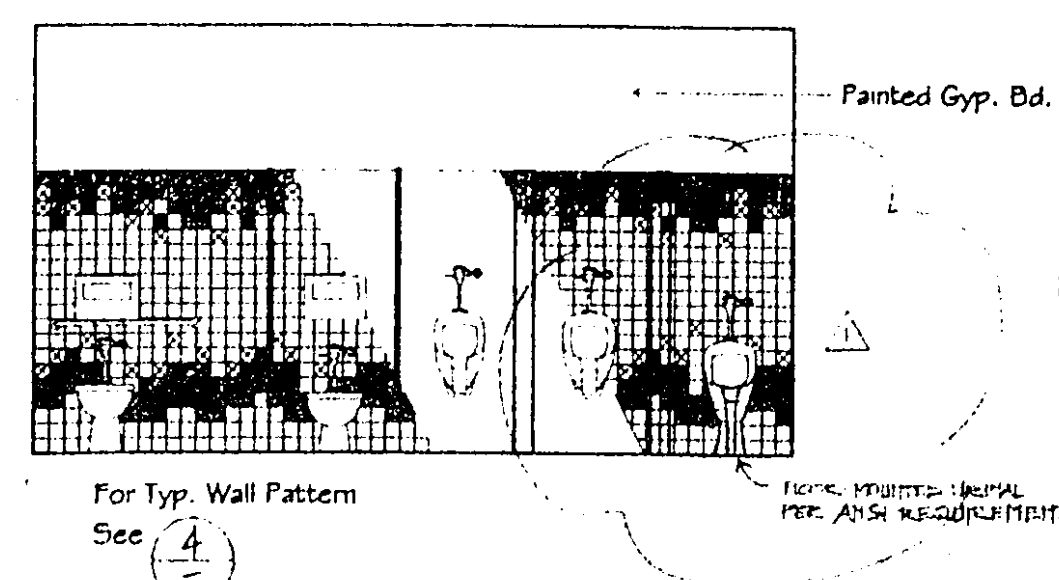


5 Men's Toilet Rm. Elevation

1/4"= 1'-0"

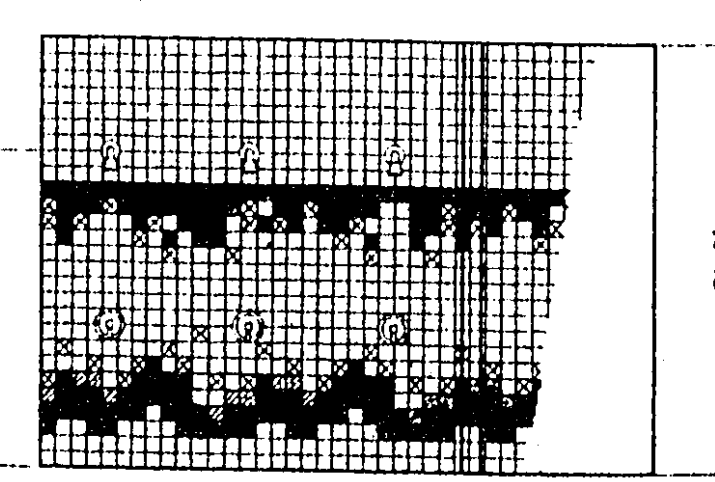


6 Shower Rm. Elevation

1/4"= 1'-0"

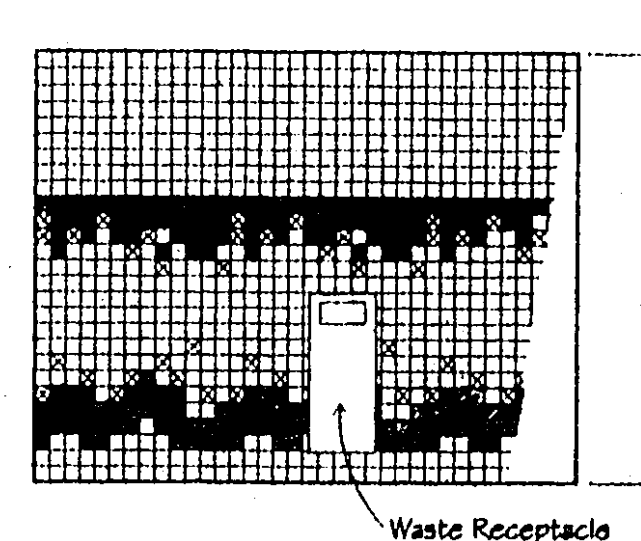

7 Shower Rm. Elevation

1/4"= 1'-0"

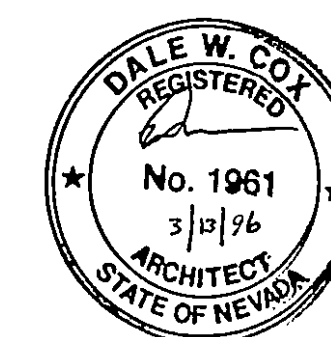

24 HOUR NAUTILUS
RENO 1
SKY MOUNTAIN DRIVE
RENO, NEVADA


COX & KROMYDAS
A.R.C.H.I.T.E.C.T.S.
POST OFFICE BOX 459
TRUCKEE, CA 96160

(916) 587-0757
(916) 581-4422
FAX (916) 587-3138

THESE DRAWINGS HAVE BEEN PREPARED BY COX & KROMYDAS ARCHITECTS FOR THE 24 HOUR NAUTILUS PROJECT. THEY ARE NOT SUITABLE FOR USE ON OTHER PROJECTS IN OTHER LOCATIONS, OR BY ANY OTHER INDIVIDUALS WITHOUT THE WRITTEN APPROVAL AND PARTICIPATION OF COX & KROMYDAS ARCHITECTS. REPRODUCTION IS PROHIBITED. ©

REVISIONS	DRAWN BY	JLS
1/15/96	DATE	02.20.96
2/15/96	SCALE	NOTED
	JOB NO.	9604

A24.r

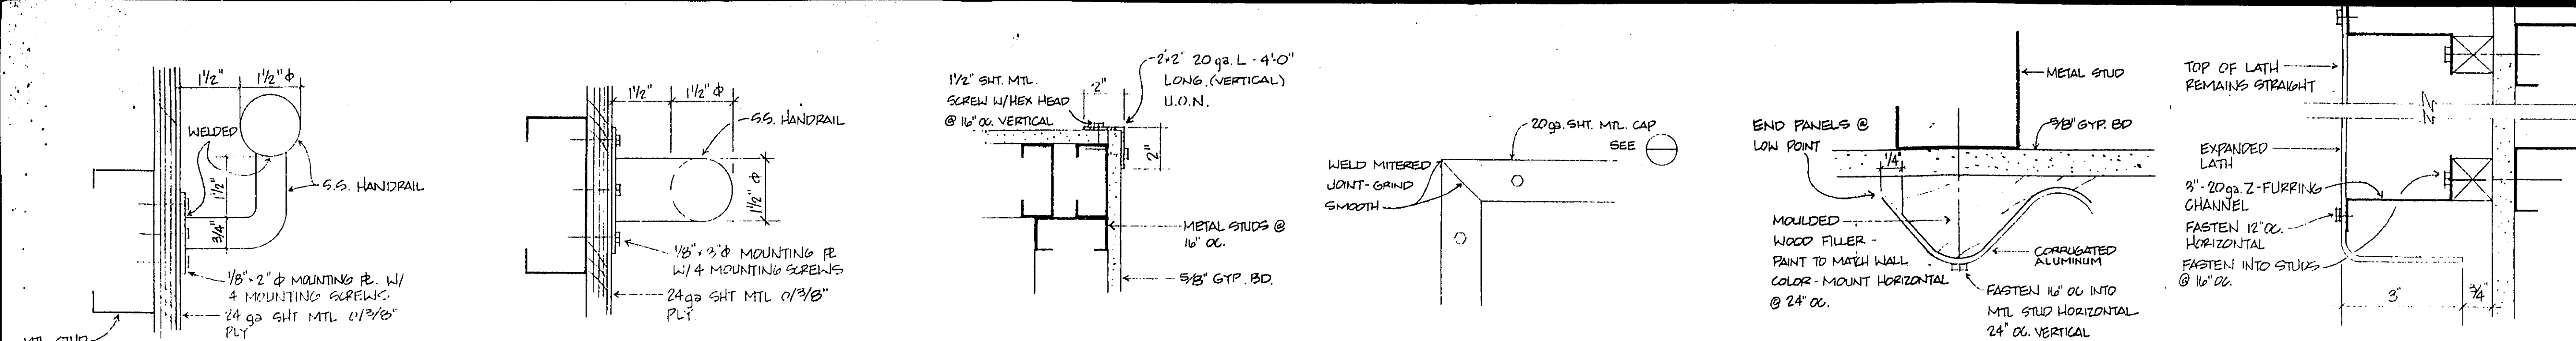

1 Handrail
1/2 FULL-SIZE


2 Handrail
1/2 FULL-SIZE

3 Wall Corner
3" = 1'-0"

4 Typical Sheet Metal Corner Cap
3" = 1'-0"

5 Corrugated Aluminum Mounting
FULL-SIZE

6 Expanded Lath Top & Bottom Conditions (Side sim. to bottom)
1/2 FULL-SIZE

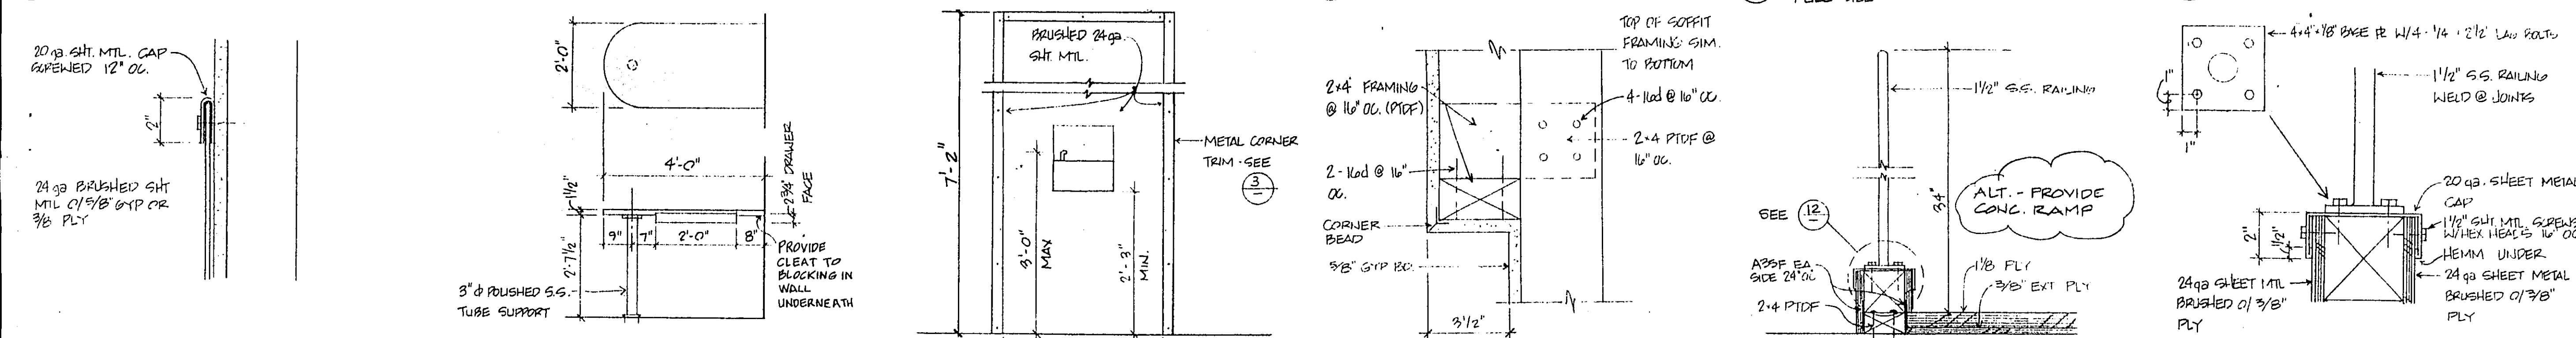

7 Brushed Metal Cladding
3" = 1'-0"


8 Sales Desk Section
1/2" = 1'-0"

9 Drinking Fountain Elevation
3/4" = 1'-0"

10 Soffit Section
3" = 1'-0"

11 Curb and Railing
1 1/2" = 1'-0"

12 Curb and Railing
3" = 1'-0"

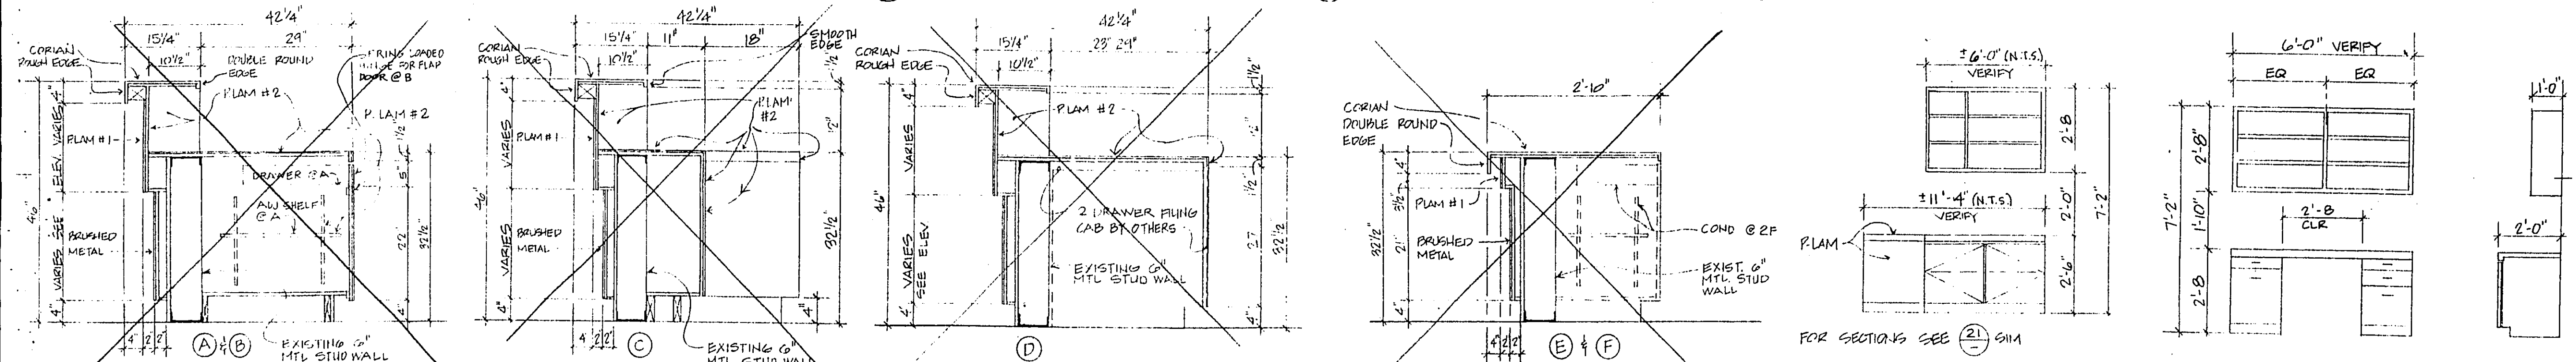

13 Front Desk Section
3/4" = 1'-0"


14 Front Desk Section
3/4" = 1'-0"

15 Front Desk Section
3/4" = 1'-0"

16 Front Desk Section
3/4" = 1'-0"

17 Cabinet Elevation @ Mgr Office
3/8" = 1'-0"

18 Cabinet Elevation @ Accounting
3/8" = 1'-0"

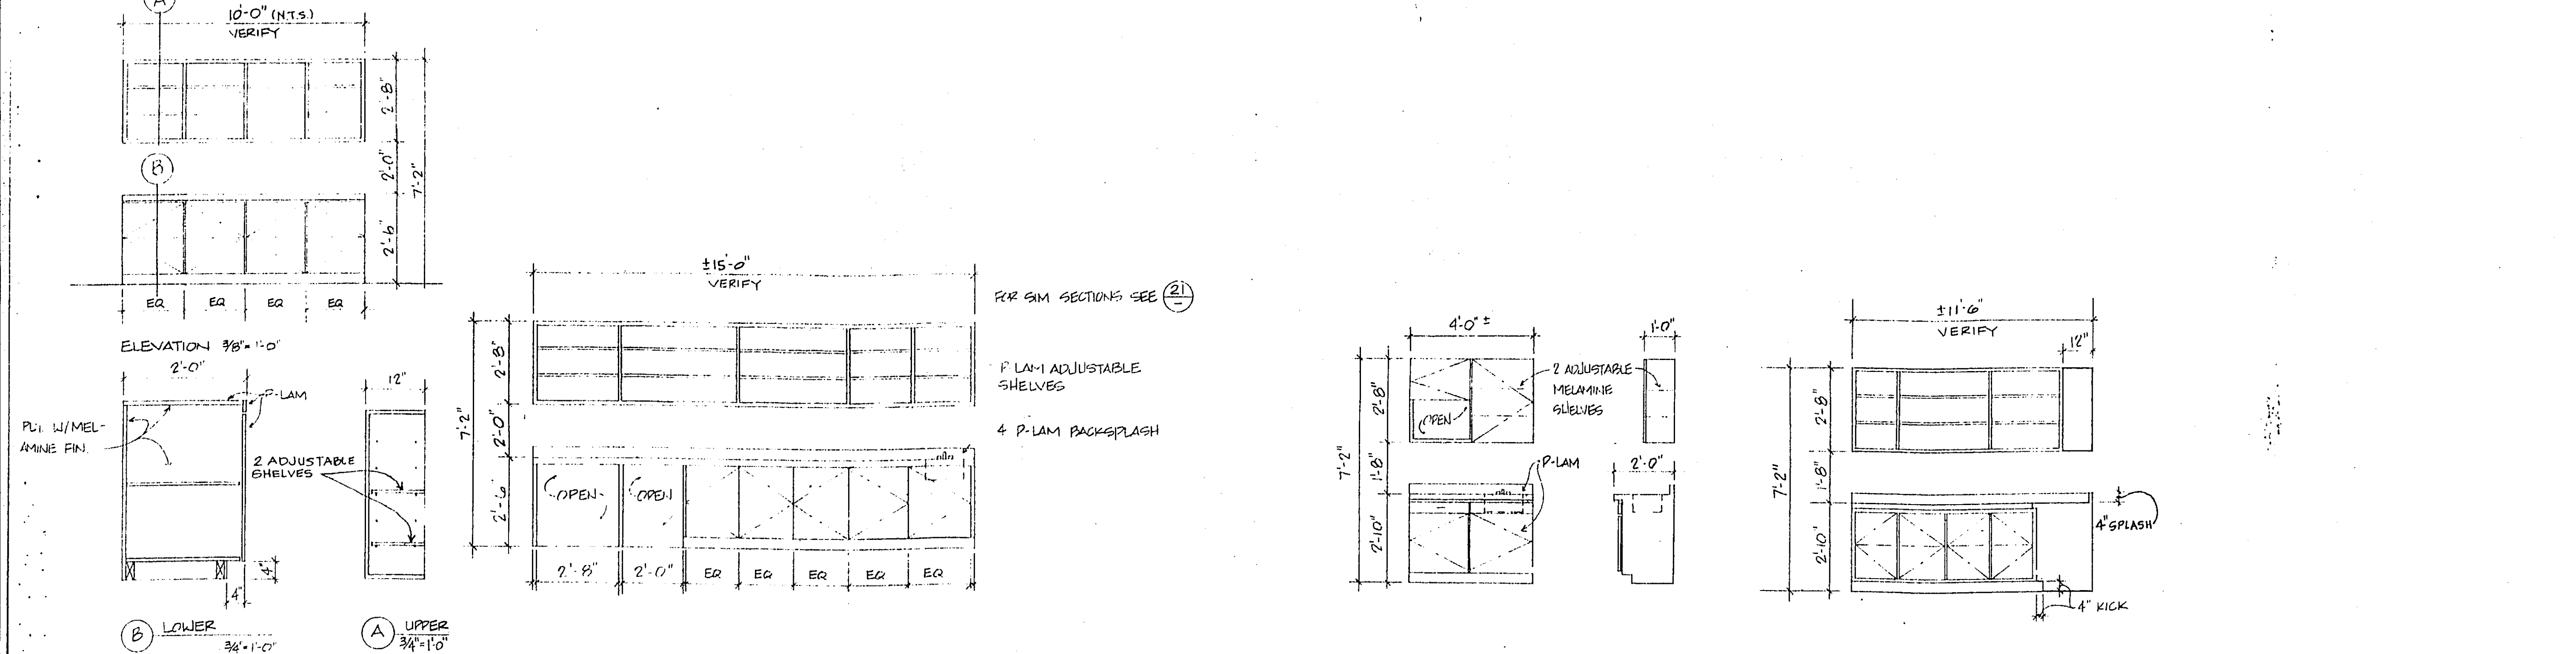


19 Cabinet Elevation & Sections
SCALE: AS NOTED
@ Asst. Mgr

20 Cabinet Elevation @ Babysitting
3/8" = 1'-0"

21 Cabinet Elevation @ Employee Rm
3/8" = 1'-0"

22 Cabinet Elevation @ Laundry Room
3/8" = 1'-0"

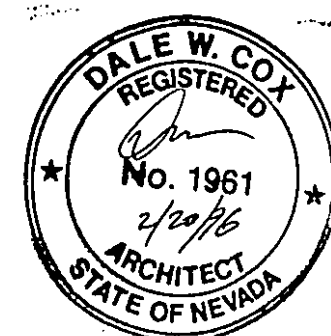

24 HOUR NAUTILUS
RENO 1
SKY MOUNTAIN DRIVE
RENO, NEVADA

COX & KROMYDAS
A.R.C.H.I.T.E.C.T.S


POST OFFICE BOX 459
TRUCKEE, CA 96150

(916) 587-6767
(916) 581-4422
FAX (916) 587-2136


THESE DRAWINGS HAVE BEEN PREPARED BY COX & KROMYDAS ARCHITECTS FOR THE 24 HOUR NAUTILUS PROJECT. THEY ARE NOT VALID FOR USE ON OTHER PROJECTS IN OTHER LOCATIONS OR BY ANY OTHER PERSONS WITHOUT THE WRITTEN APPROVAL AND PERMISSION OF COX & KROMYDAS ARCHITECTS. REPRODUCTION IS PROHIBITED.

REVISIONS	DRAWN BY	JLS
	DATE	02.20.96
	SCALE	NOTED
	JOB NO.	9604


A25.r

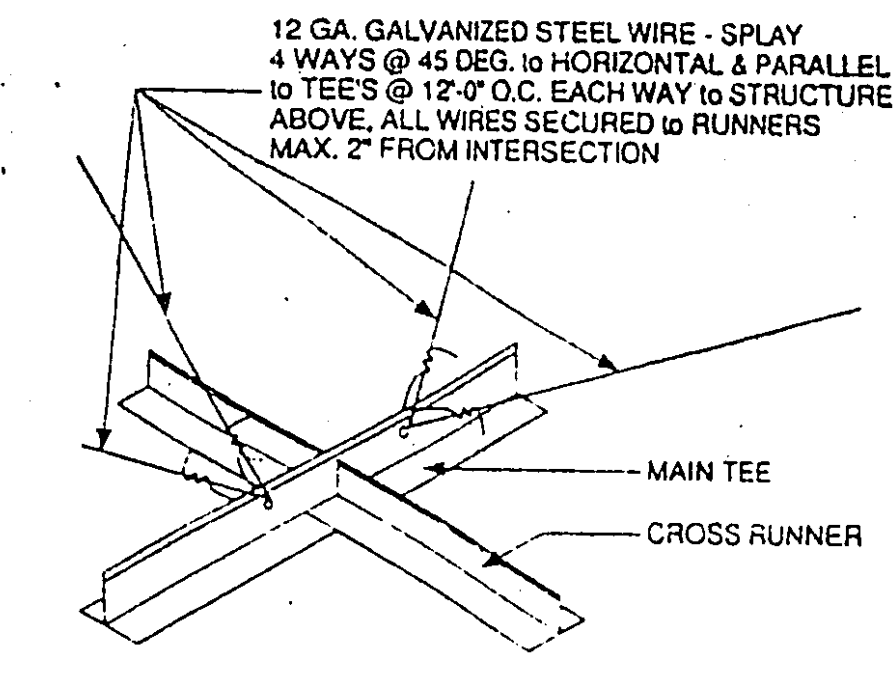


1 Ceiling Bracing

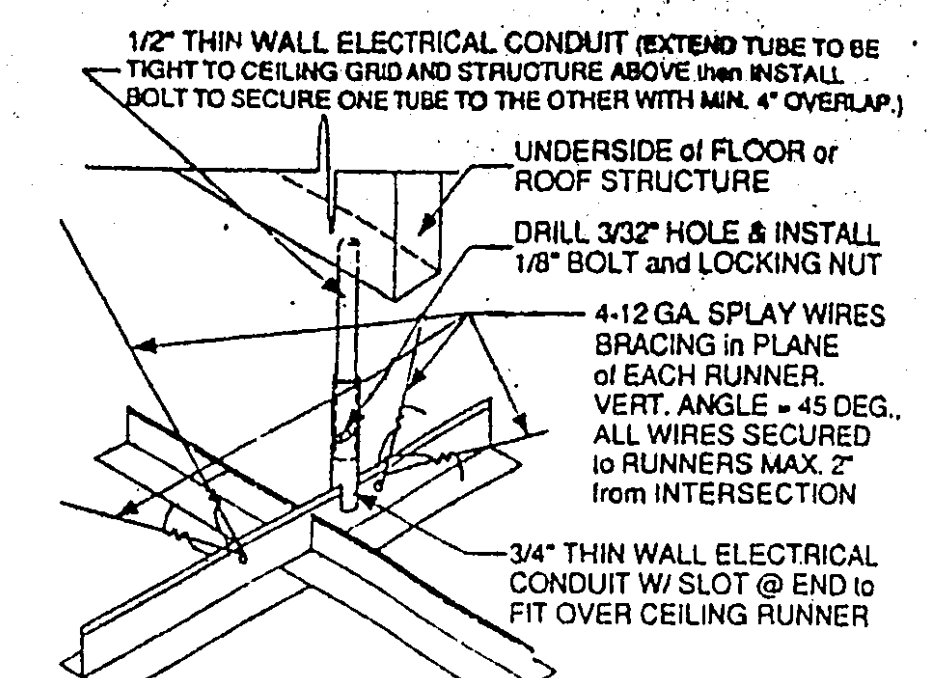


2 Typical Ceiling Bracing

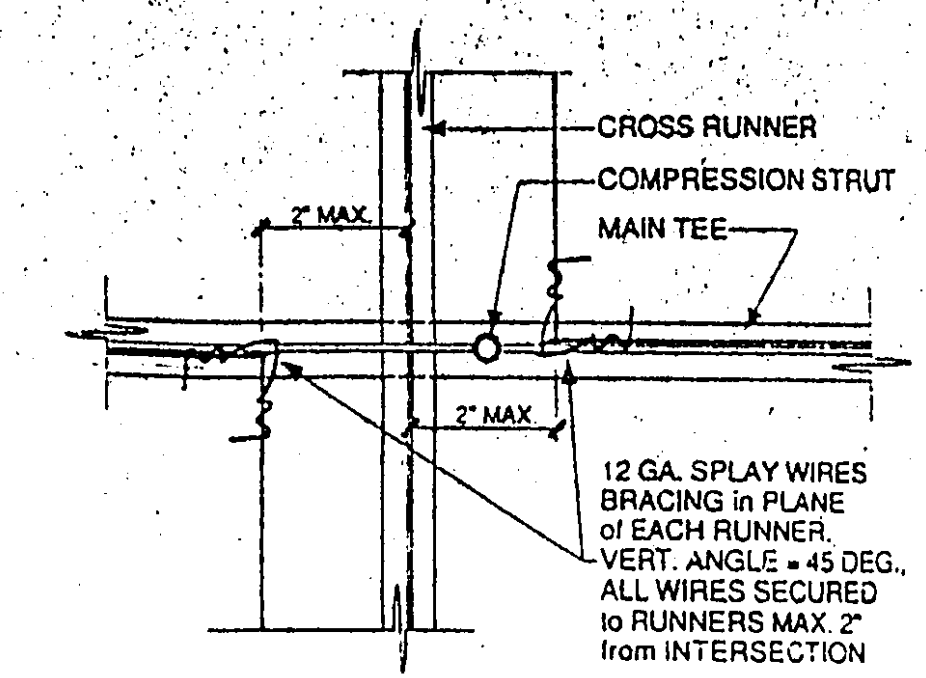


3 Ceiling Grid at Compression Strut

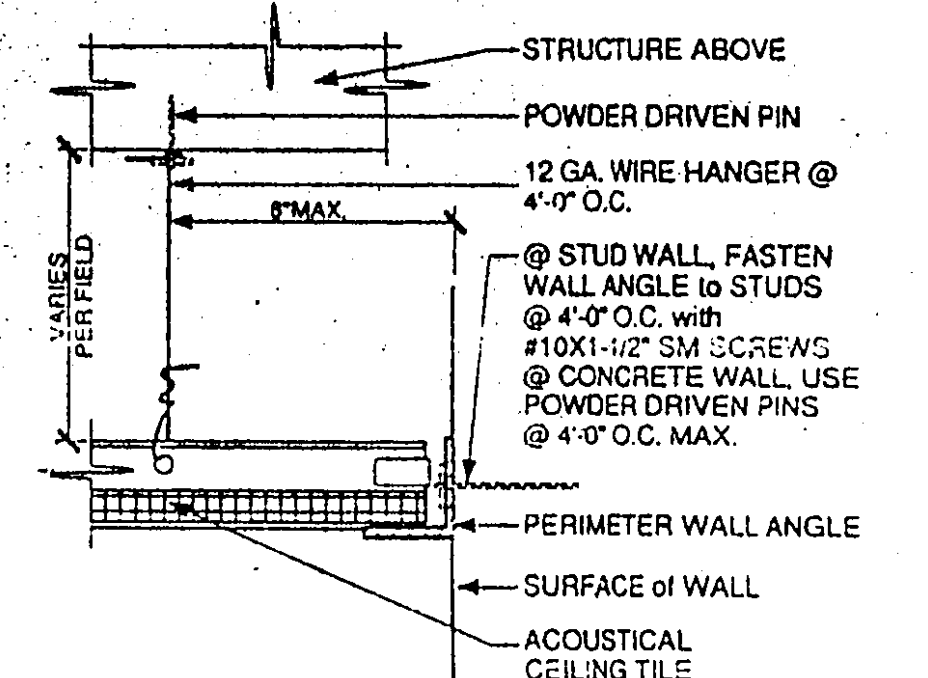


4 Ceiling Bracing

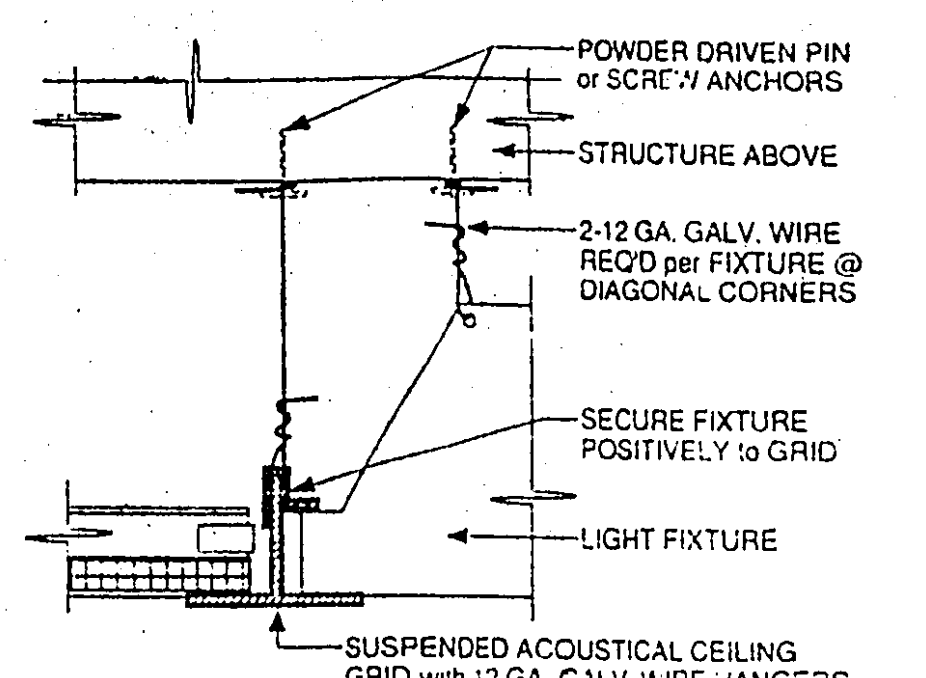


5 Light Fixture Bracing

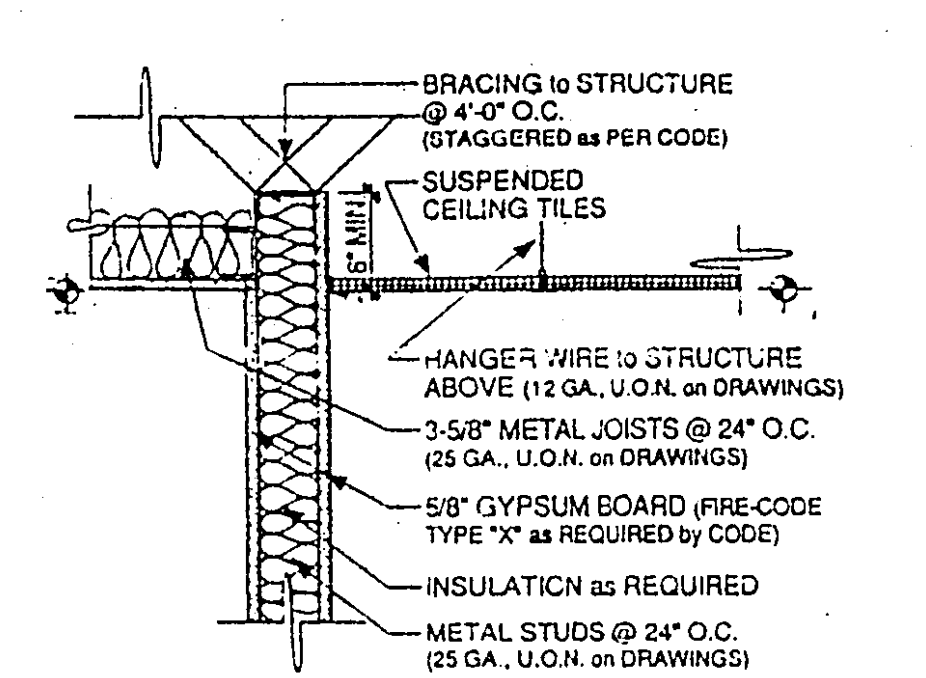


6 Wall at Susp. & Gyp. Bd. Ceiling

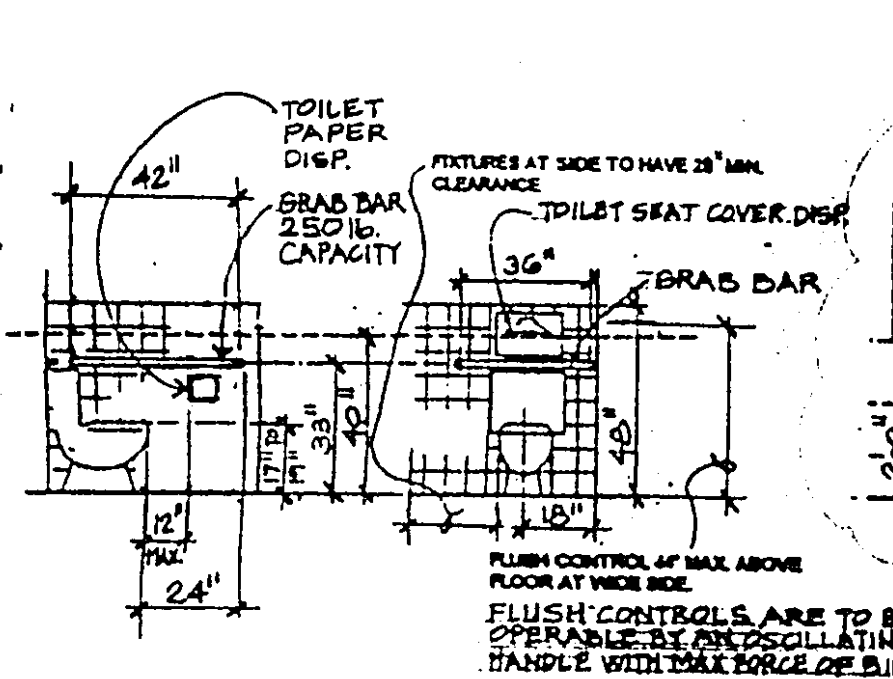


7 Accessory Mounting Requirements

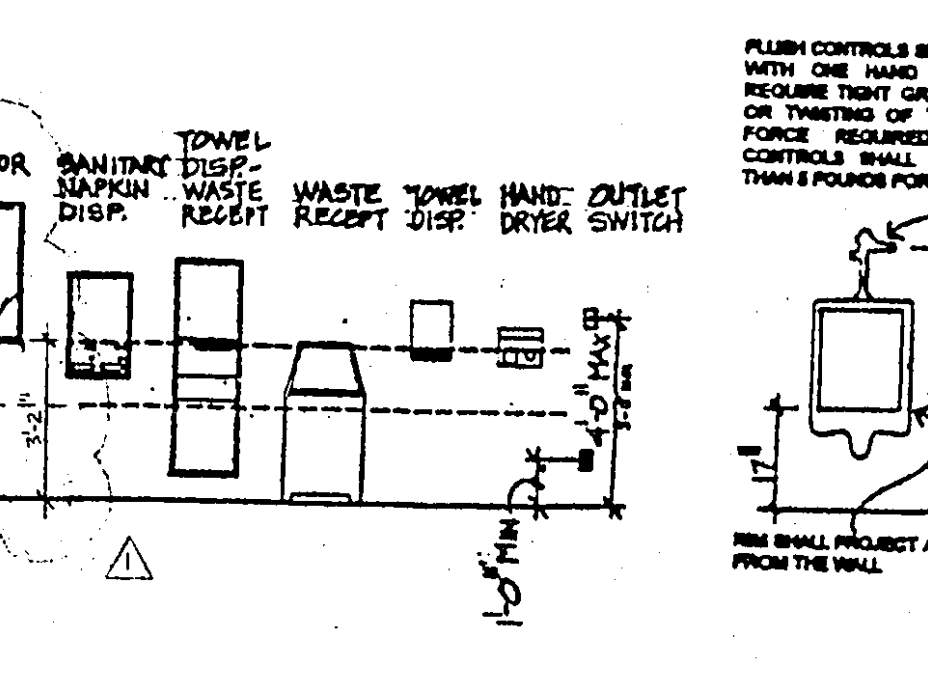


8 Handicap Signage

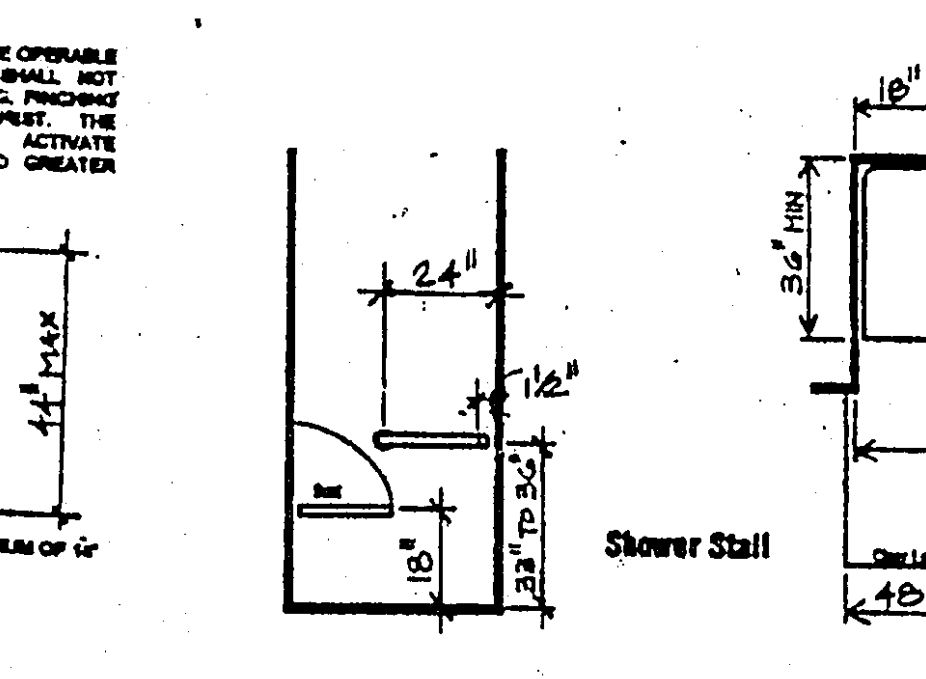


9 Soffit at Lavatory

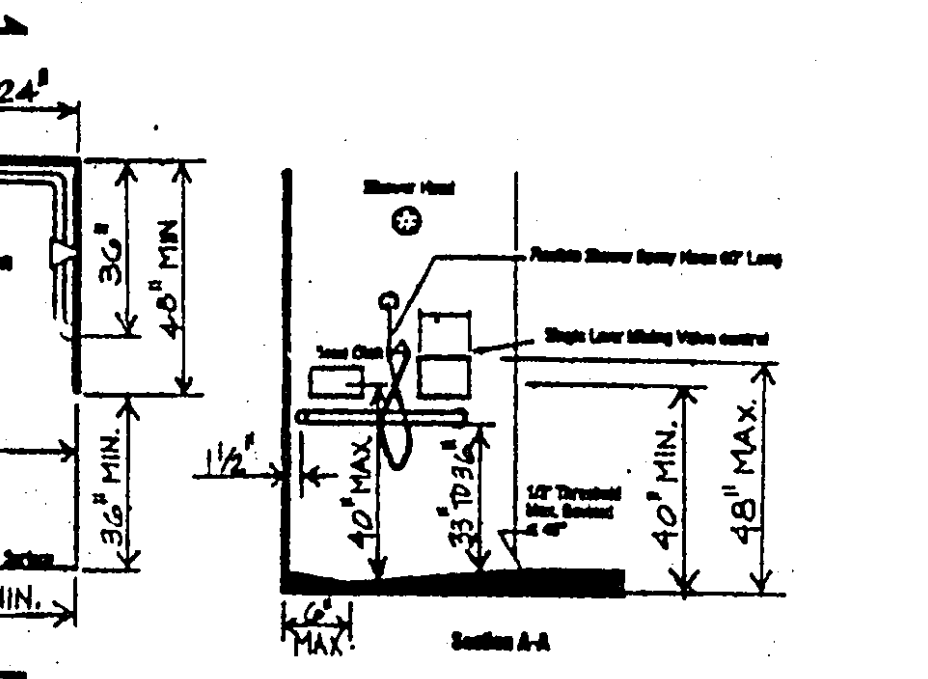


10 Lavatory Counter

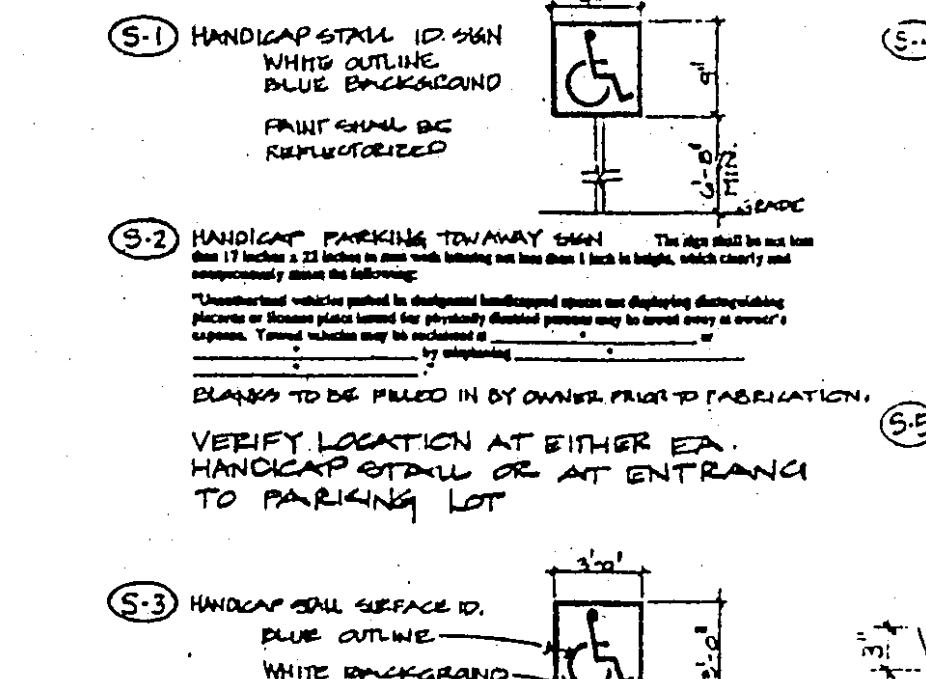


11 Drinking Fountain

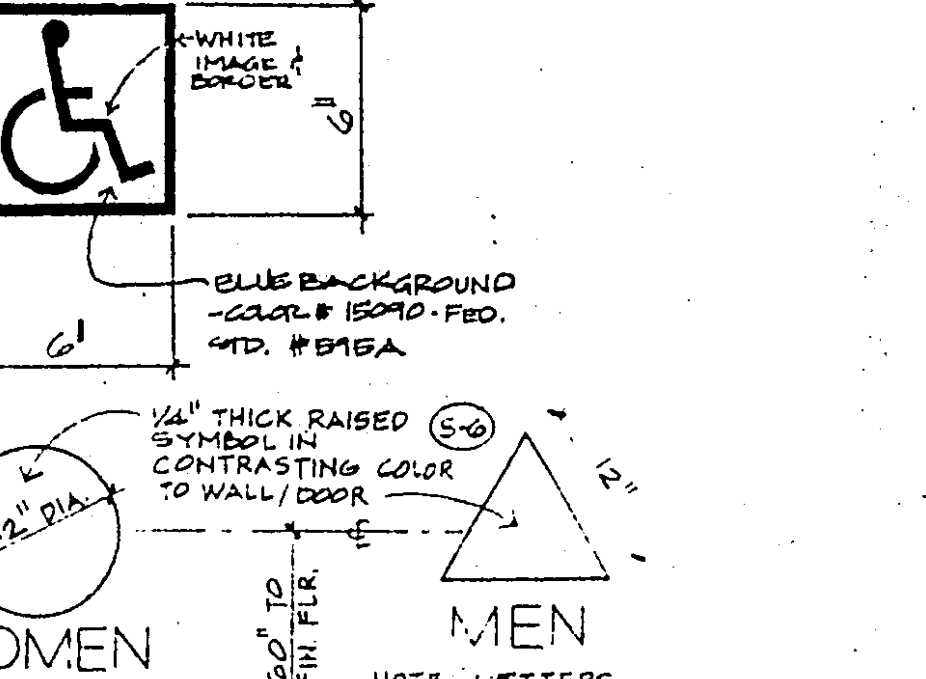


12 Stair Section

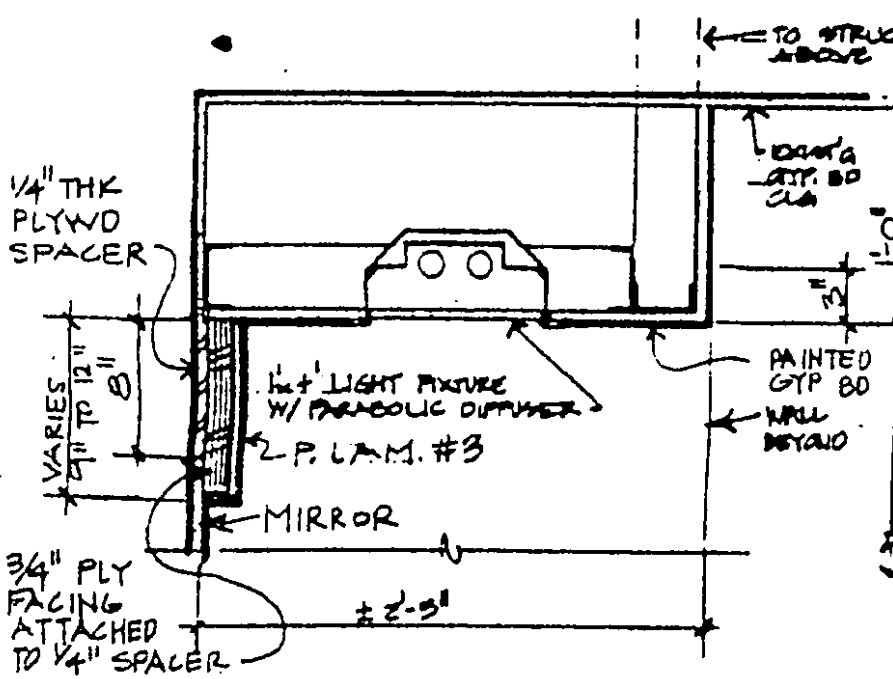


13 Entry Floor Mat

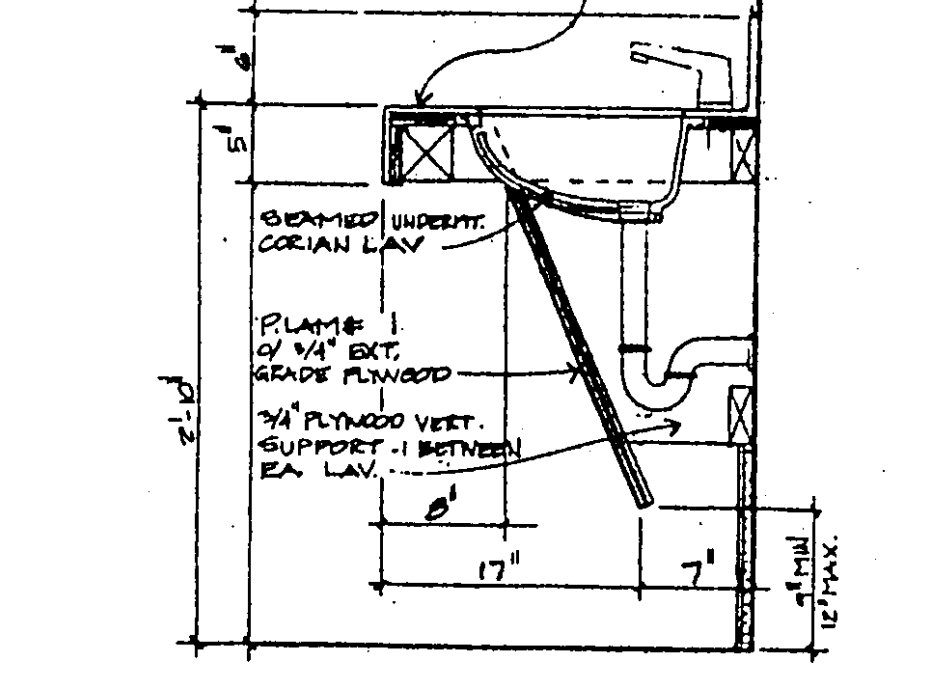


14 Wall to Suspended Ceiling

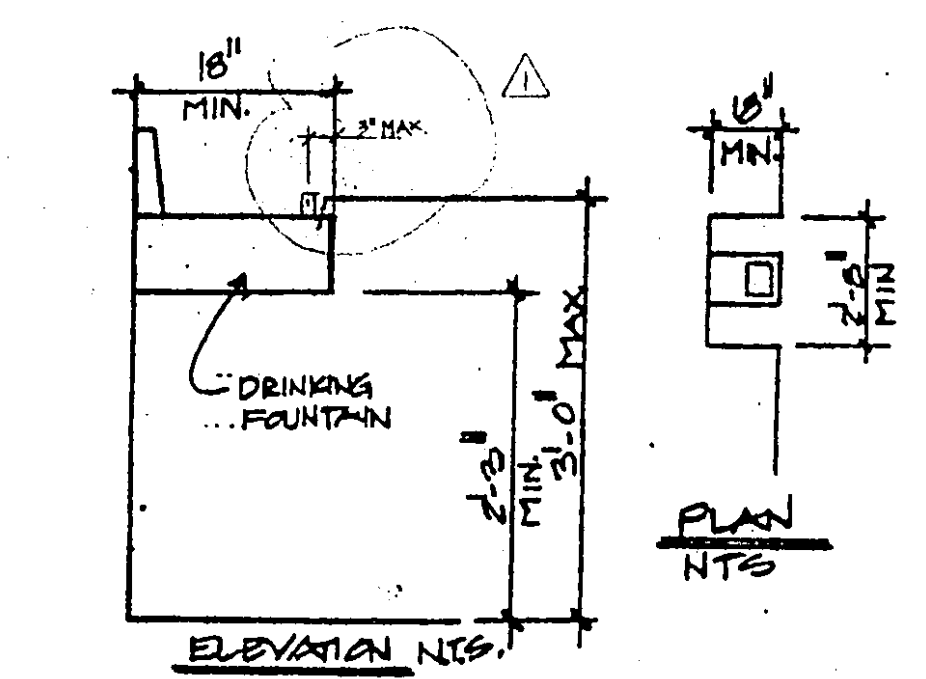


15 Wall at Floor

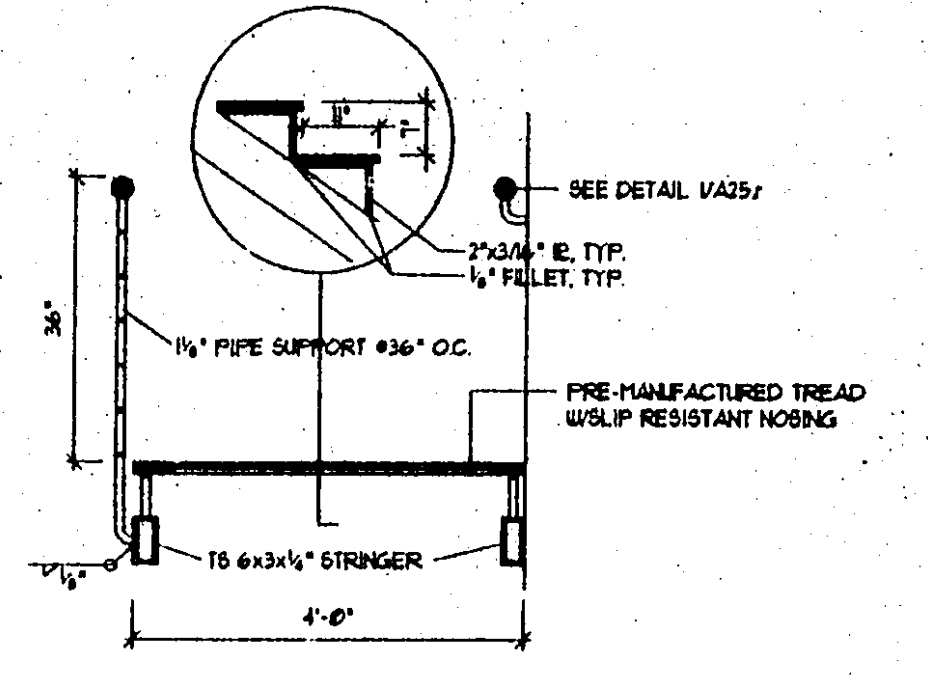


16 Sidelight Jamb

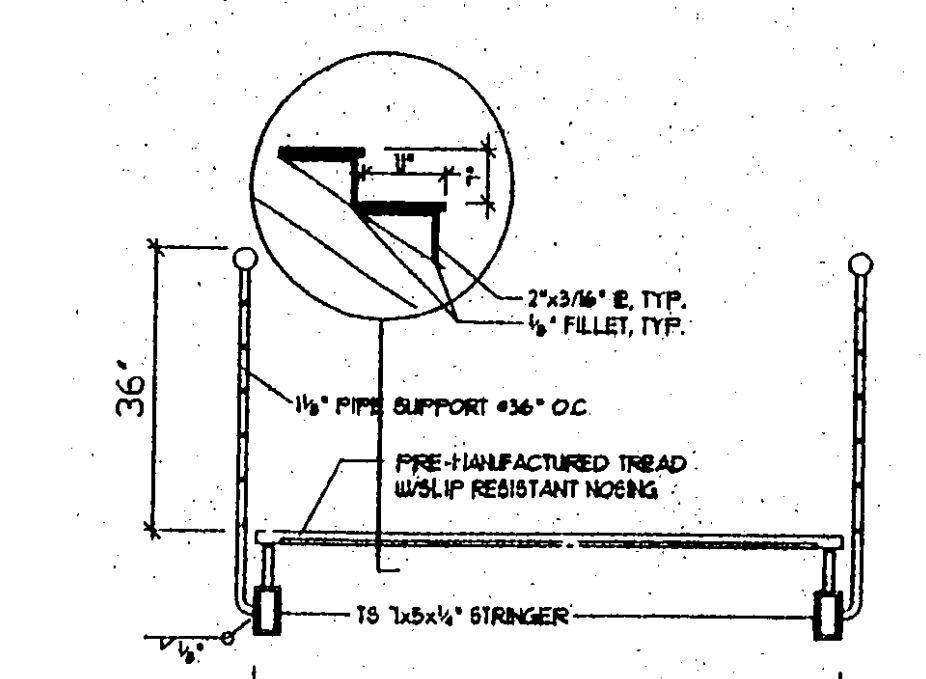


17 Door Jamb

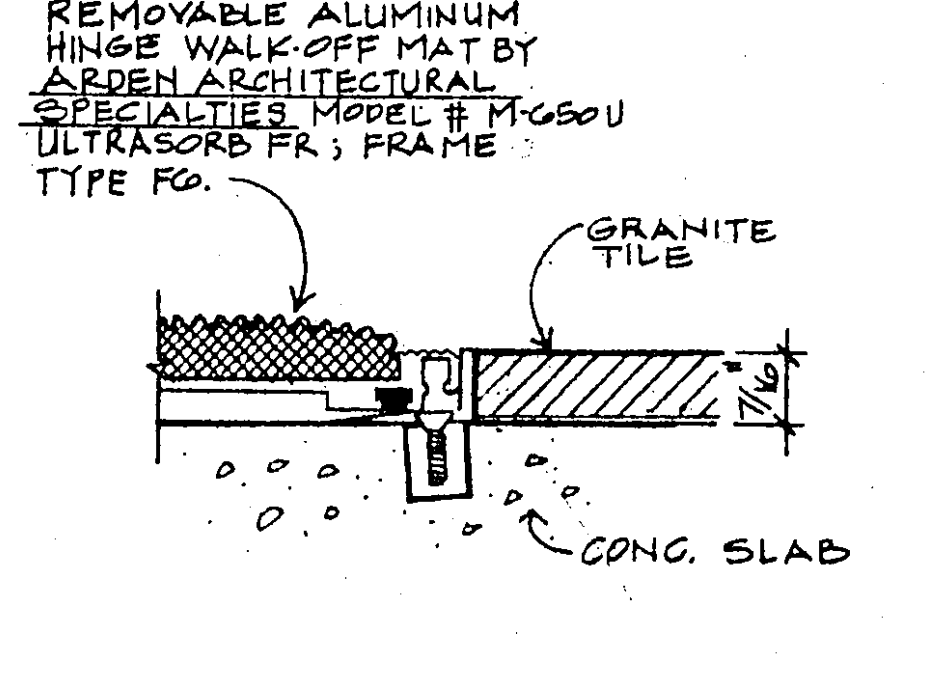


18 Railing

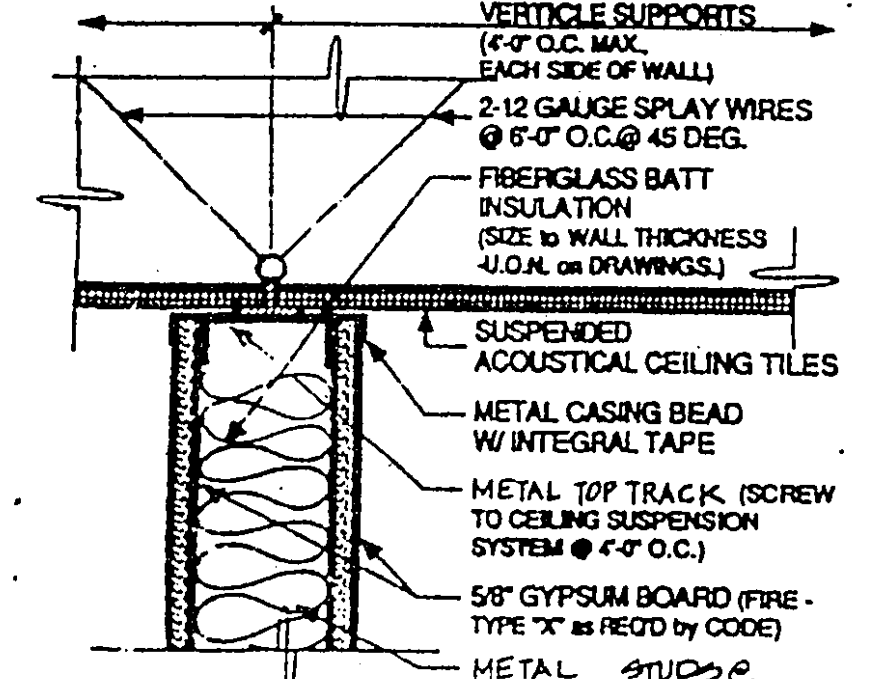


19 Glass Block Low Wall

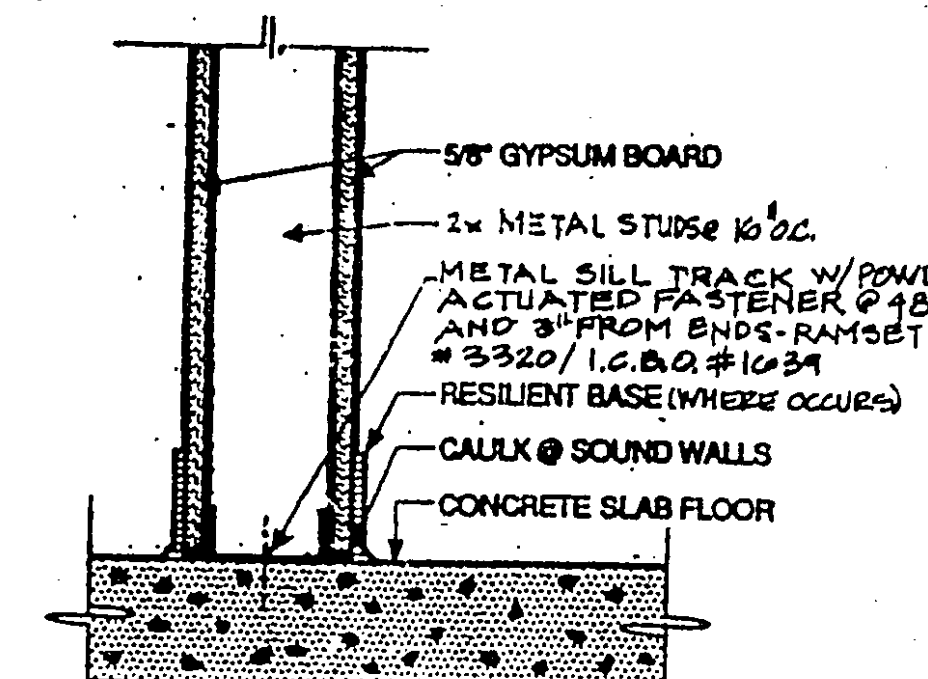


20 Locker Base

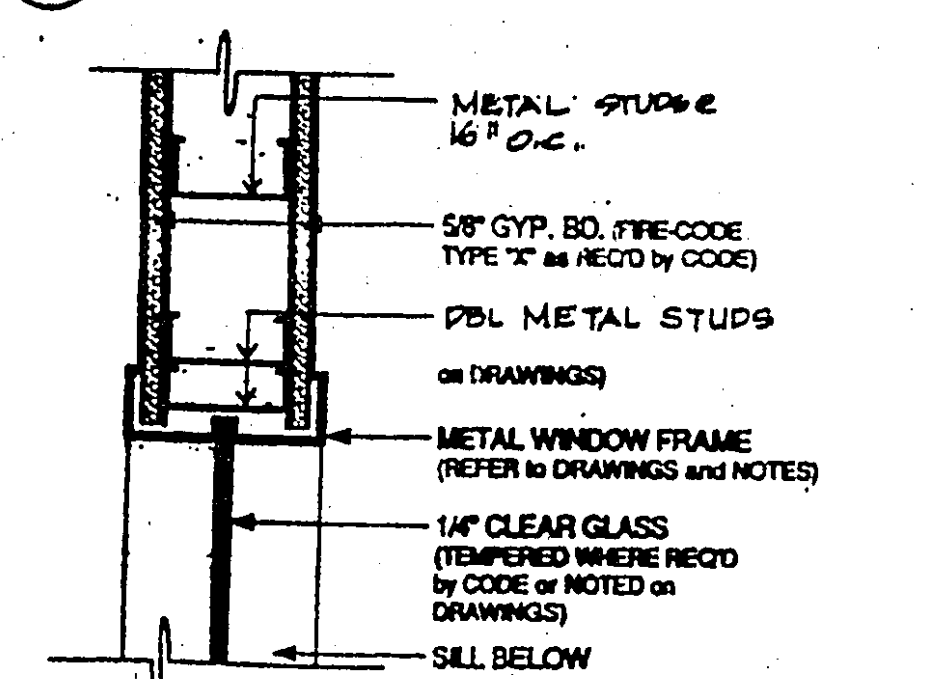


21 Aerobics Floor

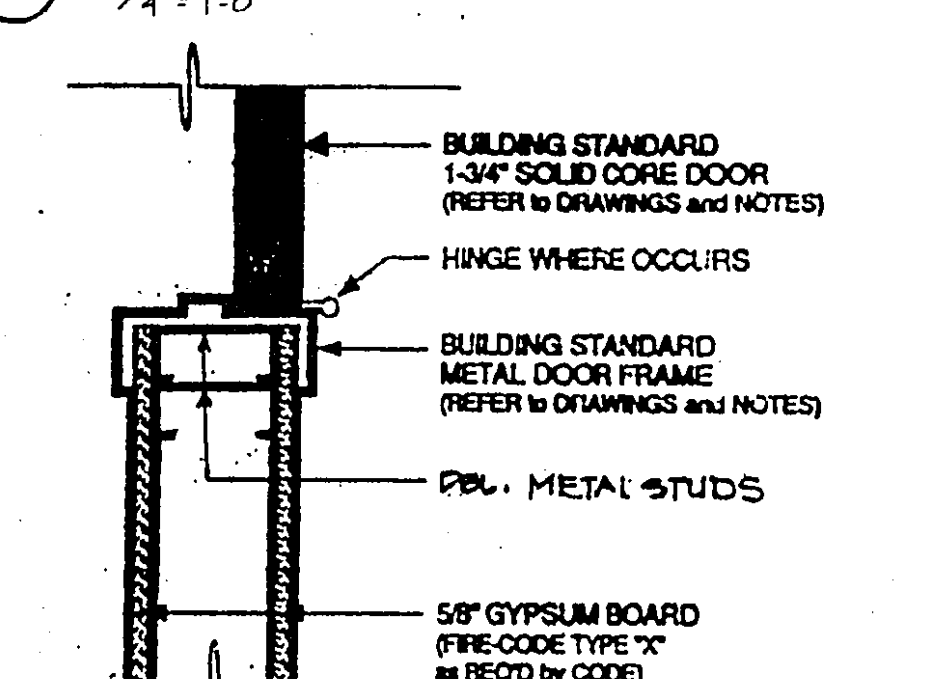


22 Washer/Dryer Overflow Pan

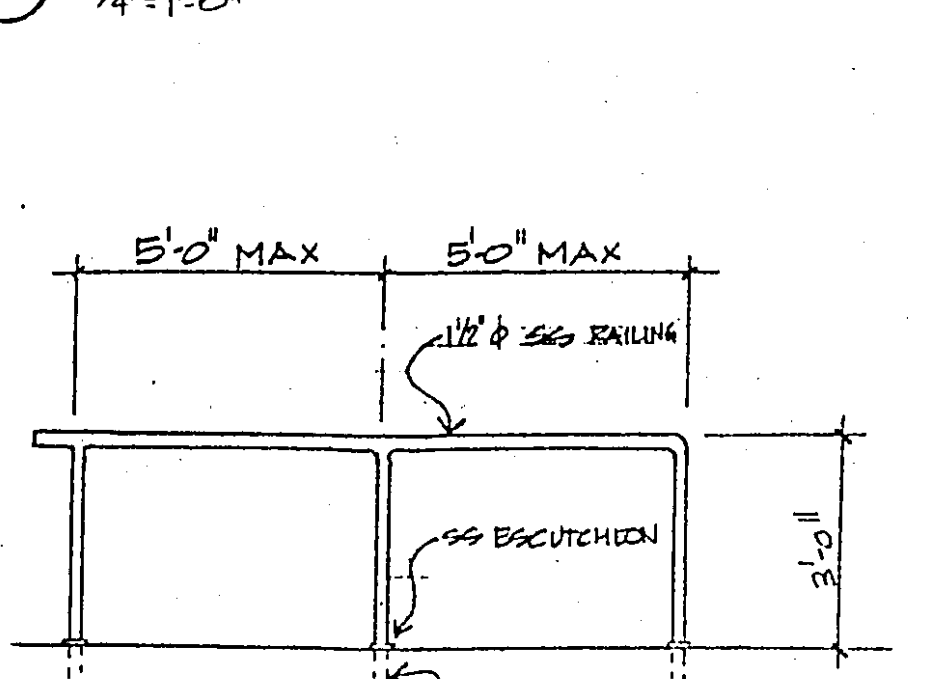


23 T.V. Cabinet at Lockers

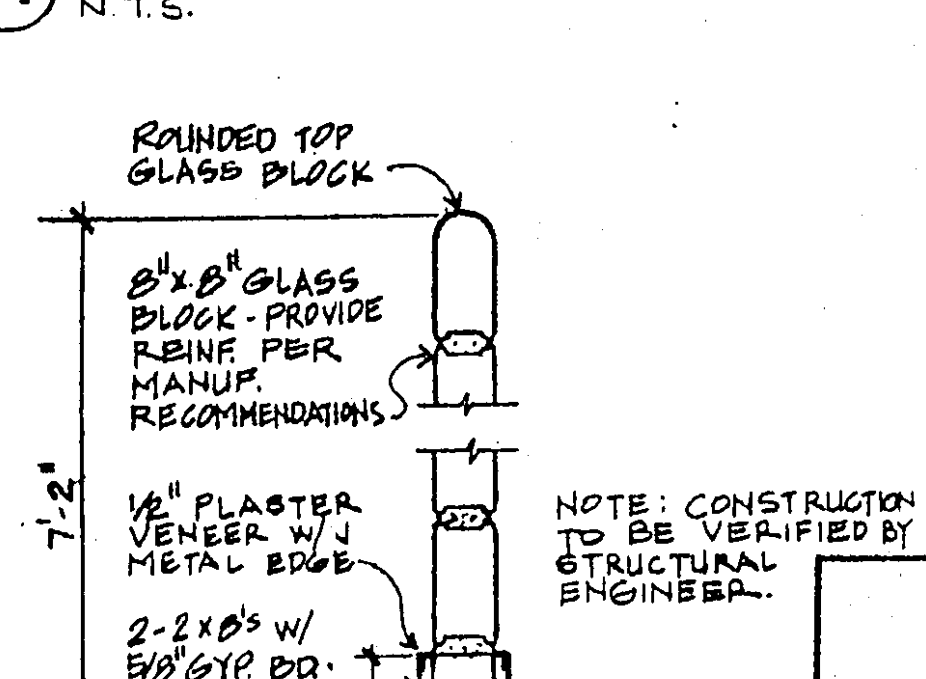


24 Water Heater Anchorage

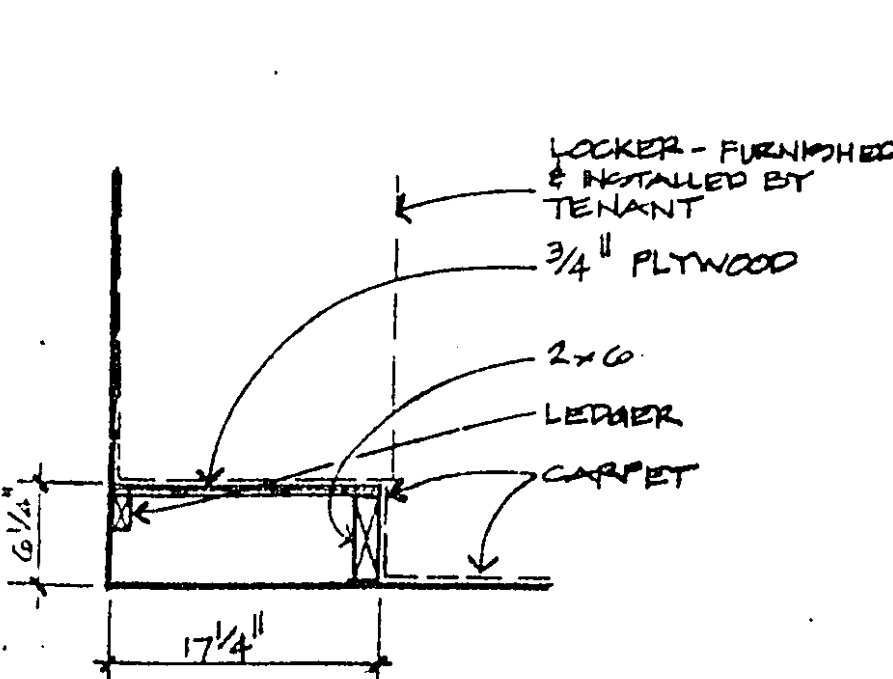


25 Ramp Section

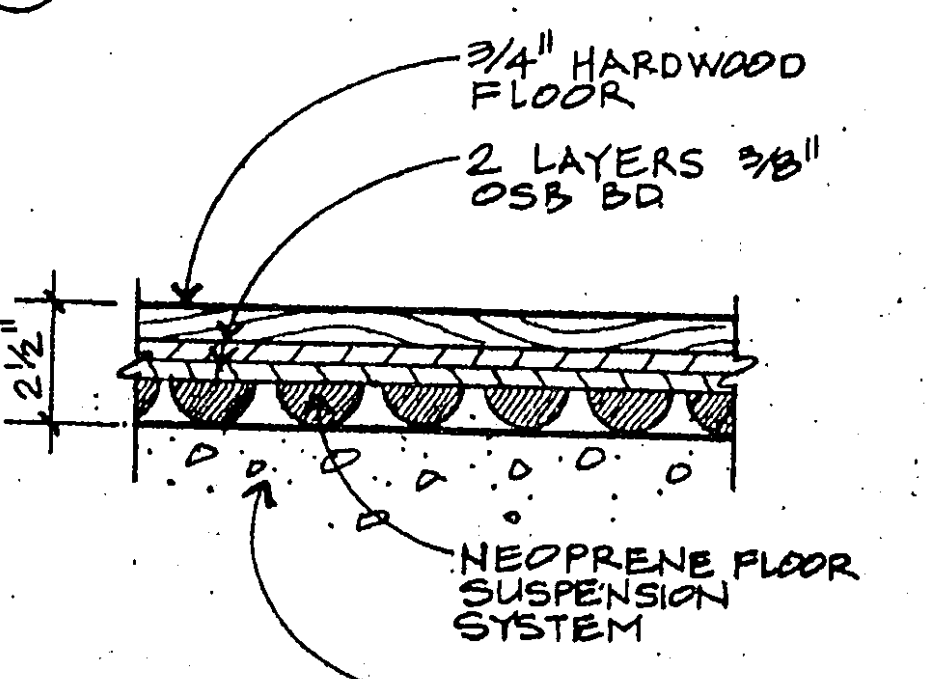


26 Locker Base

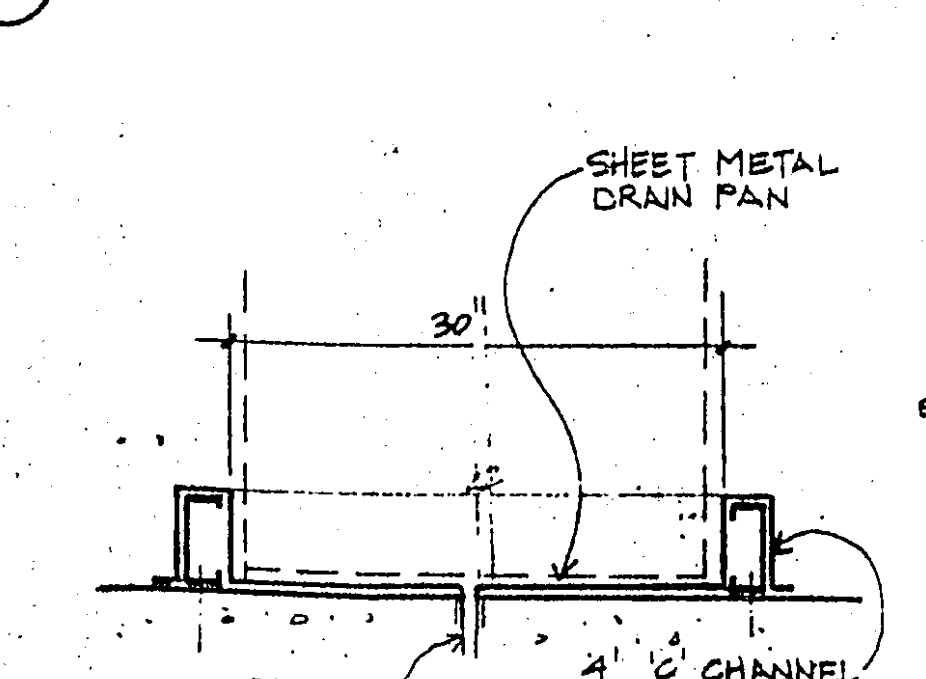


27 Aerobics Floor

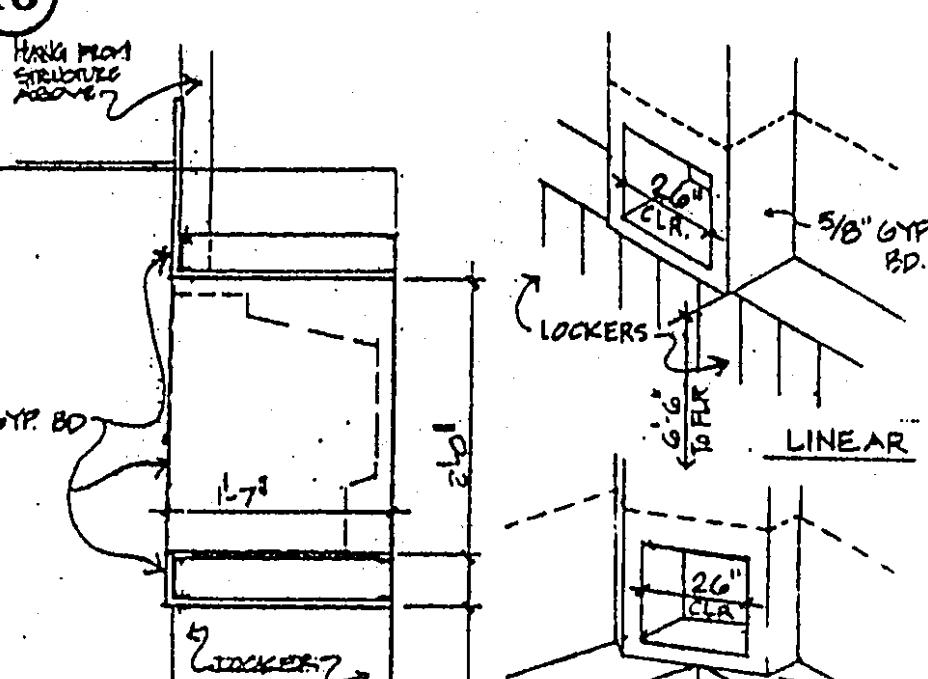


28 Washer/Dryer Overflow Pan

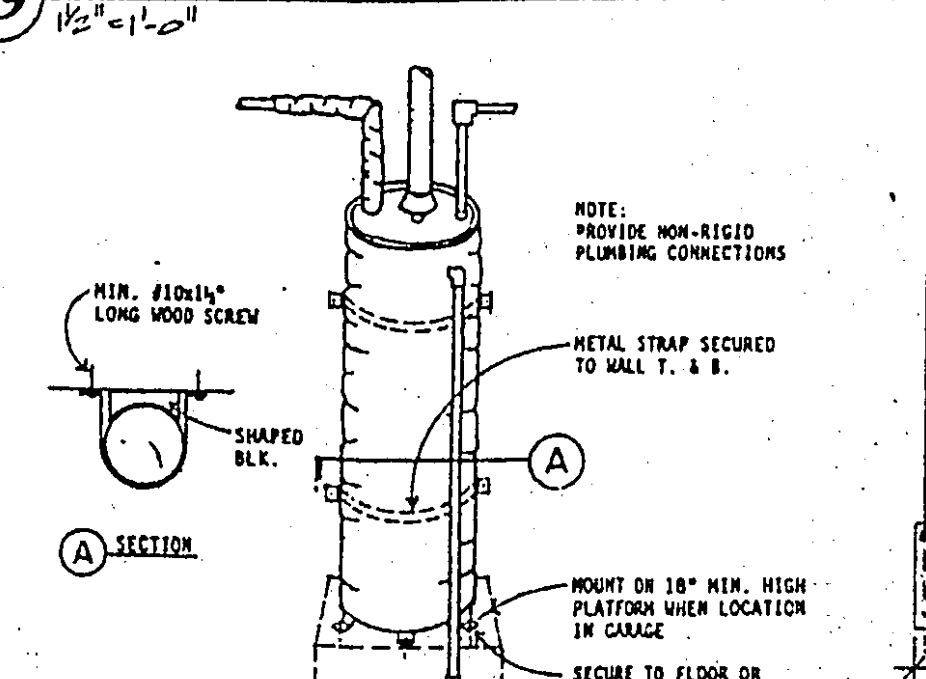

29 T.V. Cabinet at Lockers

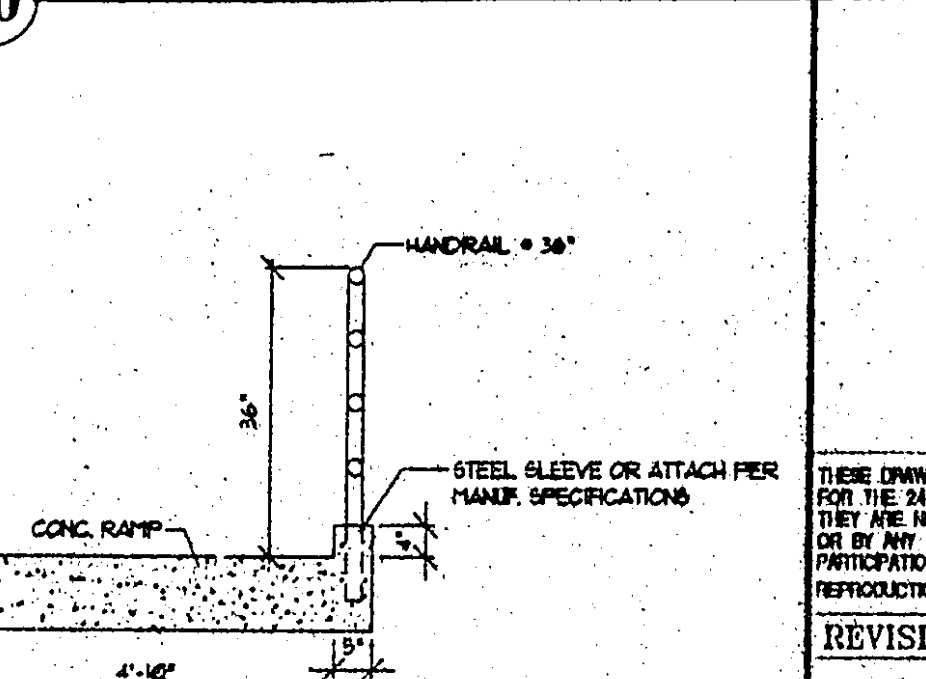

30 Water Heater Anchorage

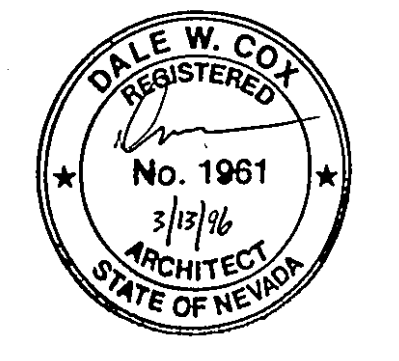

24 HOUR NAUTILUS
RENO 1
SKY MOUNTAIN DRIVE
RENO, NEVADA

COX & KROMYDAS
A.R.C.H.I.T.E.C.T.S.
POST OFFICE BOX 459
TRUCKEE, CA 96160
(916) 587-8757
(916) 881-4422
FAX (916) 587-2138

THESE DRAWINGS HAVE BEEN PREPARED BY COX & KROMYDAS ARCHITECTS FOR THE 24 HOUR NAUTILUS PROJECT. THEY ARE NOT SUITABLE FOR USE ON OTHER PROJECTS IN OTHER LOCATIONS OR BY ANY OTHER INDIVIDUALS WITHOUT THE WRITTEN APPROVAL AND PARTICIPATION OF COX & KROMYDAS ARCHITECTS. REPRODUCTION IS PROHIBITED.

REVISIONS	DATE	DRAWN BY
1.1/1/76	AS	JLS
2.1/1/76	JS	
	SCALE: NOTED	
	JOB NO. 9804	

SPECIFICATIONS

CONCRETE

- 1) Remove concrete as necessary for all plumbing waste lines, electrical conduit, spas, shower, and toilet and patch as required.
- 2) Install #3 rebar reinforcing at 18" on center each direction at trench replacement.
- 3) JOBSITE VISIT MANDATORY TO CHECK FIELD CONDITIONS.

ROUGH CARPENTRY

- 1) ~~Study and plate around and adjacent to spa/jacuzzi, spa equipment room, steam and sauna to be Douglas Fir Fire Retardant lumber, coat bottom 4" with Cuprinol or equal. Ceiling Joists above steam and sauna to be 20 Ga. Galv. Metal Joists.~~
- 2) ~~Frame steam room benches on side of room with high ceiling.~~
- 3) ~~Frame sauna rooms 8'-0" high (flat).~~

DOORS

- 1) Interior doors to be 1-3/4" thick, plastic laminate with clear anodized aluminum frames. Color to be Formica #1816 "Fogdust."
- 2) Provide metal doors and frames at exterior openings as indicated per drawings with thresholds, weatherstripping and door bottoms.
- 3) Provide rated doors as indicated per drawings with label.
- 4) Door at Babysitting to have 24" x 30" tempered glass window with preprimed metal window frames in door.
- 5) Provide double doors to move equipment. (Provide one panic and astrigal with flush bolts at inactive door if only one door is required per code.)
- 6) Door at Manager's Office to be Aluminum and Glass Storefront with clear anodized aluminum frame.
- 7) Door at Aerobics to be a pair of clear tempered glass, frameless doors as manufactured by Blumcraft or equal.

INSULATION

- 1) Sound insulate (3 1/2") walls around Aerobics, Babysitting, Laundry, Mechanical, ~~Spa Equipment Room.~~ Full height from floor to roof structure as applicable.
- 2) ~~R-13 at walls and ceilings of Steam and Sauna Rooms (insulated to ceiling heights).~~
- 3) ~~Interior walls around Spa Room to be insulated full height from floor to roof structure.~~
- 4) Insulate exterior walls and ceilings as necessary per Title 24 requirements.

ROOF PATCHING

- 1) Hot applied repairs for roof penetrations at HVAC units, exhaust fans, ~~skylight, spa/water heater flues, high/low combustion air source and miscellaneous electrical/plumbing penetrations.~~ Include built up roofing material, cant strips, tar, etc. and remove all debris from jobsite.

INTERIOR STOREFRONTS/GLAZING

- 1) ~~Steam and Sauna Room doors to be storefront type with clear anodized aluminum frames, weatherstripping, push/pull bars, closers and thresholds. Doors to swing out and all glazing to be tempered.~~
- 2) Storefronts at Aerobics, ~~spa~~ and other areas as indicated per plans to have clear anodized aluminum frames and 1/4" thick tempered glazing at all interior areas.
- 3) Miscellaneous glazing at Offices to be 1/4" thick tempered and tinted.
- 4) Glass Block to be "Decora" style by PPG or Equal.

MIRRORS

- 1) All mirrors to be 1/4" thick plate glass. "J" mould at top, bottom, and ends of mirror runs; mastic to walls and include all cutouts for electrical plugs, switches, etc. as necessary. Mirrors to be set at heights as follows:
 - Aerobics mirrors to be 12" off the finished floor (add 5' for spring flooring)(100" mirrors where possible).
 - All other workout areas mirrors to be 38" off the floor and mirror to be 48" high unless otherwise noted.
 - Vanity mirrors to be 48" high on top of the countertop backplash.
 - Provide 100" high mirror at Men's and Women's Vanity areas (see plan for locations).

GYPSUM BOARD

- 1) Use 5/8" WR gypsum board at ~~Spa, Steam, Sauna, Laundry, and Toilet walls~~
- 2) Use 5/8" Type "X" gypsum board at all other exposed areas unless otherwise noted.
- 3) Install 1/2" Durock over gypsum board at wainscot areas in ~~Spa and Toilet Rooms.~~
- 4) Tape and texture all exposed surfaces. Texture to match existing surfaces and sand as necessary. Tape and spot nails at ~~Spa and Mechanical Equipment Room.~~
- 5) Remove all debris from jobsite.
- 6) ~~Supply and install Durock around Steam Room door over gypsum board (see interior elevation for extent).~~
- 7) Supply and install 6 mil Visqueen vapor barrier at all locations behind Durock surfaces.
- 8) Supply and install all fire caulking as necessary at rated assemblies.

SUSPENDED CEILINGS

- 1) Install new T-bar ceiling as indicated per plans. Supply and install all materials to repair existing T-bar ceiling. New T-bar ceiling to be 2' x 4' standard white fissured with standard white grid.
- 2) Use 2'x4' USG "Vinylrock" with aluminum covered, galvanized, white grid (or equal) at Locker Rooms.
- 3) Supply 1 box of extra panels for each type of ceiling tile installed.
- 4) Install black T-bar ceiling grid only (4' x 4') at all exercise areas as indicated per plans.

PAINTING

- 1) Gypsum board surfaces:
 - ~~Spa, Toilet Rooms, Laundry and Locker Rooms - one (1) coat of PVA sealer and (1) coat of finish.~~
 - Remaining Gypsum board - one (1) coat of primer and one (1) coat of finish.
 - Exclude painting in Equipment Rooms (Spa, Mechanical).
- 2) Metal doors, knockdown/welded door frames and door window frames (in door) - one (1) coat of primer and one (1) coat of finish. Color to match wall @ door location.
- 3) Wood trim - one (1) coat of primer and one (1) coat of finish.
- 4) NOTE THAT THERE WILL BE APPROXIMATELY 5 DIFFERENT COLORS USED THROUGHOUT THE FACILITY.
- 5) Use mildew resistant paint at all painted walls and ceilings at wet areas (Lockers, ~~Spa, Toilet, Vanity Areas, and Laundry.~~)

RECEPTION DESKS / COLUMN COVERS

- 1) Laminate colors per premium selections
- 2) Supply and install locks on all operational doors / drawers at Reception. All locks to be keyed the same.
- 3) Deleted
- 4) Columns to be 8' brushed sheet metal (sealed) at bottom with rough edge at top of sheet metal. Remaining distance to ceiling to be painted Gypsum Board.
- 5) Provide all cutouts in plastic laminate work for plugs, switches, outlets, w/grey plastic grommets etc.
- 6) All drawers and doors to have pull or sliding pull hardware as necessary to operate doors/drawers. All hardware to have satin chrome finish to match locks.

CERAMIC TILE

- 1) ~~Steam Room - Complete mortar set (walls, ceilings, benches, floor) with accent tiles. Includes all anchoring, full paper, bath waterproofing at floor (chloraloy or equal). Supply and install all caulking of surfaces with (see elevations for patterns) and ceiling - 2" tile at horizontal surfaces with wainscot (floor and benches).~~
- 2) ~~No tile at Steam Room floors. Provide 8" coved tile base.~~
- 3) ~~Spa Room floor - mortar set with accent tiles. Thinsol wall wainscot over 1/2" Durock 8" high with accent pattern (see elevations for patterns). Note tile work as required at shower area in Spa Room.~~
- 4) Tile subcontractor to install sloped mortar bed per code at all openings to provide for transitions between tile areas and carpet/ concrete/ vinyl, etc. areas.
- 5) Showers - (walls, ceiling, benches) thinsol over Durock set, with mortar set at floors. Shower room floors and walls will have an accent pattern (see elevations for pattern). All ceramic tile with grout lines touching door frames to receive colored caulking to control cracking. Ceiling to be run on a 45 degree angle. 4 1/4" glazed tile at Men's and Women's areas.
- 6) Toilets - Thinsol wall wainscot over 1/2" Durock 8" high with accent pattern. Toilet room floors will have an accent pattern and be mud set. All wainscoting with grout lines touching door frames to receive colored caulking to control cracking. 4 1/4" tile at Men's and Women's areas.
- 7) Entry - 12" x 12" granite tiles to be thinsol with granite base at front desk and wall areas.
- 8) Supply and install tile around Steam Room door. See drawings for pattern and extents.
- 9) All grout at ceramic tile to be Hydromet "Delorean Grey" - Sanded at floor areas and Un-sanded at wall areas.
- 10) Grout at Granite to be "Black" - Sanded
- 11) All Ceramic Tile Floor Areas to receive water-proofing (Chloraloy or Equal).

FINISH HARDWARE

- 1) Supply stainless steel kick plates on all doors at one side (To be installed by 24 Hour Nautilus).
- 2) 6" metal angle corners (2" wide) at all outside corners.
- 3) All hardware to be Schlage "Rhoades" lever handles passage type except as noted below or on plans:
 - Plastic hardware to be Von Duprin "rod" and "rim" type as indicated per drawings.
 - Schlage "Rhoades" keyed storeroom locksets at ~~Spa Equipment Room, Equipment room, Electrical room, and Spa-Sleep Storage.~~
 - Schlage "Rhoades" keyed locksets with push or turn button function at Manager's Office, Assistant Manager's Office, Pro Shop, Aerobics Storage, Operations Manager's Office, Employee's Office, Janitor's Room, Accounting Office, and Laundry
 - Aerobics Room doors to have push bar and pull bar.

KEY LOCKS AS FOLLOWS

Master key all locks
Manager's Office, Assistant Manager's Office to be keyed the same.
Pro Shop.
Pro Shop Storage.
Spa Equipment Rooms, Mechanical Rooms, Storage Rooms at Bathrooms are to be keyed the same.

- 4) Overhead door closers - Norton #8501.
- 5) 4" solid door stops. Quality #38.
- 6) Provide occupancy load signs as shown on plans.
- 7) All hardware to have satin chrome finish.
- 8) Supply "double sided tape" for windows in plastic laminate doors.

TOILET ACCESSORIES

- 1) All toilet accessories to be surface/recessed mounted at locations as indicated per drawings.
- 2) Each lavatory to have its own soap dispenser.
- 3) World Dryer's #XA5 - Surface mounted hand dryers.
- 4) Hair dryers to be supplied and installed by 24 Hour Nautilus.

Bobrick or equal for toilet accessories (except for hand dryers).

Description	Model #	Quantity
Sanitary Napkin Dispenser	3500	2
Toilet Cover Dispenser	221	9
Toilet Paper Dispenser	288	9
Sanitary Napkin Disposal	270	6
Soap Dispensers	B-147	2
Soap Dispensers	8221	10
Toilet Compartment Grab Bars (36")	5507	4
Toilet Compartment Grab Bars (48")	5507	4
Paper Towel Disposal at Lavs	B-3844	2
Paper Towel Disposal at Showers	B-36407 #889	2
Towel Hooks	B-6777	18
Hand Dryers	(World) XA5	8
Shower Comp. Grab Bars	B-68137	2
Shower Comp. Bench	B-5181 (Verify Right or Left Hand)	2

STEAM ROOM

- 1) "Mr. Steam" electric steam generator sized per plan and as recommended per manufacturer, with solenoid valves, two (2) chrome heads, timer control, thermostat and factory installed automatic blowdown device. Deliver to jobsite.
- 2) Coordinate installation / connection with plumbing and electrical subcontractors.
- 3) Use "Sonnaborn" RM 5000 waterproofing and 3/4" rigid insulation at all gypsum board surfaces.

SAUNA ROOM

- 1) 1x clear and better kiln dried cedar at walls, ceilings and benches. Benches - closed construction and necessary supports. Include digital control panel, thermostat, locking glass cover for controls (drill hole or provide cover with hole to operate timer control), guardrail (15" above top of unit) and heating unit.
- 2) Electrical connection and conduit by electrician.
- 3) Deliver to jobsite and coordinate connection requirements with electrical subcontractor.
- 4) R-13 insulation at all walls and ceiling.
- 5) 5/8" WR gypsum board at all walls, 5/8" Type "X" gypsum board at ceiling.
- 6) Floor to be sealed concrete.
- 7) Provide cover for heater.

MANUALLY OPERATED SKYLIGHTS

- 1) Skylights shall be manually operated as manufactured by O'Keefe or equal. Provide extension poles as necessary to operate open. Include screen. Skylights are 48" x 96" or as shown on plans. LC-B-60-37110.

MECHANICAL

- 1) Provide flues for ~~Spa and Water heaters.~~
- 2) ~~Provide High / Low combustion air sources at Spa Equipment Room.~~
- 3) Provide and install conduit / flex conduit as necessary for control wiring.
- 4) Provide "Z" bar flashing above new storefront windows and exterior doors.
- 5) Remove ducting / HVAC equipment as necessary to conform to tenant improvement plans and code requirements.
- 6) Remove all debris from jobsite.
- 7) Supply and install exhaust system at Men's and Women's Locker rooms, Shower Rooms, Toilet Rooms, ~~Spa Area, and Laundry.~~ Include time clock controls and all starters as necessary.
- 8) Supply and install duct heater with controls at Babysitting Room.
- 9) Provide Exhaust for Dryer at Laundry. Provide any combustion air required for Dryer.
- 10) Include Manufacturer's metal curbs for all new HVAC units and exhaust fans.
- 11) All thermostats to be set at 6'-8" off floor. Include remote sensor thermostat, programmable control system. Main panel to be located in Manager's Office. Include all low voltage wiring as necessary.
- 12) Supply one set of reproducible sepias and two sets of blue line "as built" drawings.
- 13) ~~Supply and install dedicated exhaust at ceiling over Steam Room Door. Include Time Clock Controls and all Starters as necessary.~~

PLUMBING

- 1) ~~Steam Room - provide hose bibb in room or adjacent to room for cleaning; insulated water piping from equipment to steam room with 2 outlet locations (thru side of outlet boxes); blowdown line from unit to drain.~~
- 2) ~~Provide 4" drain line from backwash in Spa Equipment Room.~~
- 3) ~~Provide gas and water (1 1/2" off main line) stub to Spa and Equipment Rooms. See Spa plans for equipment sizes.~~
- 4) ~~Location of water heaters other equipment in Spa Equipment Room to be coordinated between subcontractors and field determined.~~
- 5) Remove and demo existing plumbing as necessary to conform to tenant improvement plans and code requirements.
- 6) Remove all debris from jobsite.
- 7) ~~Provide Shower head at Spa Room with floor drain~~
- 8) ~~Provide floor drain at middle of Spa Equipment room, 4" drain line and floor drain for backwash basin. Floor to slope 1/4" per foot to drain.~~
- 9) ~~Provide floor drain at Sauna and Steam Rooms with trap primer as required.~~
- 10) ~~Supply and install recessed stainless steel hose bibbs and stainless steel access panels in Spa Room. Locate hose bibbs in such a manner that a 25' hose will reach all areas without stretching over Spa.~~
- 11) Provide electronic eye faucets (electrical provided by others). To be Kohler #K13660.
- 12) Provide and install 2 - 100 gallon water heaters.
- 13) Deleted
- 14) All toilets to be flushometer type (size water line accordingly).
- 15) All lavatory sinks to be Corian #810S "Glacier White" - Undermount.
- 16) Provide hot and cold water, sewer, and gas for washer and dryer at Laundry.
- 17) Supply one set of reproducible sepias and two sets of blue line "as built" drawings.
- 18) Provide Electric Drinking Fountains and cold water and sewer. See plan for locations.
- 19) Provide Recessed stainless steel hose bibb at each shower room.
- 20)


- 21) Provide and install 1 bubbler faucet at each men's and women's vanity areas - kohler #K-7524
- 22) Provide floor drains at all ceramic tile floor areas. See plan for locations.
- 23) ~~Provide water softener system for steam generator.~~

ELECTRICAL

- 1) Provide power for and connect:
 - ~~Steam generator equipment controls (3/4" conduit for low voltage wire by others) and thermostat (install thermostat and controls).~~
 - ~~Provide GFI circuit for water softener at steam generator.~~
 - ~~Sauna room equipment, controls and thermostat, low voltage wiring.~~
 - Drinking fountains
 - Duct heater at Babysitting Room
 - Electronic lavatory faucets (need one (1) outlet per bathroom under sinks which will accommodate up to 6 faucets for Kohler electronic eye faucets). Locate outlet at +20" A.F.F.
 - 2 - 20 amp dedicated GFI circuits (4 duplex plugs - 1 switched)
 - Water Softener for Steam Generator
 - Emergency lighting, exit lights, self illuminated lighting.
 - GFI plug for hair dryer outlets at each side of Men's and Women's vanities, and at each side of Women's dry vanity.
 - 20 amp dedicated GFI circuits for hand dryers (World hand dryers)
 - Outlets at TV locations (110v) (Exercise areas and Locker rooms).
 - Panel for ~~Spa items.~~
 - Special equipment requirements for equipment (220 v locations).
 - Provide time clocks at all exterior signage locations.
 - Provide Neon switch/outlet/circuit locations.
 - Include 2 - 120v 20 amp dedicated circuits at vending area
 - Install time clocks and starters for exhaust fans
 - Provide dedicated circuit for water heater ignitors.
 - Electrical plugs in Aerobics room shall be 7" off the finished floor to center of plug (add 5" if using spring floor).
 - Provide (4) ceiling outlets for fans at Aerobics Room. One at each corner of the room.
 - Provide option prices for switches, plugs, dedicated circuits, etc. in contracts.
 - See Reception cabinet plans for exact electrical outlet/telephone/data locations (Should include two quad outlets, two duplex outlets and two empty conduits/boxes for data and telephone).
 - Provide one 20 amp 110v circuit at stereo cabinet locations at Aerobics and Manager's Office. Provide one empty 1-1/2" conduit at same locations stubbed above ceiling
- 2) Remove and demo existing electrical including lighting fixtures as necessary to conform to tenant improvement plans and code requirements.
- 3) Remove all debris from jobsite.
- 4) ~~Spa electrical subcontractor to supply and install breakers in panel for Spa equipment.~~
- 5) ~~Check location and type of fixture at Steam and Sauna Rooms. (Do not install fixtures directly over benches).~~
- 6) All electrical panels accessible to the public to have locks installed by electrical subcontractor.
- 7) Supply and install box/conduit run for telephone and data box locations. Conduit to be stubbed up above ceiling line at each location. Telephone system and data/cable wiring by others.
- 8) Supply and install all support wires (except safety wires for light fixtures) and attach safety wires for all light fixtures. Safety wires for light fixtures will be attached to framing by others.
- 9) Supply one set of reproducible sepias and two sets of blue line "as built" drawings.
- 10) Legibly label all panels with exact circuit locations (ie: Men's Locker Room Lights, Cardio Circuits, etc.) Also label all exit light and emergency light circuits and provide lock on device.
- 11) Exact locations of Neon circuit stubs to be field determined.
- 12) Provide power for all AC equipment, smoke detectors, and controls furnished and installed by others.

SPA

- 1) Subcontractor supplying and installing Spa equipment will be responsible for starting up, setting up, anchoring, setup timers/program, install filter with all valving, supply and install sand and peagravel at all filters, install insiders for jets. Supply and install all signage, tile safety markings, white plaster, stainless steel rails, comply controller and relays as necessary, 1" auto fill line for Spa, and (1) 1" manual fill line for Spa. All items as necessary for a complete job. Plumbing subcontractor to supply one (1) skimmer with a built in thermometer that can be read from the top (1" at Spa). Plumbing subcontractor to supply and install secondary containment of chlorine.

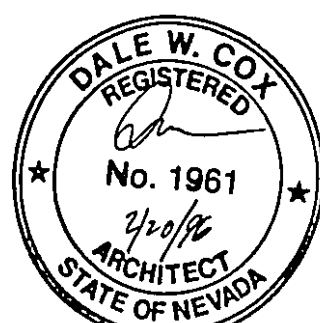

24 HOUR NAUTILUS
RENO 1
SKY MOUNTAIN DRIVE
RENO, NEVADA

COX & KROMYDAS
A.R.C.H.I.T.E.C.T.S



POST OFFICE BOX 450
TRUCKEE, CA 96100

(916) 587-6757
(916) 581-4422
FAX (916) 587-2130

THESE DRAWINGS HAVE BEEN PREPARED BY COX & KROMYDAS ARCHITECTS FOR THE 24 HOUR NAUTILUS PROJECT. THEY ARE NOT SUITABLE FOR USE ON OTHER PROJECTS, IN OTHER LOCATIONS, OR BY ANY OTHER MEANS WITHOUT THE WRITTEN APPROVAL AND PARTICIPATION OF COX & KROMYDAS ARCHITECTS. REPRODUCTION IS PROHIBITED. (C)

REVISIONS	DRAWN BY	JLS
DATE	SCALE	NOTED
JOB NO.	9604	

A27

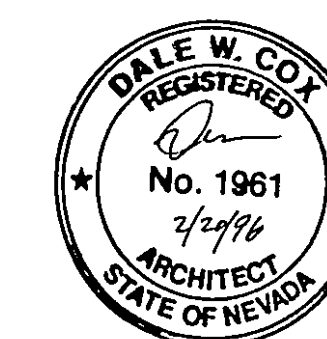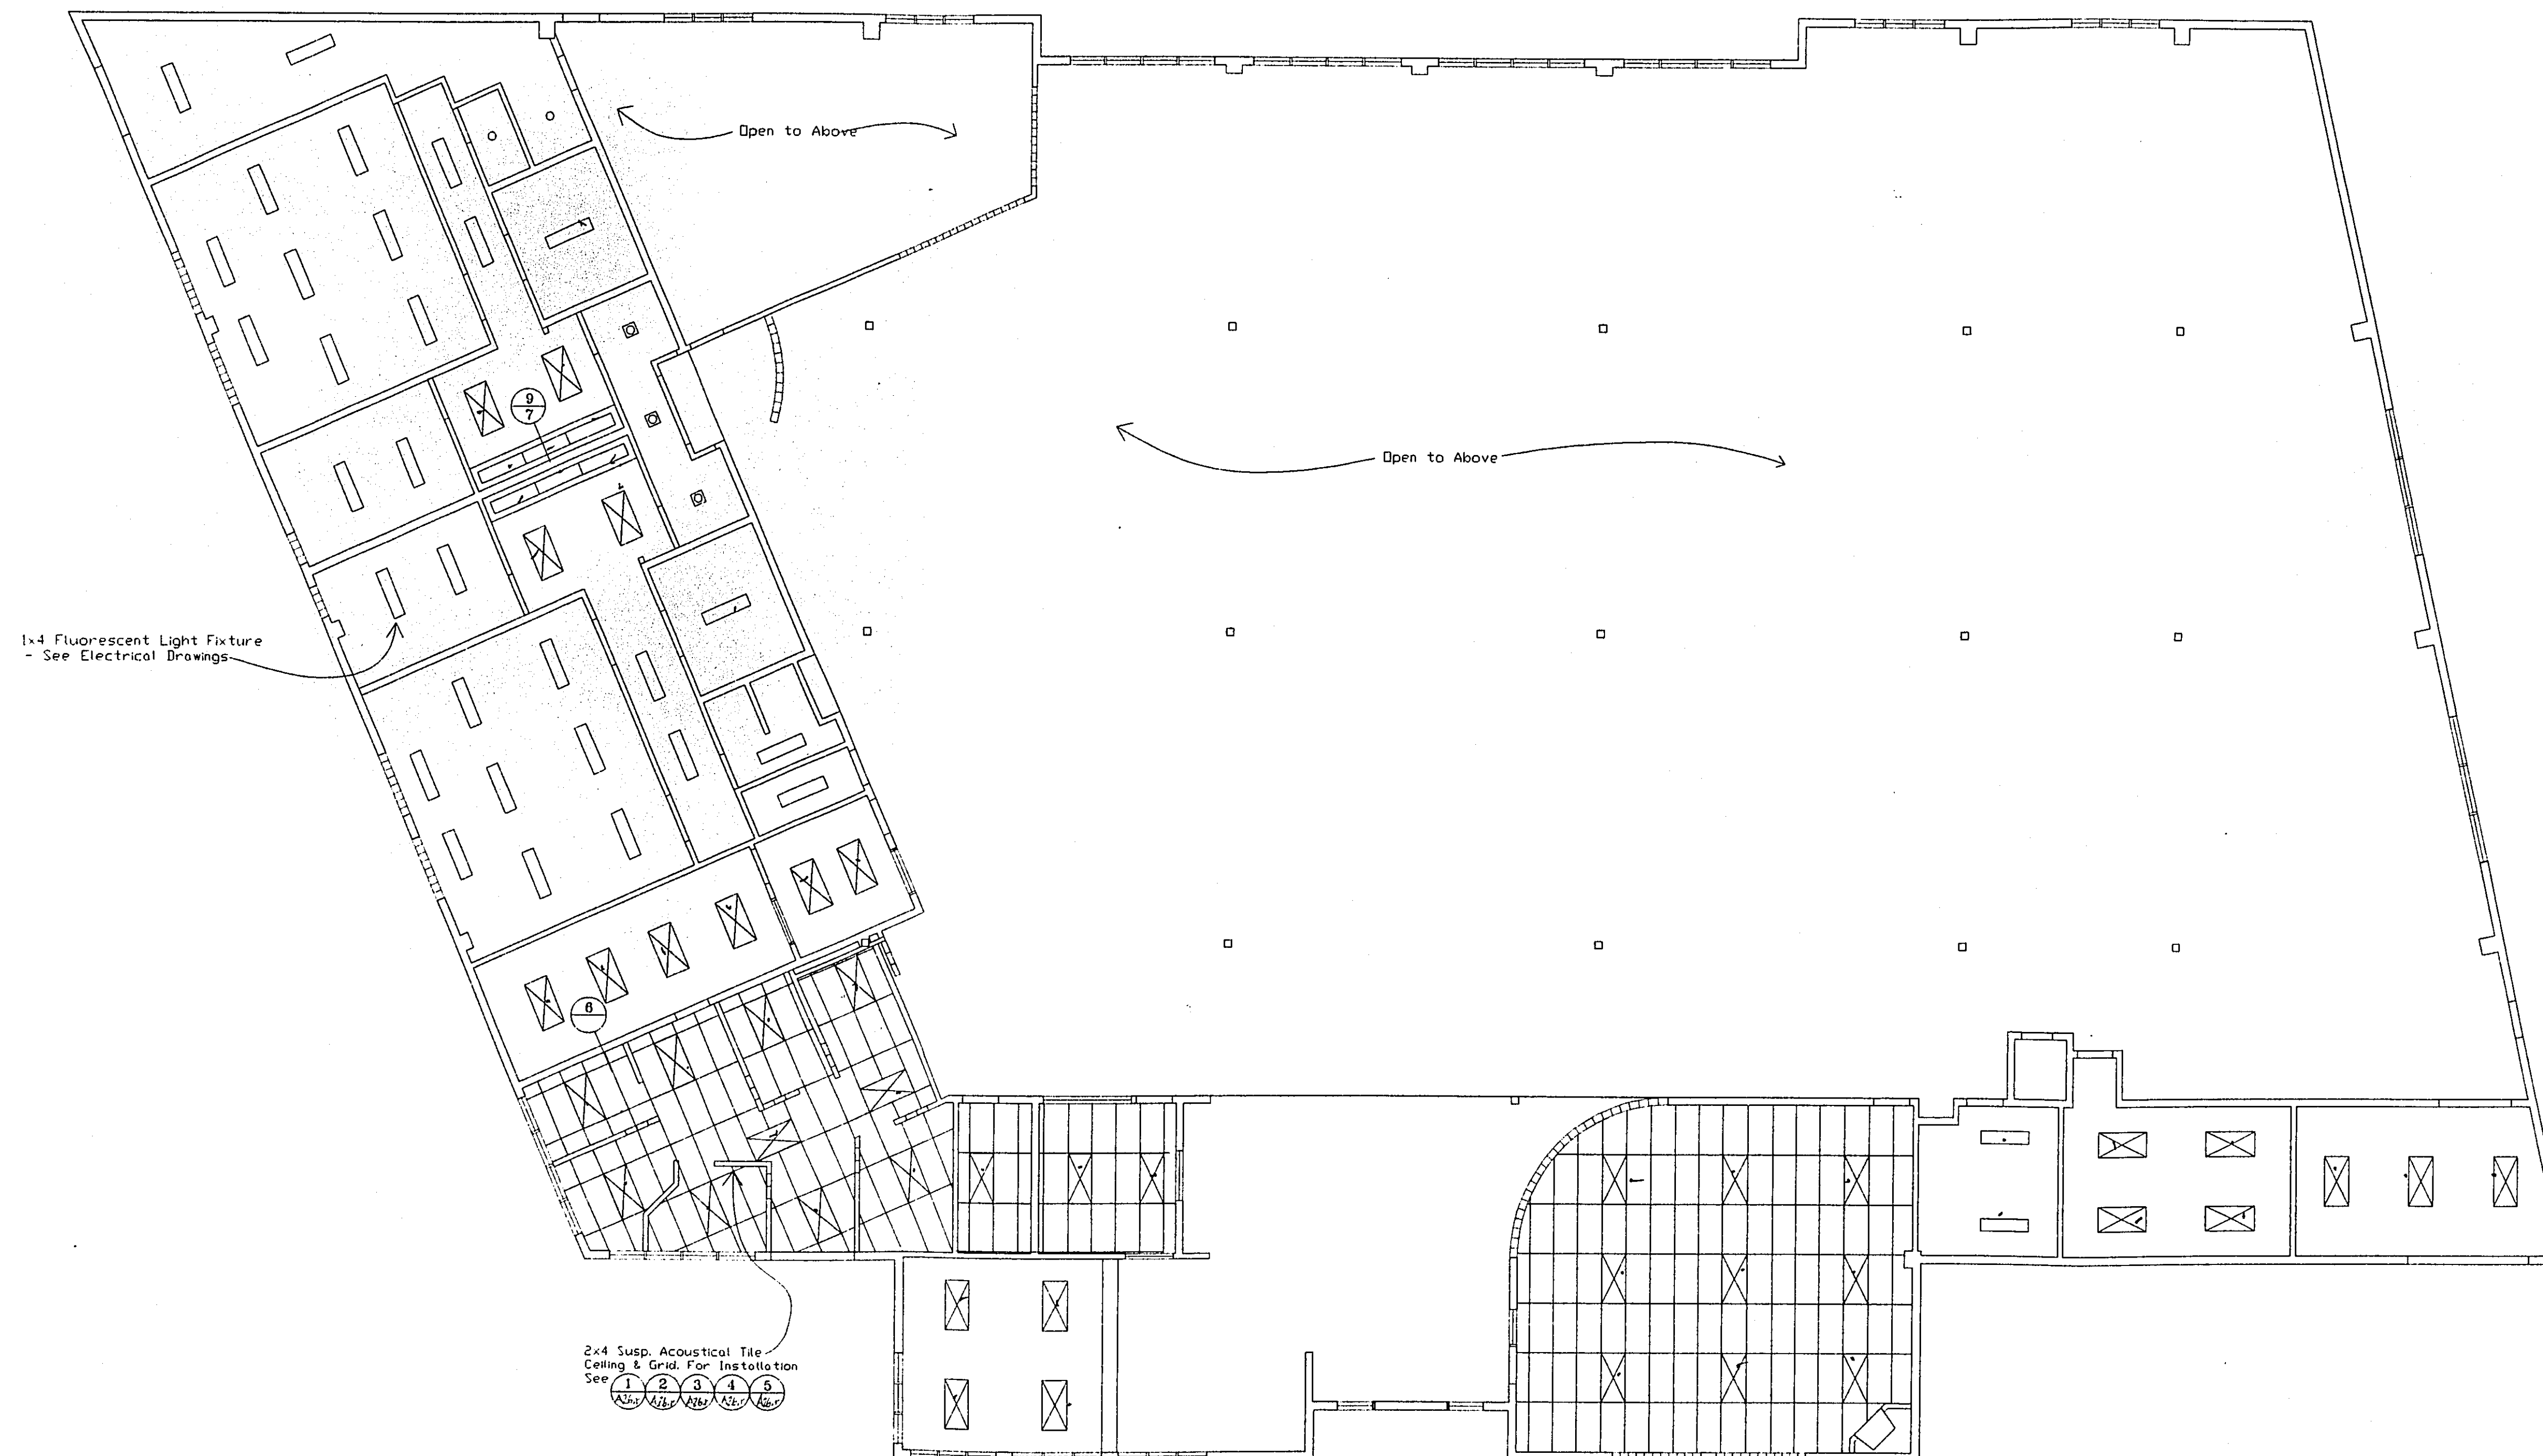

24 HOUR NAUTILUS
RENO 1
SKY MOUNTAIN DRIVE
RENO, NEVADA

COX & KROMYDAS
A.R.C.H.I.T.E.C.T.S

POST OFFICE BOX 459
TRUCKEE, CA 96160

(916) 587-0757
(916) 581-4422
FAX(916)587-2136


THESE DRAWINGS HAVE BEEN PREPARED BY COX & KROMYDAS ARCHITECTS FOR THE 24 HOUR NAUTILUS PROJECT. THEY ARE NOT SUITABLE FOR USE ON OTHER PROJECTS, IN OTHER LOCATIONS, OR BY ANY OTHER INDIVIDUALS WITHOUT THE WRITTEN APPROVAL AND PARTICIPATION OF COX & KROMYDAS ARCHITECTS. REPRODUCTION IS PROHIBITED.


REVISIONS	DRAWN BY	JLS
DATE	02.20.96	
SCALE:	1/8" = 1'-0"	
JOB NO.	9604	

E4.r

First Floor Reflected Ceiling Plan



1/8" = 1'-0"

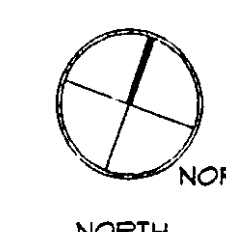

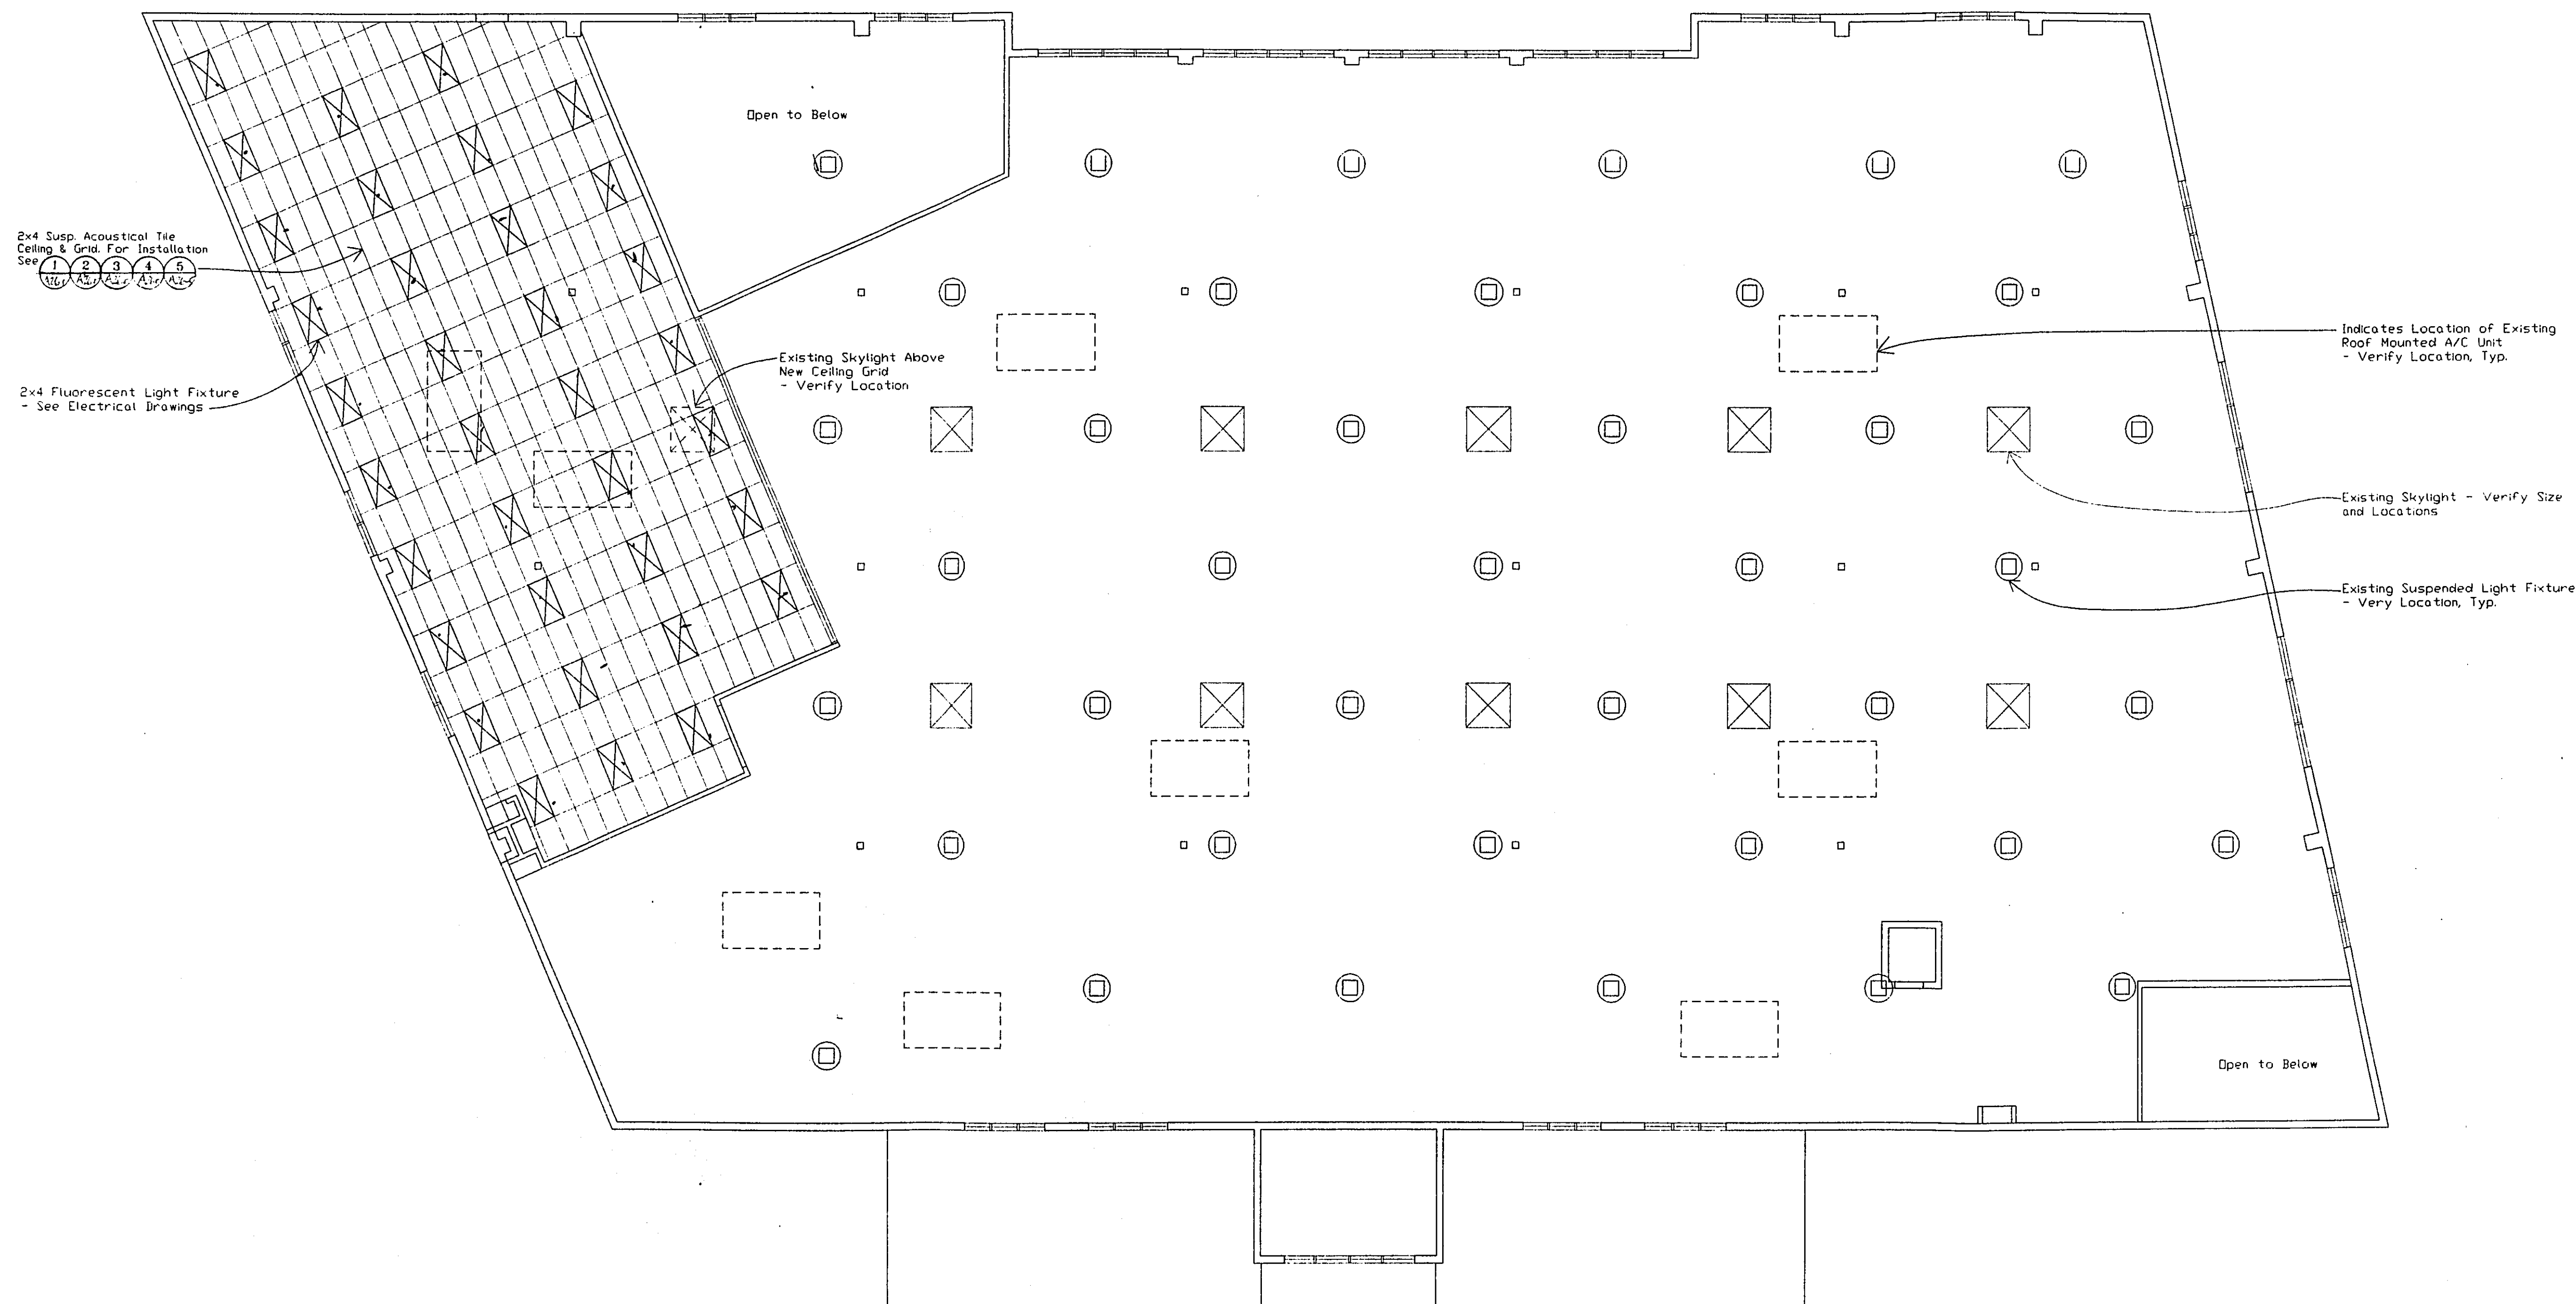

Mezzanine Level Reflected Ceiling Plan

1/8" = 1'-0"

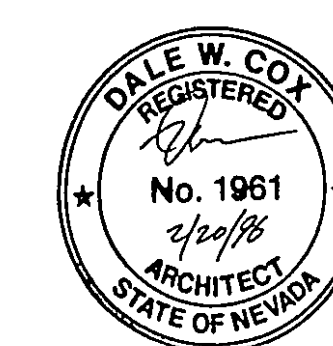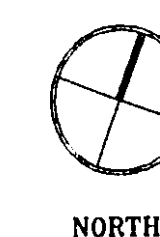

24 HOUR NAUTILUS
RENO 1
SKY MOUNTAIN DRIVE
RENO, NEVADA

COX & KROMYDAS
A.R.C.H.I.T.E.C.T.S

POST OFFICE BOX 459
TRUCKEE, CA 96160

(916) 587-8757
(916) 581-4422
FAX(916)587-2136

THESE DRAWINGS HAVE BEEN PREPARED BY COX & KROMYDAS ARCHITECTS FOR THE 24 HOUR NAUTILUS PROJECT. THEY ARE NOT SUITABLE FOR USE ON OTHER PROJECTS, IN OTHER LOCATIONS, OR BY ANY OTHER INDIVIDUALS WITHOUT THE WRITTEN APPROVAL AND PARTICIPATION OF COX & KROMYDAS ARCHITECTS. REPRODUCTION IS PROHIBITED. ©

REVISIONS	DRAWN BY	JLS
DATE	02.20.96	
SCALE:	1/8"=1'-0"	
JOB NO.	9604	

E5.r

030105
 Revisions
 23952

RECEIVED
 CITY OF
 BUILDING
 96 MAR 20 P3:12

See floor plan for
 arch. correct out

Ref. new fixtures only

FOR ADDITIONAL PLUMBING INFORMATION
 IN THIS AREA - SEE SHEETS P3.1 & P3.3

4" (1 1/4" MG) DOWN ON WALL
 AND THRU WALL TO GAS
 METER. METER BY SPPCO.
 2950 CFH REQUIRED

4" (1 1/4" MG)
 UP. SEE SHEET
 P2.2

CONNECT TO SITE
 SELLER MAIN PIPING
 AT INVERT 801' ±

2" W. FROM
 2ND FLOOR
 1 1/2" V UP TO
 3" VTR

COM. WASHER & DRYER

DF-1

1/2" CH

3/4" CH

2" W. TO BREAKROOM SINK
 ALSO DF.

3" W. EXCEEDS 8'-6"
 SUDS RELIEF 7111.0

2" W. TO BREAKROOM SINK
 ALSO DF.

3/4" CH DOWN IN WALL
 TO HB-2 (TYP. 2)


3" DOWNSPOUTS DOWN ON WALL/COLUMN
 TO SIDEWALK. ROUTE PIPING BELOW SIDEWALK
 AND DAYLIGHT THRU CURB TO PARKING AREA
 (TYPICAL)

A FIRST FLOOR PLUMBING PLAN
 P2.1 1/8"=1'-0"

(FINISH FLOOR ELEVATION 805.0' ±)

J.W. McCLENAHAN CO.
 RECORD DRAWINGS
 DATE 3-20-1996

J. W. McCLENAHAN CO.
 PLUMBING • HEATING • AIR CONDITIONING • INDUSTRIAL PIPE CONTRACTORS
 CALIFORNIA: 2301 PALM AVENUE - SAN MATEO, CALIFORNIA 94403 - (415) 345-1691
 8540 YOUNGER CREEK DR., STE. 1 - SACRAMENTO, CA 95828 - (916) 387-0303
 NEVADA: 1610 MARIETTA WAY - SPARKS, NEVADA 89431 - (702) 331-6700

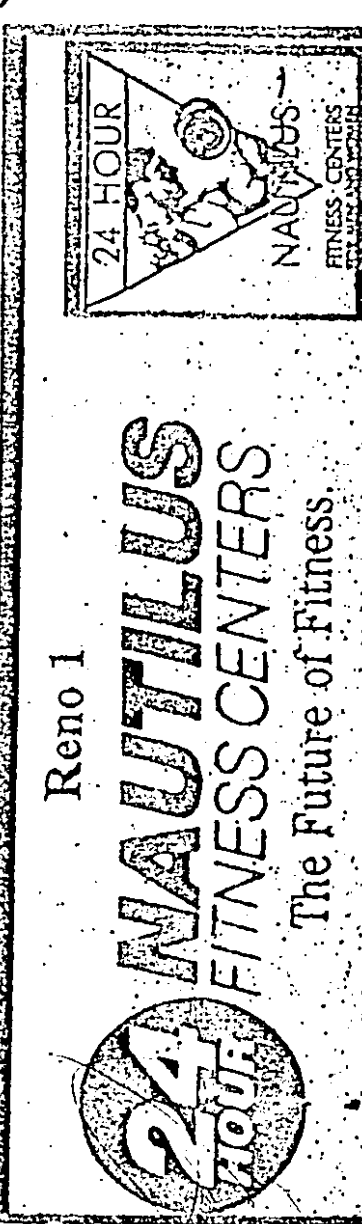


J.W. McCLENAHAN CO.
 2301 PALM AVENUE
 P.O. BOX 1140
 SAN MATEO, CA 94403
 TEL: (415) 345-1691
 FAX: (415) 345-5881
 8540 YOUNGER CREEK DRIVE
 SUITE 1
 SACRAMENTO, CA 95828
 TEL: (916) 387-0303
 FAX: (916) 387-0301
 1610 MARIETTA WAY
 SPARKS, NV 89431
 TEL: (702) 331-6700
 FAX: (702) 331-6700

REVISION: 4/28/94
 3/20/96

JOB NO.:
 DESIGN:
 DRAWN:
 CHECK:
 DATE: 24 MARCH, 1994

SHEET NO.:
 P2.1

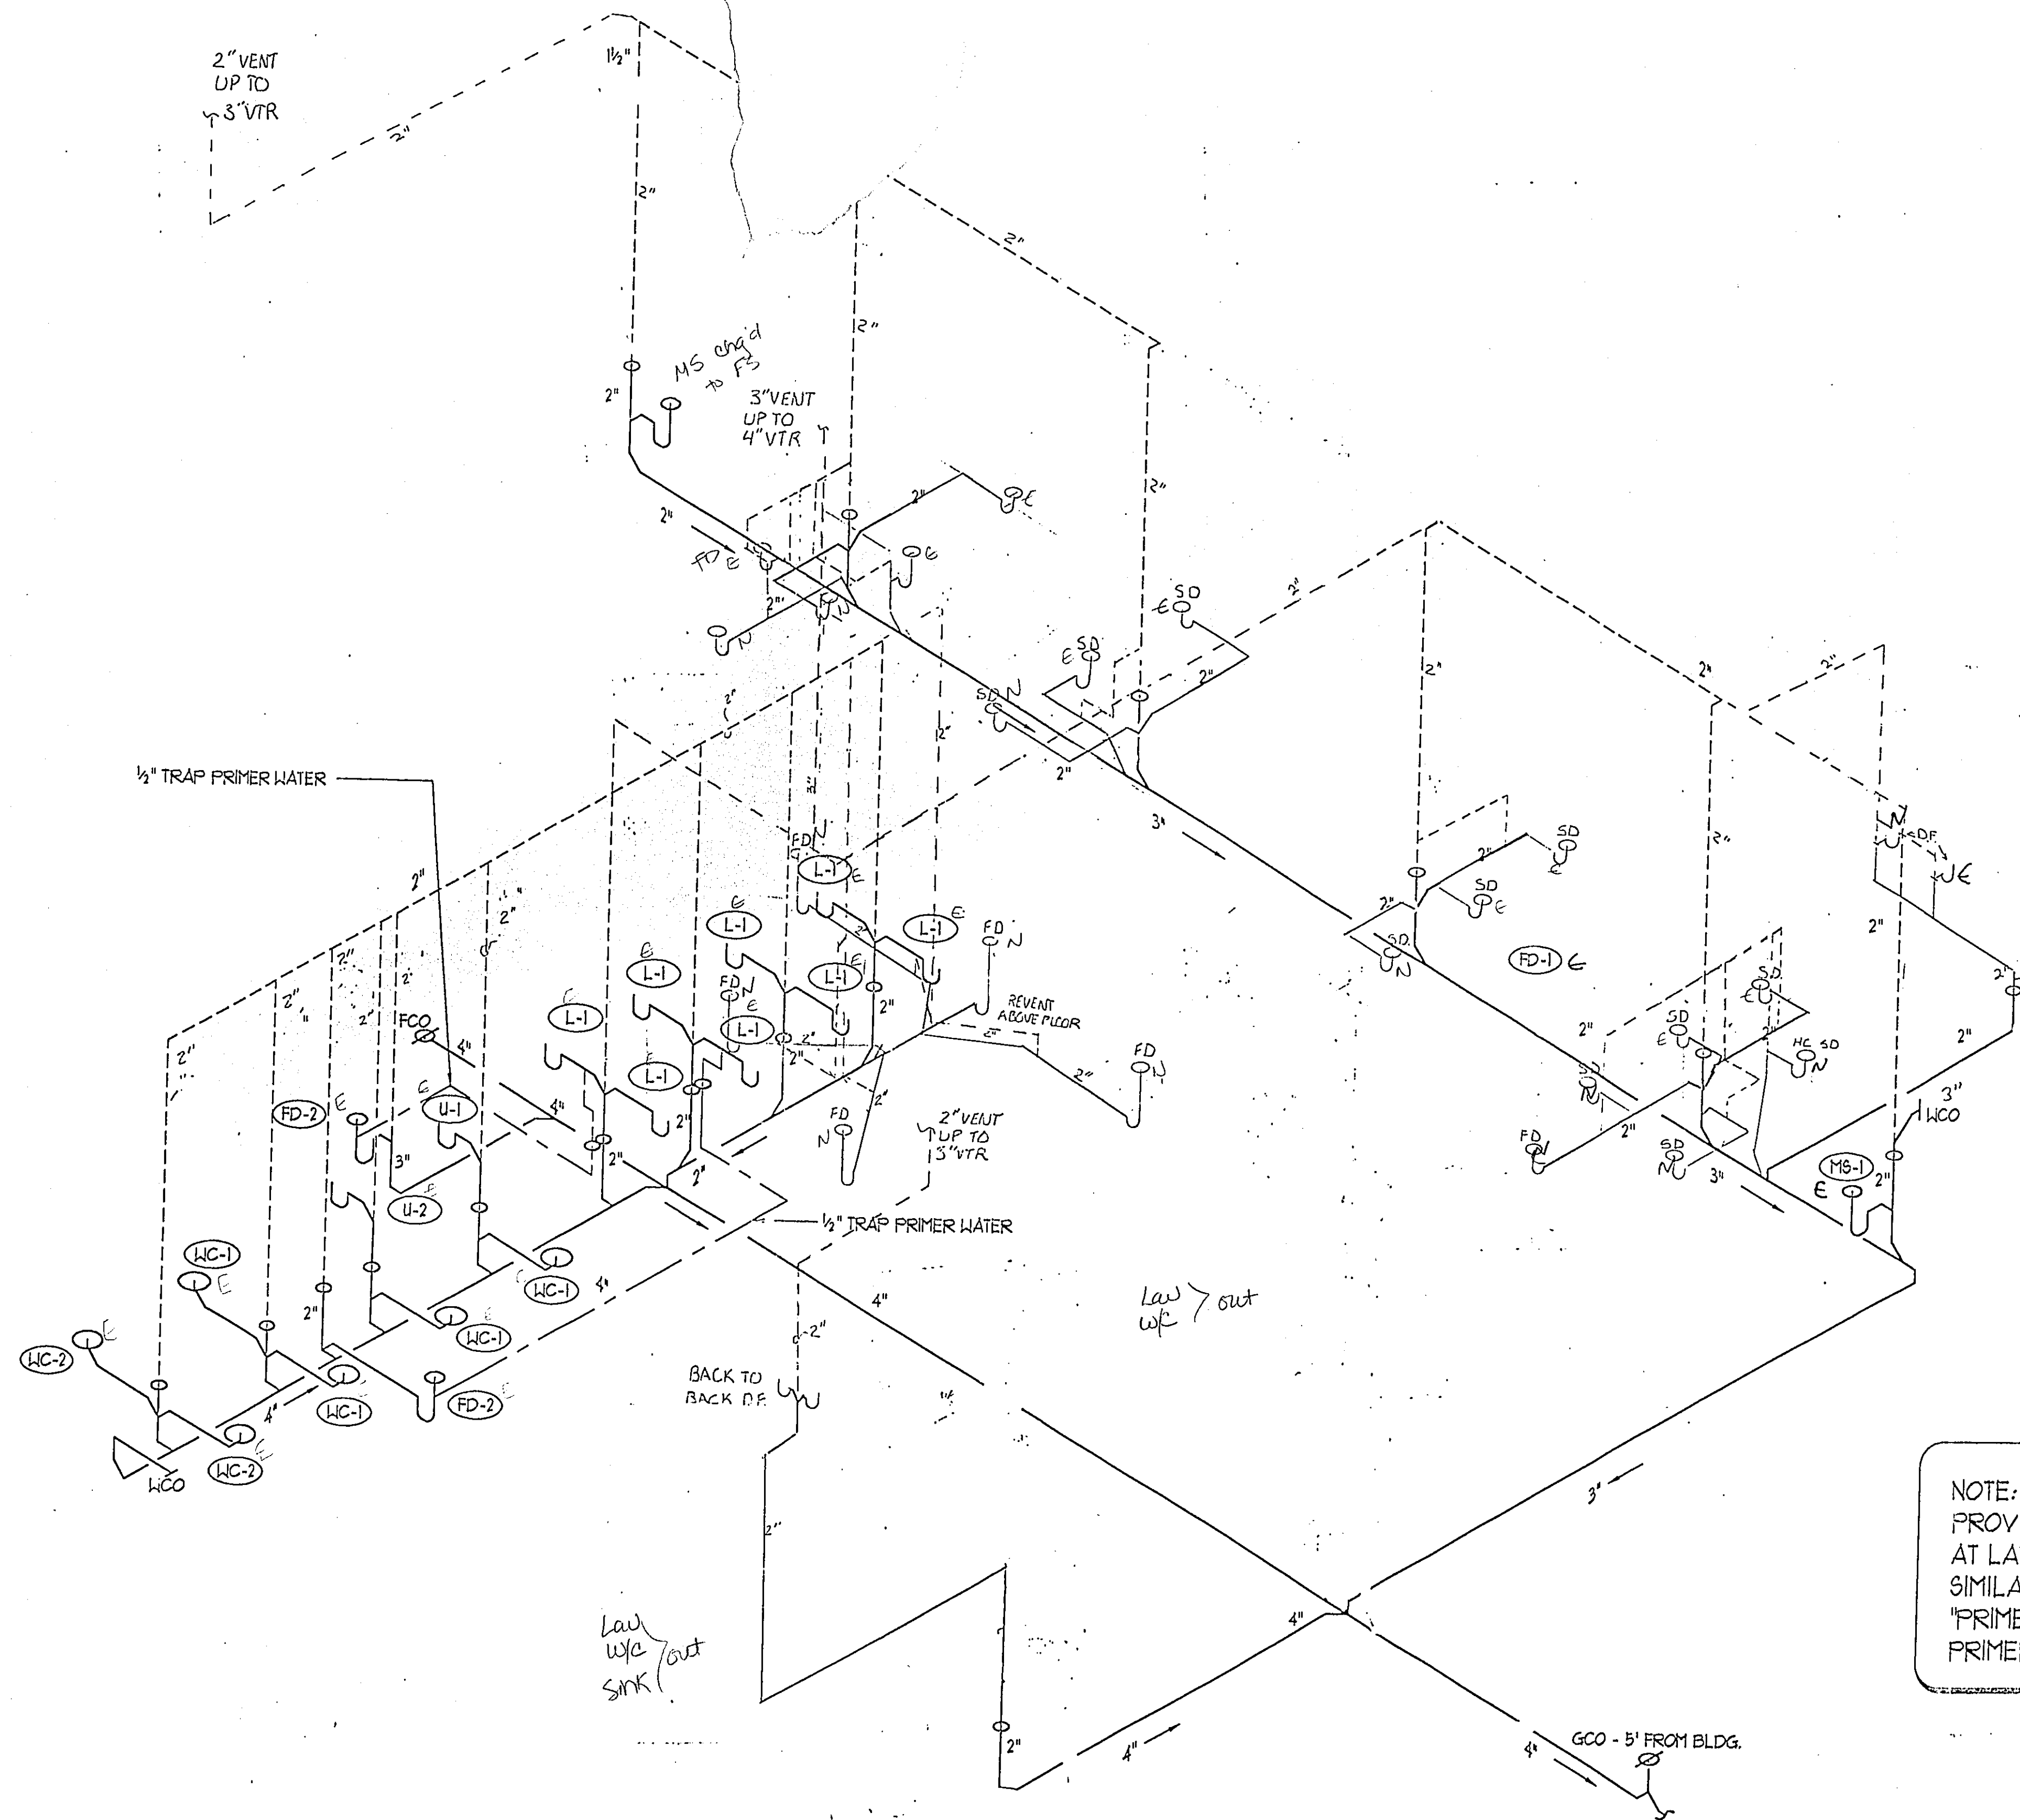

NOTE:
 PROVIDE TRAP ARM PRIMER
 AT LAVATORIES AS SHOWN
 SIMILAR TO J.R. SMITH
 "PRIME-EZE WATER SAVER
 PRIMER" FIGURE NO. 2698

1 WASTE & VENT RISER DIAGRAM
 P3.3 NOT TO SCALE

J.W. McCLENAHAN CO.
 RECORD DRAWINGS
 DATE 3-20-1996

J.W. McCLENAHAN CO.
 2301 PALM AVENUE, SUITE 1, SAN MATEO, CA 94403
 8540 YOUNGER CREEK DRIVE, STE. 1, SACRAMENTO, CA 95828
 1610 MARIETTA WAY, SPARKS, NEVADA 89431

REVISION: 3/20/96

JOB NO.:
 DESIGN:
 DRAWN:
 CHECK:
 DATE: 24 MARCH, 1994

SHEET NO.:
P3.3

24 HOUR
NAUTILUS
 FOUR FITNESS CENTERS
 The Future of Fitness

J.W. McCLENAHAN CO.
 PLUMBING • HEATING • AIR CONDITIONING • INDUSTRIAL PIPE CONTRACTORS
 CALIFORNIA: 2301 PALM AVENUE - SAN MATEO, CALIFORNIA 94403 - (415) 345-1691
 NEVADA: 8540 YOUNGER CREEK DRIVE, STE. 1 - SACRAMENTO, CA 95828 - (916) 387-0303
 1610 MARIETTA WAY - SPARKS, NEVADA 89431 - (702) 331-6700

RPD have 16 Applications with different indexes. I have grouped the ones that have the same indexes.



PD1 Records, PD12 RPD Workcards, PD15 Crossroads Traffic Accident

Internet Explorer browser window showing the application URL: <http://moers08web/appxtender/Main.aspx?DataSource=DOCUMENTUM>. The browser tabs show "ApplicationXtender Web Access".

Application menu: File, Edit, View, Favorites, Tools, Help.

Toolbar: Convert, Select, Google Sites, Suggested Sites, Free Hotmail, 'Spotlight' wins Best...

Application menu: File, Edit, View, Help.

Query Criteria for Application 'PD_1' Current Query: New Query

Show	Index Name	Search Value
<input checked="" type="checkbox"/>	CASE OR JACKET	
<input checked="" type="checkbox"/>	CONFIDENTIAL	*
<input checked="" type="checkbox"/>	SEALED	*
<input checked="" type="checkbox"/>	SCANNED BY	
<input checked="" type="checkbox"/>	DATE SCANNED	
<input checked="" type="checkbox"/>	ROLL	
<input checked="" type="checkbox"/>	FRAME	

Query Options

Show: all documents

☒ Include previous document revisions

Save Options

Query Name:

☐ Available To All Users

Submit Save Reset

Windows taskbar shows the time: 2:55 PM 2/2/2016.

PD1 Records, PD12 RPD Workcards, PD15 Crossroads Traffic Accident

http://moers08web/appxtender/Main.aspx?DataSource=DOCUMENTUM ApplicationXtender Web Access ApplicationXtender Web Access

File Edit View Favorites Tools Help

Convert Select

Google Sites Suggested Sites Free Hotmail 'Spotlight' wins Best

File Edit View Help

Query Criteria for Application 'PD_1' Current Query: New Query

Show	Index Name	Search Value
<input checked="" type="checkbox"/>	CASE OR JACKET	
<input checked="" type="checkbox"/>	CONFIDENTIAL	
<input checked="" type="checkbox"/>	SEALED	
<input checked="" type="checkbox"/>	SCANNED BY	
<input checked="" type="checkbox"/>	DATE SCANNED	
<input checked="" type="checkbox"/>	ROLL	
<input checked="" type="checkbox"/>	FRAME	

Query Options

Show 38 documents

☒ Include previous document revisions

Save Options

Query Name

☐ Available To All Users

Submit Save Reset

2:55 PM 3/2/2010

http://moers08web/appxtender/Main.aspx?DataSource=DOCUMENTUM ApplicationXtender Web Access ApplicationXtender Web Access

File Edit View Favorites Tools Help

Convert Select

Google Sites Suggested Sites Free Hotmail 'Spotlight' wins Best

File Edit View Help

Query Criteria for Application 'PD_1' Current Query: New Query

Show	Index Name	Search Value
<input checked="" type="checkbox"/>	CASE OR JACKET	
<input checked="" type="checkbox"/>	CONFIDENTIAL	
<input checked="" type="checkbox"/>	SEALED	
<input checked="" type="checkbox"/>	SCANNED BY	
<input checked="" type="checkbox"/>	DATE SCANNED	
<input checked="" type="checkbox"/>	ROLL	
<input checked="" type="checkbox"/>	FRAME	

Query Options

Show 38 documents

☒ Include previous document revisions

Save Options

Query Name

☐ Available To All Users

Submit Save Reset

2:56 PM 3/2/2010

ApplicationXtender Application Generator - Documentum - PD_1 Fields

File Import Purge View Tools Help

Application Paths Fields Document Level Security Audit Trail Index Image File

Field Name: Data Type: Length:

Format: User defined list

Flags:

- ☒ Required ☒ Search ☐ Read-Only
- ☐ Doc Level Security ☐ Part of Unique Key ☐ Dual Data Entry
- ☐ Key Reference ☐ Data Reference ☐ Auto Index
- ☐ Validation Mask ☐ Leading Zeros

Add

Application Field Order:

Field Name	Data Type	Field Length	Field Format
CASE OR JACKET	Text	19	
CONFIDENTIAL	User-defined List	23	
SEALED	User-defined List	3	
SCANNED BY	Text	25	

Cancel Apply Help

Ready

NUM

Application Paths	Fields	Document Level Security	Audit Trail	Index Image File
Field Name:		Data Type:		Length:
Format				
Flags:	<input checked="" type="checkbox"/> Required <input checked="" type="checkbox"/> Search <input type="checkbox"/> Read Only <input type="checkbox"/> Doc Level Security <input type="checkbox"/> Part of Unique Key <input type="checkbox"/> Data Entry <input type="checkbox"/> Key Reference <input type="checkbox"/> Data Reference <input type="checkbox"/> Auto Index <input type="checkbox"/> Validation Mask <input type="checkbox"/> Leading Zeros			
Agd	17/04/	1-2770		

Application Field Order			
Field Name	Data Type	Field Length	Field Format
SCANNED BY	Text	25	
DATE SCANNED	Time Stamp	20	yyyy-mm-dd hh:mm
ROLL	Text	8	
FRAME	Text	5	

PD 13 - PDSIG

This screenshot shows a web browser window displaying a form titled "Query Criteria for Application 'PD_13'". The browser's address bar shows the URL "http://moen00web/App/tenet/Main.aspx/DataSources/Documentum". The form includes a "Current Query:" dropdown menu set to "New Query". Under "Query Criteria", there are three rows with checkboxes for "LAST NAME", "FIRST NAME", and "DATE OF BIRTH", each followed by a "Search Value" input field. The "Query Options" section has a "Show:" dropdown set to "all documents" and a checked checkbox for "Include previous document revisions". The "Save Options" section has a "Query Name:" input field and an unchecked checkbox for "Available To All Users". At the bottom right are "Submit", "Save", and "Reset" buttons. The Windows taskbar at the bottom shows the date as 3/2/2016 and the time as 2:59 PM.

Show	Index Name	Search Value
<input checked="" type="checkbox"/>	LAST NAME	
<input checked="" type="checkbox"/>	FIRST NAME	
<input checked="" type="checkbox"/>	DATE OF BIRTH	

Query Options
Show: all documents
☒ Include previous document revisions

Save Options
Query Name:
☐ Available To All Users

Submit Save Reset

PD14 – PD CI

This screenshot shows a web browser window displaying a form titled "Query Criteria for Application 'PD_14'". The browser's address bar shows the URL "http://moen00web/App/tenet/Main.aspx/DataSources/Documentum". The form includes a "Current Query:" dropdown menu set to "New Query". Under "Query Criteria", there are three rows with checkboxes for "LAST NAME", "FIRST NAME", and "CI NUMBER", each followed by a "Search Value" input field. The "Query Options" section has a "Show:" dropdown set to "all documents" and a checked checkbox for "Include previous document revisions". The "Save Options" section has a "Query Name:" input field and an unchecked checkbox for "Available To All Users". At the bottom right are "Submit", "Save", and "Reset" buttons. The Windows taskbar at the bottom shows the date as 3/2/2016 and the time as 2:01 PM.

Show	Index Name	Search Value
<input checked="" type="checkbox"/>	LAST NAME	
<input checked="" type="checkbox"/>	FIRST NAME	
<input checked="" type="checkbox"/>	CI NUMBER	

Query Options
Show: all documents
☒ Include previous document revisions

Save Options
Query Name:
☐ Available To All Users

Submit Save Reset

Application | Paths | Fields | Audit Trail | Index/Image File Setup

Field Name: Data Type: Length:

Format: * [1-10-11-12]

Flags: ☒ Required ☒ Search ☐ Read Only

☐ Doc Level Security ☐ Part of Unique Key ☐ Dual Data Entry

☐ Key Reference ☐ Data Reference ☐ Auto Index

☐ Validation Mask ☐ Leading Zeros

Add

Application Field Order

Field Name	Data Type	Field Length	Field Format
LAST NAME	Text	32	
FIRST NAME	Text	32	
DATE OF BIRTH	Date	10	mm-dd-yyyy

Application | Paths | Fields | Audit Trail | Index Image File Setup

Field Name: Length:

Format: Data Type:

Flags:

☒ Required ☒ Search ☐ Read Only
☐ Doc Level Securt ☐ Part of Unique Key ☐ Dual Data Entry
☐ Key Reference ☐ Data Reference ☐ Auto Index
☐ Validation Mask ☐ Leading Zeros

Application Field Order:

Field Name	Data Type	Field Length	Field Format
LAST NAME	Text	32	
FIRST NAME	Text	32	
CNUMBER	Text	10	

PD16 – False Alarms

Internet Explorer browser window showing the application **moers08web/AppXtender/Main.aspx?DataSource=Documentum**.

ApplicationXtender Web Ac... X

File Edit View Favorites Tools Help

Convert Select

Google Sites Suggested Sites Free Hotmail 'Spotlight' wins Best ...

File Edit View Help

Query Criteria for Application 'PD_16' Current Query: New Query

Show	Index Name	Search Value
<input checked="" type="checkbox"/>	LAST NAME	<input type="text"/>
<input checked="" type="checkbox"/>	FIRST NAME	<input type="text"/>
<input checked="" type="checkbox"/>	ADDRESS	<input type="text"/>
<input checked="" type="checkbox"/>	PERMIT NUMBER	<input type="text"/>
<input checked="" type="checkbox"/>	INCIDENT NUMBER	<input type="text"/>
<input checked="" type="checkbox"/>	REMARKS	<input type="text"/>
<input checked="" type="checkbox"/>	DATE SCANNED	<input type="text"/>
<input checked="" type="checkbox"/>	SCANNED BY	<input type="text"/>
<input checked="" type="checkbox"/>	RESIDENCE	<input type="text"/>
<input checked="" type="checkbox"/>	BUSINESS	<input type="text"/>

Query Options

Show all documents

☒ Include previous document revisions

Save Options

Query Name

☐ Available To All Users

Submit Save Reset

Taskbar: 3:02 PM 3/2/2016

PD16 – False Alarms

Internet Explorer window: <http://moersweb/AppXtender/Main.aspx/DataSources/Documentum> | ApplicationXtender Web Ac... x

File Edit View Favorites Tools Help

Convert Select
Google Sites Suggested Sites Free Hotmail 'Spotlight' wins Best ...

File Edit View Help

Query Criteria for Application 'PD_16' Current Query: New Query v

Show	Index Name	Search Value
<input checked="" type="checkbox"/>	LAST NAME	<input type="text"/>
<input checked="" type="checkbox"/>	FIRST NAME	<input type="text"/>
<input checked="" type="checkbox"/>	ADDRESS	<input type="text"/>
<input checked="" type="checkbox"/>	PERMIT NUMBER	<input type="text"/>
<input checked="" type="checkbox"/>	INCIDENT NUMBER	<input type="text"/>
<input checked="" type="checkbox"/>	REMARKS	<input type="text"/>
<input checked="" type="checkbox"/>	DATE SCANNED	<input type="text"/>
<input checked="" type="checkbox"/>	SCANNED BY	<input type="text"/>
<input checked="" type="checkbox"/>	RESIDENCE	<input type="text"/>
<input checked="" type="checkbox"/>	BUSINESS	<input type="text"/>

Query Options
show: all documents v
☒ Include previous document revisions

Save Options
Query Name:
☐ Available To All Users

Submit Save Reset

Taskbar: 3:03 PM 3/2/2016

Internet Explorer window: <http://moersweb/AppXtender/Main.aspx/DataSources/Documentum> | ApplicationXtender Web Ac... x

File Edit View Favorites Tools Help

Convert Select
Google Sites Suggested Sites Free Hotmail 'Spotlight' wins Best ...

File Edit View Help

Query Criteria for Application 'PD_16' Current Query: New Query v

Show	Index Name	Search Value
<input checked="" type="checkbox"/>	LAST NAME	<input type="text"/>
<input checked="" type="checkbox"/>	FIRST NAME	<input type="text"/>
<input checked="" type="checkbox"/>	ADDRESS	<input type="text"/>
<input checked="" type="checkbox"/>	PERMIT NUMBER	<input type="text"/>
<input checked="" type="checkbox"/>	INCIDENT NUMBER	<input type="text"/>
<input checked="" type="checkbox"/>	REMARKS	<input type="text"/>
<input checked="" type="checkbox"/>	DATE SCANNED	<input type="text"/>
<input checked="" type="checkbox"/>	SCANNED BY	<input type="text"/>
<input checked="" type="checkbox"/>	RESIDENCE	<input type="text"/>
<input checked="" type="checkbox"/>	BUSINESS	<input type="text"/>

Query Options
show: all documents v
☒ Include previous document revisions

Save Options
Query Name:
☐ Available To All Users

Submit Save Reset

Taskbar: 3:03 PM 3/2/2016

Application | Paths | Fields | Audit Trail | Index Image File Setup |

Field Name:

Data Type:

Length:

Format:

Flags:

☒ Required ☒ Search ☐ Read-Only

☐ Doc Level Security ☐ Part of Unique Key ☐ Dual Data Entry

☐ Key Reference ☐ Data Reference ☐ Auto Index

☐ Validation Mask ☐ Leading Zeros

Add

Application Field Order:

Field Name	Data Type	Field Length	Field Format
LAST NAME	Text	128	
FIRST NAME	Text	128	
ADDRESS	Text	128	
PERMIT NUMBER	Text	128	

Field Name

Audit

Help

Application | Paths | Fields | Audit Trail | Index Image File Setup |

Field Name: Data Type: Length:

Format:

Flags:

☒ Required ☒ Search ☐ Read-Only

☐ Doc Level Security ☐ Part of Unique Key ☐ Dual Data Entry

☐ Key Reference ☐ Data Reference ☐ Auto Index

☐ Validation Mask ☐ Leading Zeros

Add

Application Field Order:

Field Name	Data Type	Field Length	Field Format
INCIDENT NUMB.	Text	128	
REMARKS	Text	128	
DATE SCANNED	Time Stamp	20	yyyy-mm-dd hh:mm
SCANNED BY	Text	128	

Cancel Apply Help

Application Paths Audit Trail Index Image File Setup

Field Name:

Data Type:

Length:

Format:

Flags:

- ☒ Required
- ☒ Search
- ☐ Read-Only
- ☐ Doc Level Security
- ☐ Part of Unique Key
- ☐ Dual Data Entry
- ☐ Key Reference
- ☐ Data Reference
- ☐ Auto Index
- ☐ Validation Mask
- ☐ Leading Zeros

Add

Cancel

Apply

Application Field Order:

Field Name	Data Type	Field Length	Field Format
DATE SCANNED	Time Stamp	20	yyyy-mm-dd hh:mm
SCANNED BY	Text	128	
RESIDENCE	Boolean Choice	3	Yes/No
BUSINESS	Boolean Choice	3	Yes/No

Cancel

Apply

Help

PD 3 – Crystal Report

This screenshot shows a web browser window with the URL <http://moen08web/AppXtender/Main.aspx?DataSource=Documentum>. The page title is "Query Criteria for Application 'PD_3'". The "Current Query" dropdown is set to "New Query".

Query Criteria:

Show	Index Name	Search Value
<input checked="" type="checkbox"/>	PERSON DISPLAY/PRINT PD REPORTS	
<input checked="" type="checkbox"/>	CASE/JACKET #	
<input checked="" type="checkbox"/>	START DATE OF REPORT	
<input checked="" type="checkbox"/>	END DATE OF REPORT	
<input checked="" type="checkbox"/>	PERSON RUNNING REPORT	
<input checked="" type="checkbox"/>	REPORT RUN DATE	

Query Options:

Show: [Get Documents](#)

☒ Include previous document revisions

Save Options:

Query Name:

☐ Available To All Users

Buttons:

PD 4 – Mastercards

This screenshot shows a web browser window with the URL <http://moen08web/AppXtender/Main.aspx?DataSource=Documentum>. The page title is "Query Criteria for Application 'PD_4'". The "Current Query" dropdown is set to "New Query".

Query Criteria:

Show	Index Name	Search Value
<input checked="" type="checkbox"/>	LAST NAME	
<input checked="" type="checkbox"/>	FIRST NAME	
<input checked="" type="checkbox"/>	MIDDLE INITIAL	
<input checked="" type="checkbox"/>	DATE OF BIRTH	
<input checked="" type="checkbox"/>	CONFIDENTIAL	*
<input checked="" type="checkbox"/>	CASE OR JACKET	
<input checked="" type="checkbox"/>	SEALED	*
<input checked="" type="checkbox"/>	SCANNED BY	
<input checked="" type="checkbox"/>	DATED SCANNED	

Query Options:

Show: [Get Documents](#)

☒ Include previous document revisions

Save Options:

Query Name:

☐ Available To All Users

Buttons:

ApplicationXtender Application Generator - Documentum - PD_3 Fields

File Import Merge View Tools Help

Application | Paths | Fields | Audit Trail | Index Image File Setup

Field Name: Data Type: Length: Format:

100 characters

Flags:

☒ Required

☐ Doc Level Securit

☐ Part of Unique Key

☐ Dual Data Entry

☐ Key Reference

☐ Data Reference

☐ Auto Index

☐ Validation Mask

☐ Leading Zeros

☒ Search

☐ Read-Only

Add

OK

Cancel

Application Field Order:

Field Name	Data Type	Field Length	Field Format
PERSON DISPLA	Text	128	
CASE/JACKET #	Text	10	
START DATE OF	Date	10	mm-dd-yyyy
END DATE OF R	Date	10	mm-dd-yyyy

Change

Save

Help

Ready

NUM

PD-3 ems41 Reports Page 2

Application | Paths | Fields | Audit Trail | Index Image File Setup |

Field Name: Data Type: Length:

Format: 01/01/2000 12:00:00

Flags:

- ☒ Required ☒ Search ☐ Read Only
- ☐ Doc Level Secure ☐ Part of Unique Key ☐ Dual Data Entry
- ☐ Key Reference ☐ Data Reference ☐ Auto Index
- ☐ Validation Mask ☐ Leading Zeros

Add [Field] [Format]

Application Field Order:

Field Name	Data Type	Field Length	F
END DATE OF REPORT	Date	10	n
PERSON RUNNING REPORT	Text	128	n
REPORT RUNDATE	Date	10	n

OK Cancel Apply Help

Application | Paths | Fields | Audit Trail | Index Image File Setup

Field Name: Data Type: Length:

Format:

Flags: ☒ Required ☒ Search ☐ Read Only ☐ Doc Level Security ☐ Part of Unique Key ☐ Dual Data Entry ☐ Key Reference ☐ Data Reference ☐ Auto Index ☐ Validation Mask ☐ Leading Zeros

Application Field Order:

Field Name	Data Type	Field Length	F
LAST NAME	Text	128	
FIRST NAME	Text	128	
MIDDLE INITIAL	Text	128	

Application Paths		Fields Audit Trail Index Image File Setup		Length	
Field Name:		Data Type:			
Format					
Flags:					
<input checked="" type="checkbox"/> Required <input checked="" type="checkbox"/> Search <input type="checkbox"/> Read Only <input type="checkbox"/> Doc Level Securt <input type="checkbox"/> Part of Unique Key <input type="checkbox"/> Dual Data Entry <input type="checkbox"/> Key Reference <input type="checkbox"/> Data Reference <input type="checkbox"/> Auto Index <input type="checkbox"/> Validation Mask <input type="checkbox"/> Leading Zeros					
Add		Insert Delete			
Application Field Order					
Field Name	Data Type	Field Length			
DATE OF BIRTH	Date	10			
CONFIDENTIAL	User-defined List	23			
CASE OR JACKET	Text	10			

PD-4 master cards page 3

ApplicationXtender Application Generator - Documentum - PD_4 Fields

File Import Merge View Tools Help

Application Paths Fields Audit Trail Index Image File Setup

Field Name: Data Type: Length

Format: [v] [v] [v]

Flags:

- ☒ Required ☒ Search ☐ Read-Only
- ☐ Doc Level Security ☐ Part of Unique Key ☐ Dual Data Entry
- ☐ Key Reference ☐ Data Reference ☐ Auto Index
- ☐ Validation Mask ☐ Leading Zeros

Add [v] [v] [v]

Application Field Order:

Field Name	Data Type	Field Length	F
SEALED	Boolean Choice	3	Y
SCANNED BY	Text	15	
DATED SCANNED	Date	10	

Device [v] [v] [v]

Help

NUM

PD5 – Dispositions

The screenshot shows a web browser window with the URL `http://moen08web/AppXtender/Main.aspx?DataSource=Documentum`. The page title is "ApplicationXtender Web Ac...". The browser's address bar shows the URL. The page content is titled "Query Criteria for Application 'PD_5'" and includes a "Current Query:" dropdown menu set to "New Query".

Query Criteria for Application 'PD_5'

Show Index Name

Index Name	Search Value
<input checked="" type="checkbox"/> CASE OR JACKET	<input type="text"/>
<input checked="" type="checkbox"/> SCANNED BY	<input type="text"/>
<input checked="" type="checkbox"/> DATE SCANNED	<input type="text"/>

Query Options

Show: ☒ Include previous document revisions

Save Options

Query Name:

☐ Available To All Users

Submit Save Reset

PD6 - High Desert

The screenshot shows a web browser window with the URL `http://moen08web/AppXtender/Main.aspx?DataSource=Documentum`. The page title is "ApplicationXtender Web Ac...". The page content is titled "Query Criteria for Application 'PD_6'" and includes a "Current Query:" dropdown menu set to "New Query".

Query Criteria for Application 'PD_6'

Show Index Name

Index Name	Search Value
<input checked="" type="checkbox"/> CASE OR JACKET	<input type="text"/>
<input checked="" type="checkbox"/> DATE SCANNED	<input type="text"/>

Query Options

Show: ☒ Include previous document revisions

Save Options

Query Name:

☐ Available To All Users

Submit Save Reset

PD 7 – ROP

http://miers01web/App/Tender/Main.aspx?DataSource=Documents Application/Tender Web Ac...

File Edit View Favorites Tools Help

Convert Select Google Sites Suggested Sites Free Hotmail 'Spotlight' wins Best ...

File Edit View Help

Query Criteria for Application 'PD_7' Current Query: New Query

Show	Index Name	Search Value
<input checked="" type="checkbox"/>	LAST NAME	
<input checked="" type="checkbox"/>	FIRST NAME	
<input checked="" type="checkbox"/>	MIDDLE NAME	
<input checked="" type="checkbox"/>	SCANNED BY	
<input checked="" type="checkbox"/>	DATE SCANNED	

Query Options

Show All Documents

☒ Include previous document revisions

Save Options

Query Name

☐ Available To All Users

Submit Save Reset

3:11 PM 3/2/2016

PD 8 - Locked Files, PD10 – RPD Sealings

http://miers01web/App/Tender/Main.aspx?DataSource=Documents Application/Tender Web Ac...

File Edit View Favorites Tools Help

Convert Select Google Sites Suggested Sites Free Hotmail 'Spotlight' wins Best ...

File Edit View Help

Query Criteria for Application 'PD_10' Current Query: New Query

Show	Index Name	Search Value
<input checked="" type="checkbox"/>	CASE OR JACKET	
<input checked="" type="checkbox"/>	DATE SEALED	

Query Options

Show All Documents

☒ Include previous document revisions

Save Options

Query Name

☐ Available To All Users

Submit Save Reset

2:57 PM 3/2/2016

PD 11 - NCIC

http://moen0web/AppXtender/Main.aspx/DataSources/Documentum ApplicationXtender Web Ac... X

File Edit View Favorites Tools Help

Convert Select

Google Sites Suggested Sites Free Hotmail 'Spotlight' wins Best ...

File Edit View Help

Query Criteria for Application 'PD_11' Current Query: New Query

Show	Index Name	Search Value
<input checked="" type="checkbox"/>	LAST NAME	
<input checked="" type="checkbox"/>	FIRST NAME	
<input checked="" type="checkbox"/>	MIDDLE NAME	
<input checked="" type="checkbox"/>	SSN	
<input checked="" type="checkbox"/>	BADGE NUMBER	
<input checked="" type="checkbox"/>	SCANNED BY	
<input checked="" type="checkbox"/>	DATE SCANNED	

Query Options

Show

☒ Include previous document revisions

Save Options

Query Name

☐ Available To All Users

Submit Save Reset

2:58 PM 3/2/2016

PD9 – FTP Request

http://moen0web/AppXtender/Main.aspx/DataSources/Documentum ApplicationXtender Web Ac... X

File Edit View Favorites Tools Help

Convert Select

Google Sites Suggested Sites Free Hotmail 'Spotlight' wins Best ...

File Edit View Help

Query Criteria for Application 'PD_9' Current Query: New Query

Show	Index Name	Search Value
<input checked="" type="checkbox"/>	CASE OR JACKET	
<input checked="" type="checkbox"/>	DATE SCANNED	

Query Options

Show

☒ Include previous document revisions

Save Options

Query Name

☐ Available To All Users

Submit Save Reset

3:31 PM 3/2/2016

PO-5 Depository

ApplicationXtender Application Generator - Documentum - PD_5 Fields

File Import Purge View Tools Help

Application | Paths | Fields | Audit Trail | Index Image File Setup

Field Name: Data Type: Length: 5

Format: Show Details

Flags:

- ☒ Required ☒ Search ☐ Read-Only
- ☐ Doc Level Secure ☐ Part of Unique Key ☐ Dual Data Entry
- ☐ Key Reference ☐ Data Reference ☐ Auto Index
- ☐ Validation Mask ☐ Leading Zeros

Add Project Library

Application Field Order

Field Name	Data Type	Field Length	Field
CASE OR JACKET	Text	10	
SCANNED BY	Text	15	
DATE SCANNED	Date	10	mm-k

Cancel Apply Help

NUM

PO-6- High Desert

Application | Paths | Fields | Audit Trail | Index Image File Setup

Field Name: Data Type: Length:

Format: View Sample Data

Flags: ☒ Required ☒ Search ☐ Read Only

☐ Doc Level Security ☐ Part of Unique Key ☐ Dual Data Entry

☐ Key Reference ☐ Data Reference ☐ Auto Index

☐ Validation Mask ☐ Leading Zeros

Add

Insert

Delete

Up

Down

Reset

Cancel

OK

Apply

Help

Close

Cancel

OK

Apply

Help

Close

Cancel

OK

ApplicationXtender Application Generator - Documentum - PD 7 fields

File Import Runge View Tools Help

Application Paths Fields Audit Trail Index Image File Setup

Field Name: Data Type: Length:

Format: [dropdown] [dropdown]

Flags:

- ☒ Required ☒ Search ☐ Read Only
- ☐ Doc Level Securt ☐ Part of Unique Key ☐ Dual Data Entry
- ☐ Key Reference ☐ Data Reference ☐ Auto Index
- ☐ Validation Mask ☐ Leading Zeros

Add [button] [button] [button]

Application Field Order:

Field Name	Data Type	Field Length	F
LAST NAME	Text	32	
FIRST NAME	Text	32	
MIDDLE NAME	Text	32	

[button] [button] [button] [button]

Ready

NUM

PO-8 and 10
lockfiles and RPO sealings

ApplicationXtender Application Generator - Documentum - PD_8 Fields

File Import Purge View Tools Help

Application | Paths | Fields | Audit Trail | Index Image File Setup

Field Name: Data Type: Length:

Format: [dropdown] [dropdown]

Flags:

- ☒ Required ☒ Search ☐ Read-Only
- ☐ Doc Level Secure ☐ Part of Unique Key ☐ Dual Data Entry
- ☐ Key Reference ☐ Data Reference ☐ Auto Index
- ☐ Validation Mask ☐ Leading Zeros

Add [button] [button]

Application Field Order:

Field Name	Data Type	Field Length	Field
CASE OR JACKET	Text	15	
DATE SEALED	Date	10	mm<

[button] [button] [button]

Save Apply Help

Red Windows Media Player

NUM

PD-11 NCRC - Page 1

Application | Paths | Fields | Audit Trail | Index Image File Setup

Field Name: Data Type: Length:

Format:

Flags: ☒ Required ☒ Search ☐ Read-Only

☐ Doc Level Security ☐ Part of Unique Key ☐ Dual Data Entry

☐ Key Reference ☐ Data Reference ☐ Auto Index

☐ Validation Mask ☐ Leading Zeros

Application Field Order:

Field Name	Data Type	Field Length	F
LAST NAME	Text	32	E
FIRST NAME	Text	32	
MIDDLE NAME	Text	32	

PD-11 NCRC - Page 2

Application | Paths | Fields | Audit Trail | Index Image File Setup |

Field Name: Data Type: Length:

Format:

Flags:

☒ Required ☒ Search ☐ Read Only

☐ Doc Level Securt ☐ Part of Unique Key ☐ Dual Data Entry

☐ Key Reference ☐ Data Reference ☐ Auto Index

☐ Validation Mask ☐ Leading Zeros

Application Field Order:

Field Name	Data Type	Field Length	F
SSN	SSN	11	m
BADGE NUMBER	Text	32	
SCANNED BY	Text	25	

PD-11 NCDE-Page 3

ApplicationXtender Application Generator - Documentum - PD_11 Fields

File Import Merge View Tools Help

Application | Paths | Fields | Audit Trail | Index Image | File Setup |

Field Name: Data Type: Length:

Format: [v] [v] [v]

Flags:

- ☒ Required
- ☒ Search
- ☐ Read Only
- ☐ Doc Level Security
- ☐ Part of Unique Key
- ☐ Dual Data Entry
- ☐ Key Reference
- ☐ Data Reference
- ☐ Auto Index
- ☐ Validation Mask
- ☐ Leading Zeros

Add [v] [v] [v]

Application Field Order:

Field Name	Data Type	Field Length	f
BADGE NUMBER	Text	32	
SCANNED BY	Text	25	
DATE SCANNED	Date	10	

Cancel Apply Help

NUM

PD-9- FTPR-guest

ApplicationXtender Application Generator - Documentum - PD_9 Fields

File Import Purge View Tools Help



Application | Paths | Fields | Audit Trail | Index Image File Setup

Field Name: Data Type: Length:

Format: [dropdown] [dropdown]

Flags: ☒ Required ☒ Search ☐ Read-Only

☐ Doc Level Secure ☐ Part of Unique Key ☐ Dual Data Entry

☐ Key Reference ☐ Data Reference ☐ Auto Index

☐ Validation Mask ☐ Leading Zeros

Add [mask] [length]

Application Field Order:

Field Name	Data Type	Field Length	Field Format
CASE OR JACKET	Text	19	
DATE SCANNED	Time Stamp	20	yyyy-mm-dd hh:mm:ss

Format Apply Help

Ready

NUM